
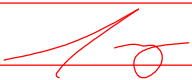



CERTIFIED BY: 
 RPEQ No.: 13201 (Allister Haynes)
 DATE: 2 / 6 / 21


This drawing is an accurate representation of the works as-constructed. All the locations and levels shown on this plan have been provided by a Surveyor as defined in the Surveyors Act 2003. I hereby accept responsibility for the as-constructed information shown on this plan.

0 20 40 60m Scale 1:2000 @A3

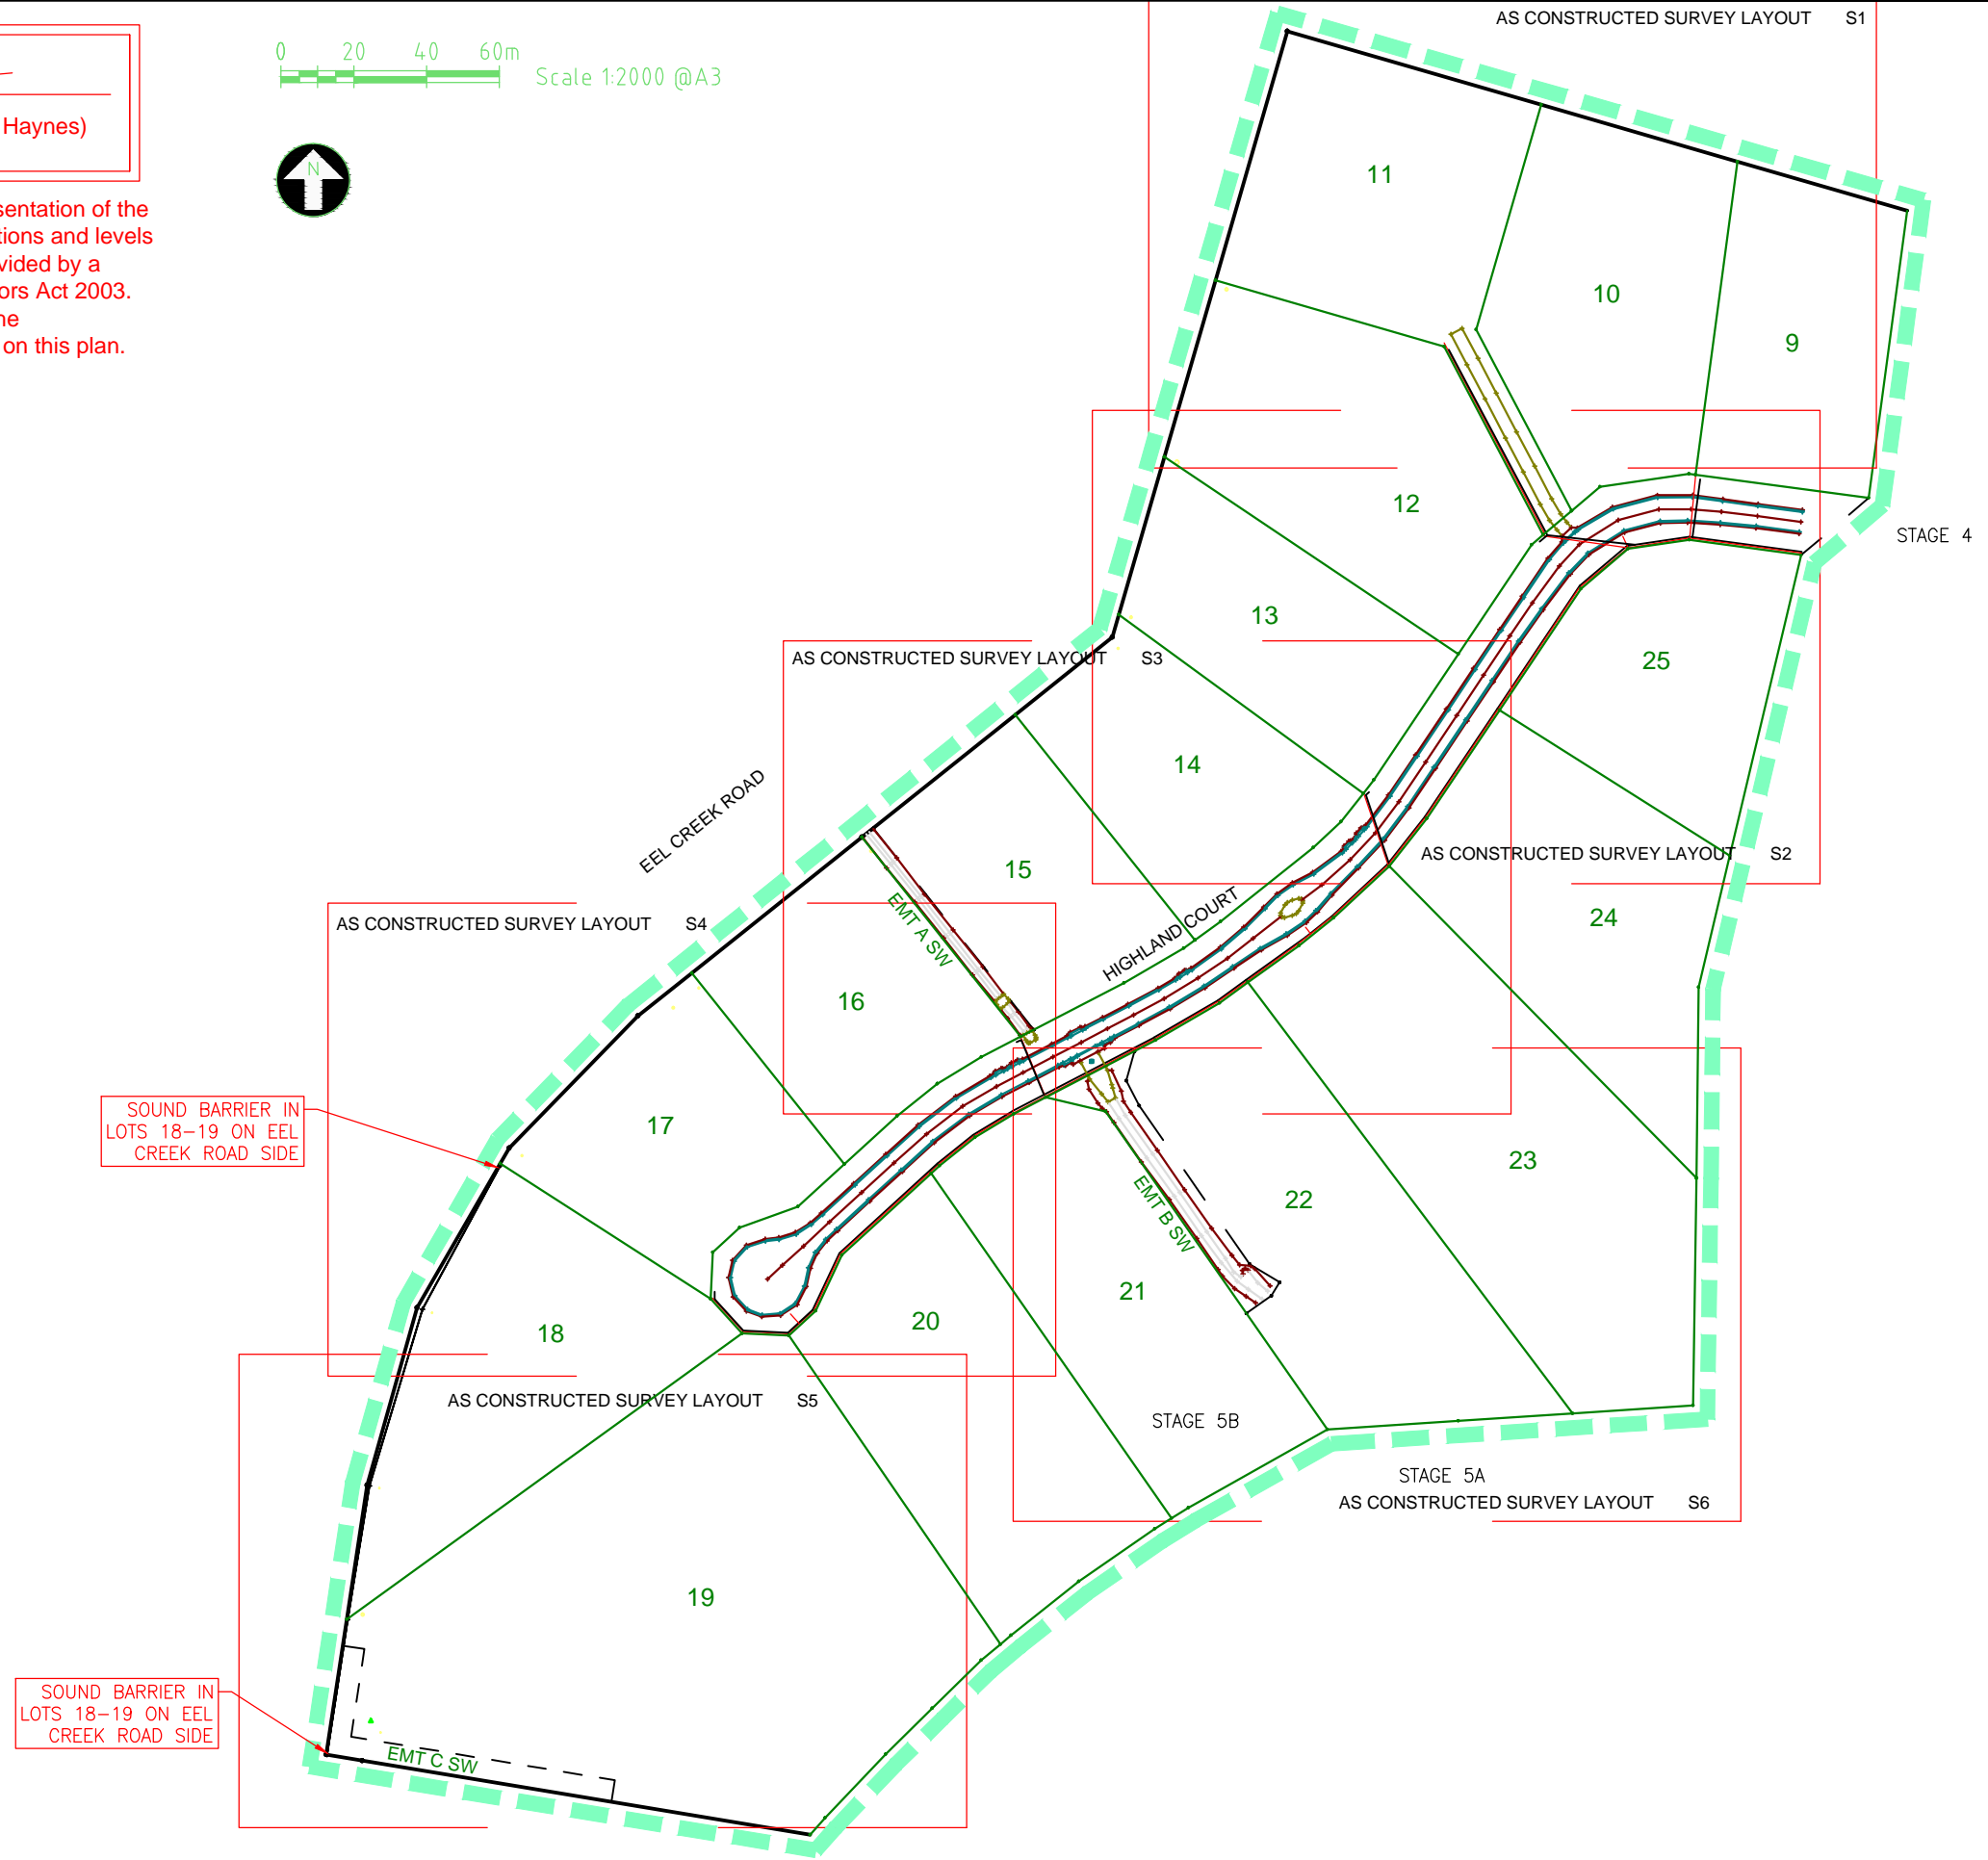

A3	0	2-6-21	AS CONSTRUCTED	ATH	PSM No	OPM 196354		HAYNES CONSULTING ENGINEERS ABN 53 613 630 078 PO BOX 549 NOOSA HEADS QLD 4567 (0432) 784 150	GREENDALE DOWNS STAGE 5B Lots 9-25 on SP323061 Surveyed by Murray and Associates Pty Ltd AS CONSTRUCTED SURVEY LAYOUTS	1803
	Rv	DATE	REVISIONS	APPR.	(AHD) RL	82.215				Sheet No. - Revision No.
					SURVEYED	Murray & Assoc. Pty Ltd				

LEGEND:

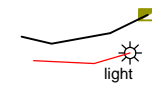

TELSTRA PIT, LIGHTS AND CROSSING MARKERS PICKED UP BY SURVEY, SERVICE CONDUIT LOCATION IS APPROXIMATE AND ALL FUTURE WORKS MUST HAVE SERVICES IDENTIFIED BY ACCREDITED SERVICES LOCATOR.




AS-CONSTRUCTED CONTOURS AT 0.5m INTERVALS





EXISTING OPTIC FIBRE, SERVICE CONDUIT LOCATION AND DEPTH RL IS APPROXIMATE AND ALL FUTURE WORKS MUST HAVE SERVICES IDENTIFIED BY ACCREDITED SERVICES LOCATOR BY VACUUM EXCAVATION.



NEW STORMWATER PIPE

CERTIFIED BY: 
RPEQ No.: 13201 (Allister Haynes)
DATE: 2 / 6 / 21

This drawing is an accurate representation of the works as-constructed. All the locations and levels shown on this plan have been provided by a Surveyor as defined in the Surveyors Act 2003. I hereby accept responsibility for the as-constructed information shown on this plan.

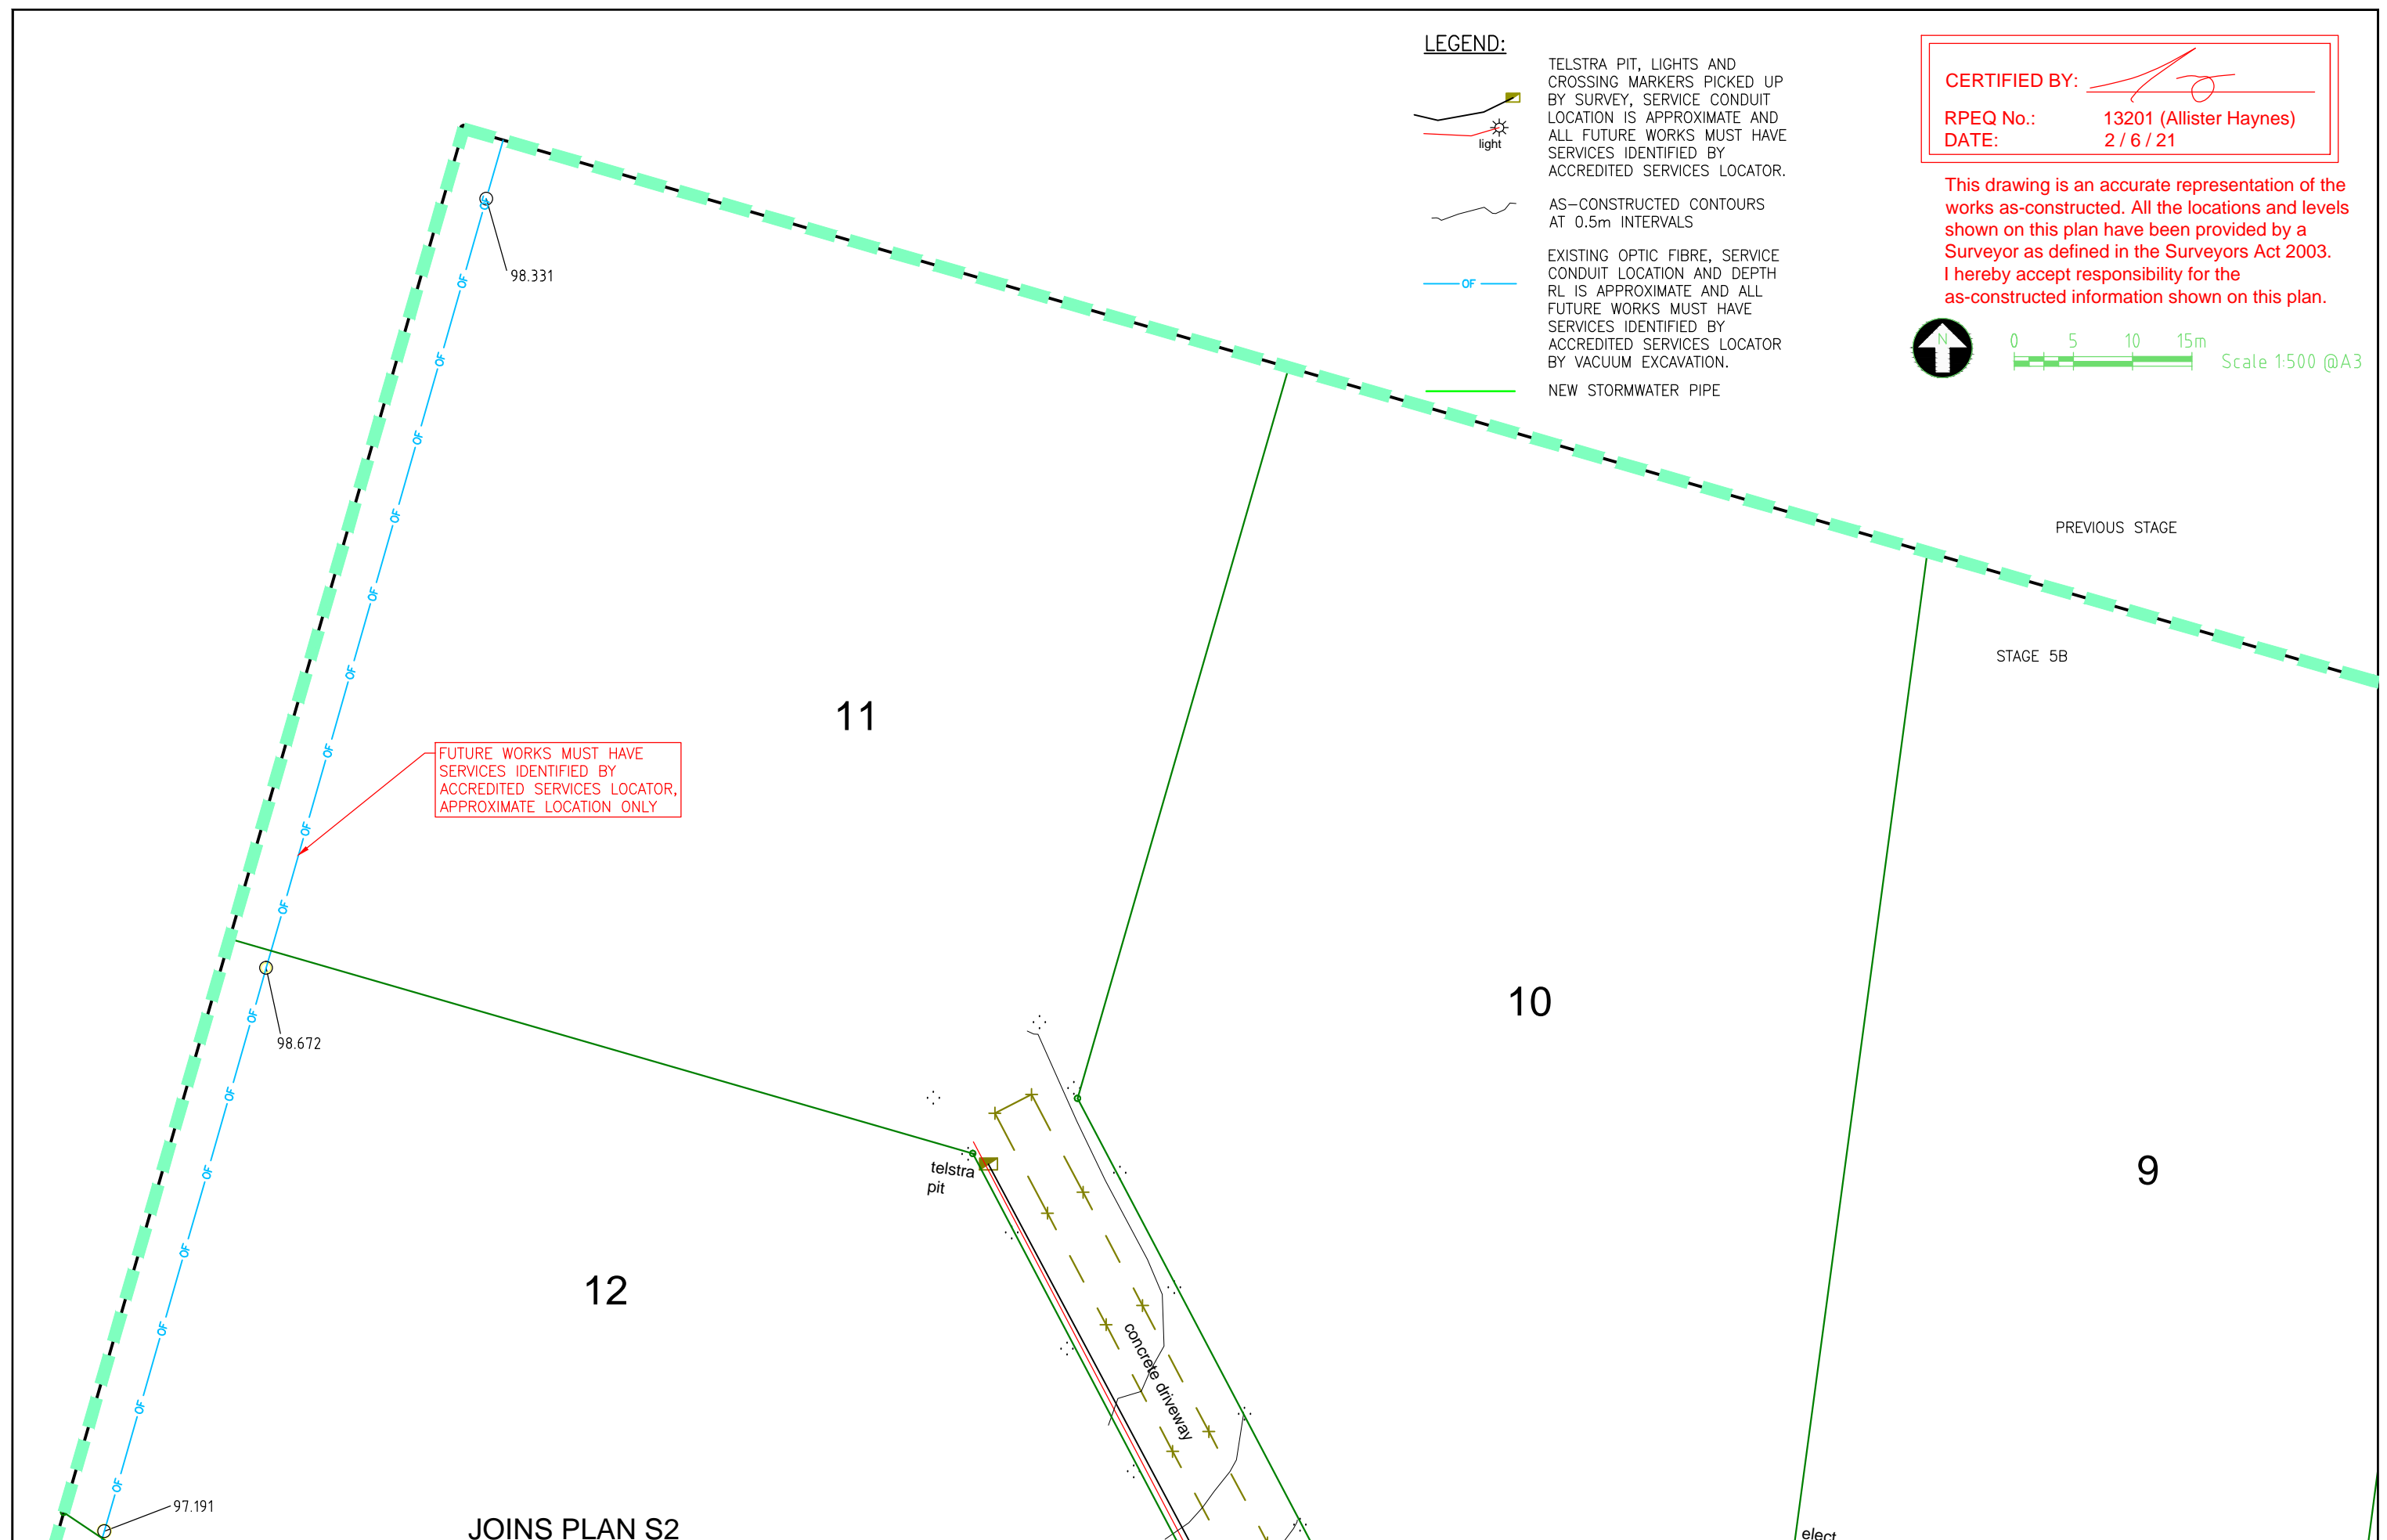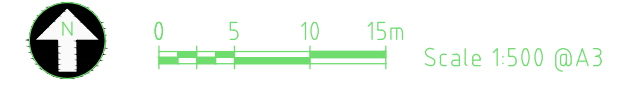

A3

0	2-6-21	AS CONSTRUCTED	ATH
Rv	DATE	REVISIONS	APPR.

JOINS PLAN S2


PSM No	OPM 196354
(AHD) RL	82.215
SURVEYED	Murray & Assoc. Pty Ltd




HAYNES CONSULTING ENGINEERS
 ABN 53 613 630 078
 PO BOX 549 NOOSA HEADS QLD 4567
 (0432) 784 150

GREENDALE DOWNS STAGE 5B
 Lots 9-25 on SP323061
 Surveyed by Murray and Associates Pty Ltd
AS CONSTRUCTED SURVEY LAYOUTS



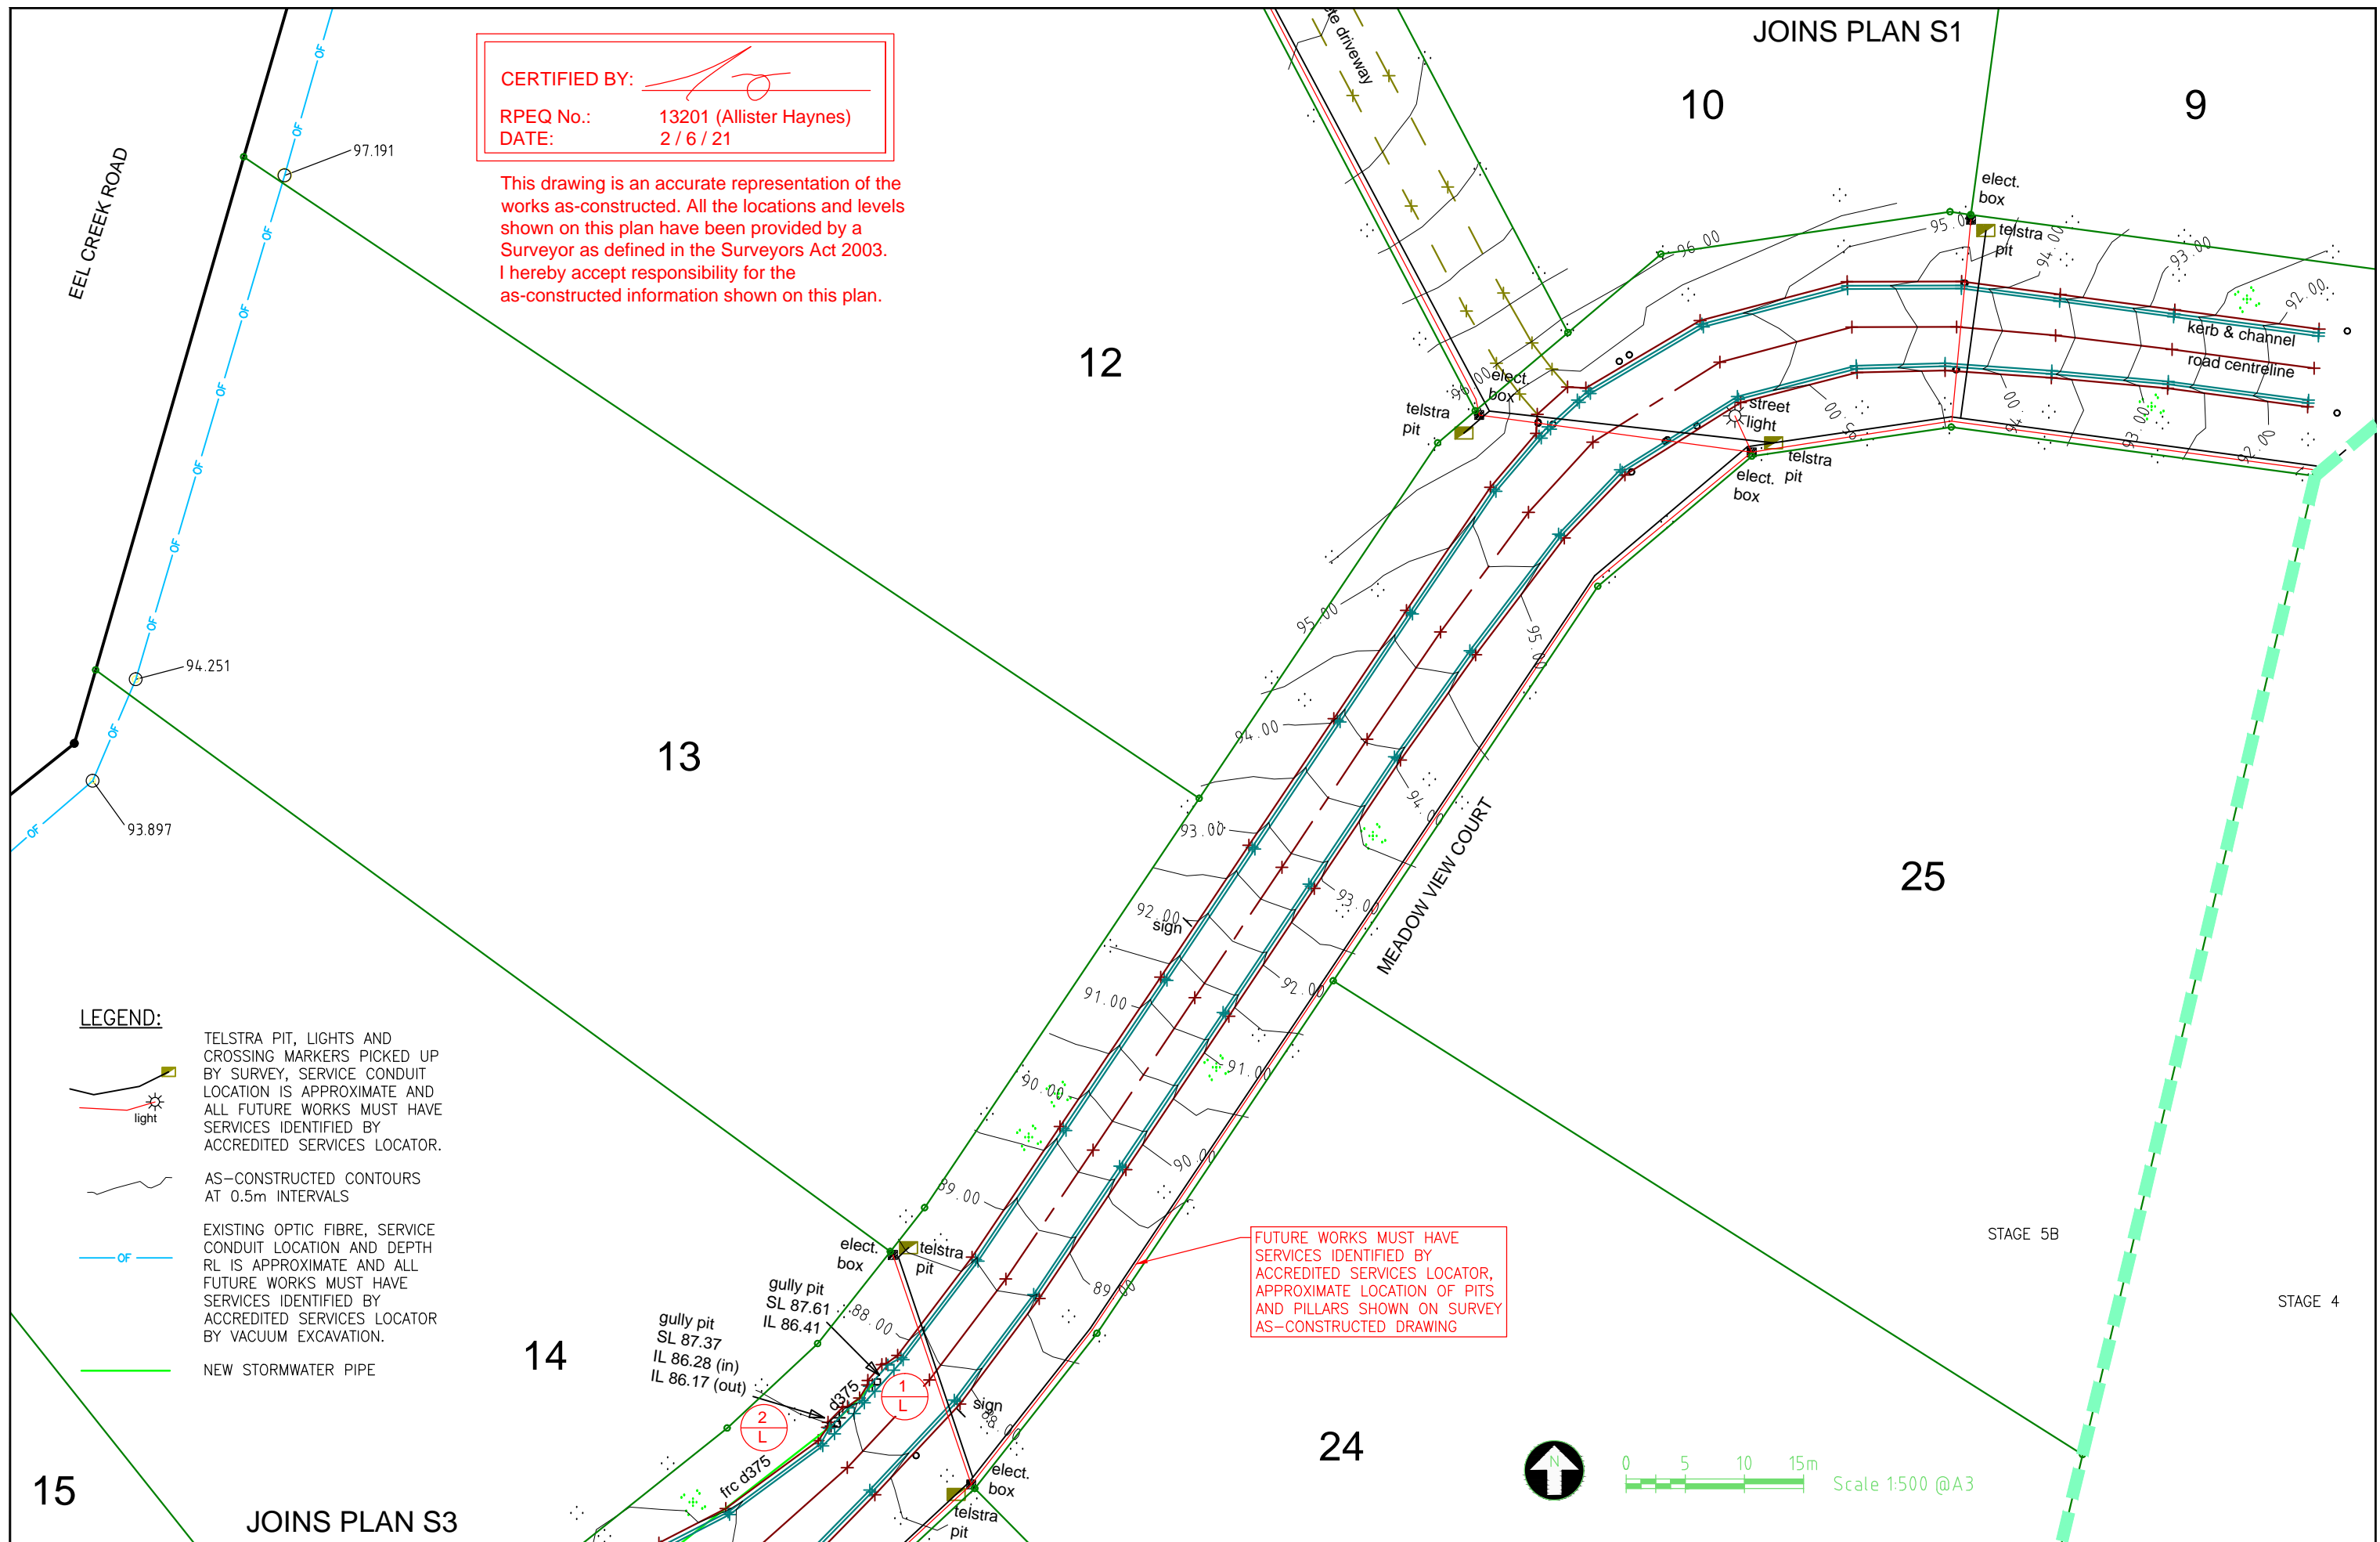


1803
Sheet No. - Revision No.
S5B-S1 0



CERTIFIED BY: 
RPEQ No.: 13201 (Allister Haynes)
DATE: 2 / 6 / 21

This drawing is an accurate representation of the works as-constructed. All the locations and levels shown on this plan have been provided by a Surveyor as defined in the Surveyors Act 2003. I hereby accept responsibility for the as-constructed information shown on this plan.

FUTURE WORKS MUST HAVE SERVICES IDENTIFIED BY ACCREDITED SERVICES LOCATOR, APPROXIMATE LOCATION OF PITS AND PILLARS SHOWN ON SURVEY AS-CONSTRUCTED DRAWING

- LEGEND:**
-  TELSTRA PIT, LIGHTS AND CROSSING MARKERS PICKED UP BY SURVEY, SERVICE CONDUIT LOCATION IS APPROXIMATE AND ALL FUTURE WORKS MUST HAVE SERVICES IDENTIFIED BY ACCREDITED SERVICES LOCATOR.
 -  light
 -  AS-CONSTRUCTED CONTOURS AT 0.5m INTERVALS
 -  EXISTING OPTIC FIBRE, SERVICE CONDUIT LOCATION AND DEPTH RL IS APPROXIMATE AND ALL FUTURE WORKS MUST HAVE SERVICES IDENTIFIED BY ACCREDITED SERVICES LOCATOR BY VACUUM EXCAVATION.
 -  NEW STORMWATER PIPE

A3	0	2-6-21	AS CONSTRUCTED	ATH
	Rv	DATE	REVISIONS	APPR.


PSM No	OPM 196354
(AHD) RL	82.215
SURVEYED	Murray & Assoc. Pty Ltd





HAYNES CONSULTING ENGINEERS
 ABN 53 613 630 078
 PO BOX 549 NOOSA HEADS QLD 4567
 (0432) 784 150

GREENDALE DOWNS STAGE 5B
 Lots 9-25 on SP323061
 Surveyed by Murray and Associates Pty Ltd
AS CONSTRUCTED SURVEY LAYOUTS





1803
Sheet No. - Revision No.
S5B-S2 0

CERTIFIED BY: 
 RPEQ No.: 13201 (Allister Haynes)
 DATE: 2 / 6 / 21

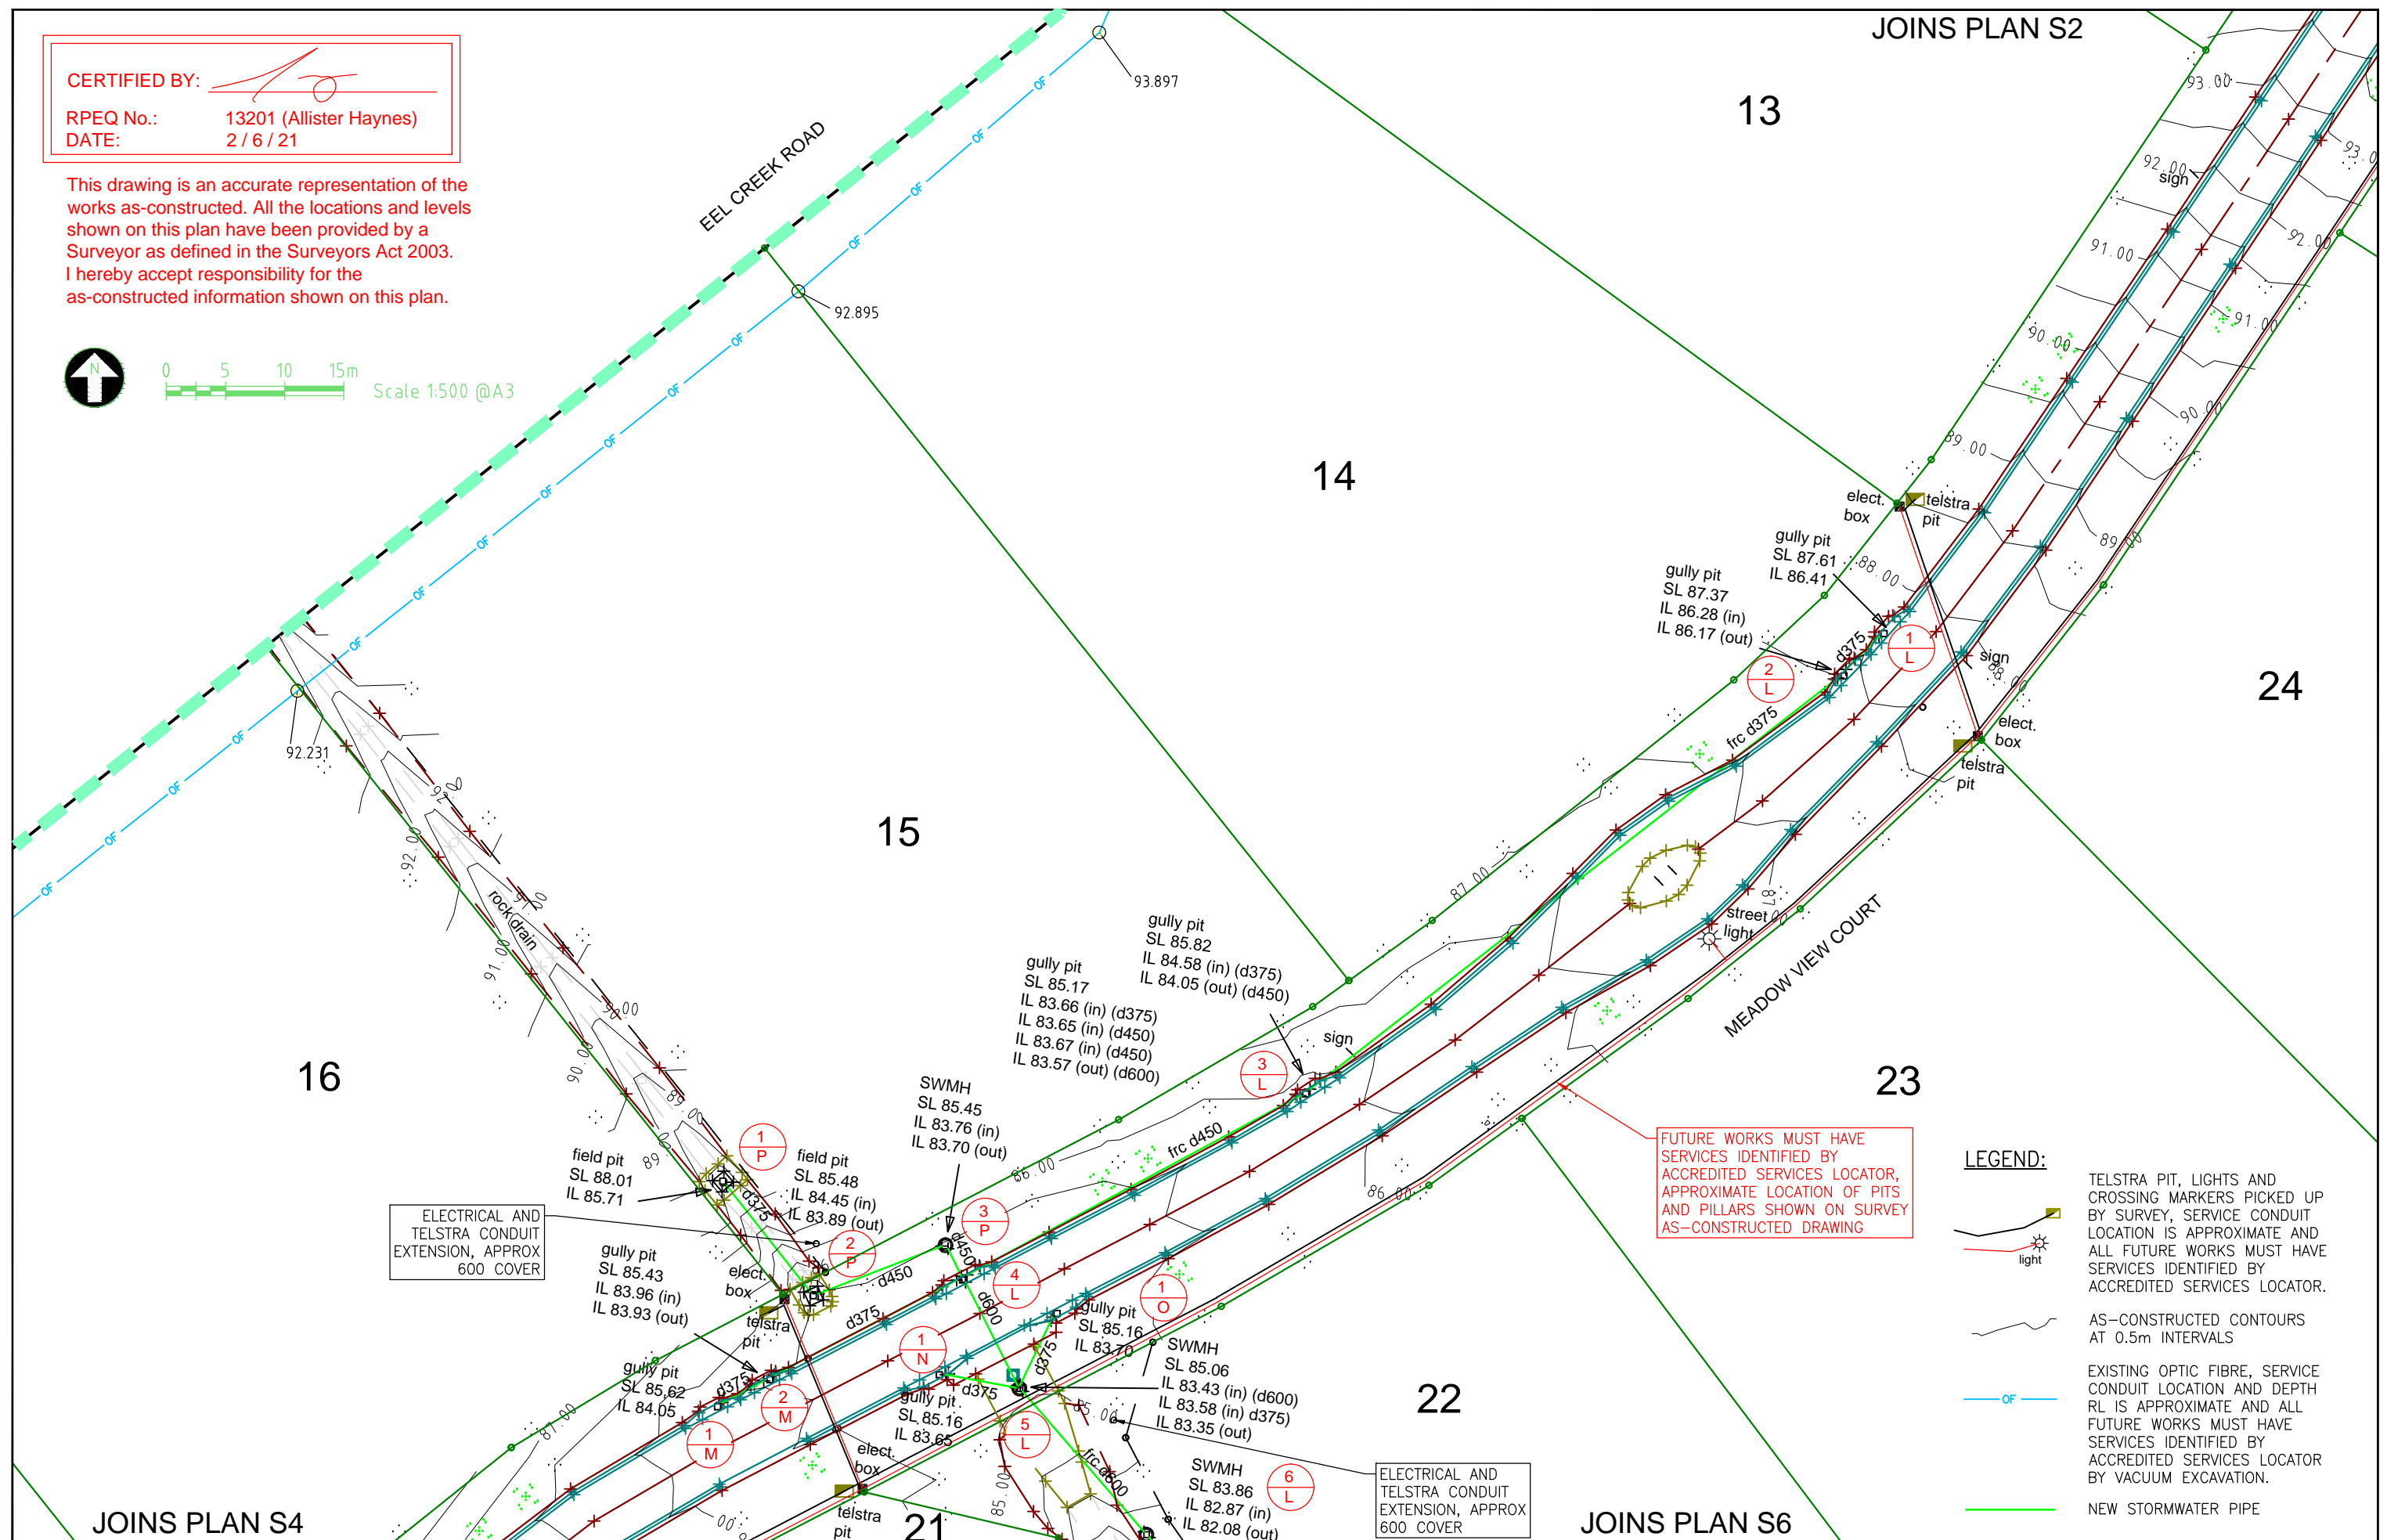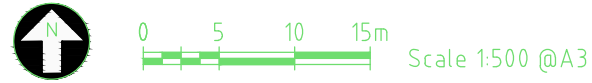This drawing is an accurate representation of the works as-constructed. All the locations and levels shown on this plan have been provided by a Surveyor as defined in the Surveyors Act 2003. I hereby accept responsibility for the as-constructed information shown on this plan.



FUTURE WORKS MUST HAVE SERVICES IDENTIFIED BY ACCREDITED SERVICES LOCATOR, APPROXIMATE LOCATION OF PITS AND PILLARS SHOWN ON SURVEY AS-CONSTRUCTED DRAWING

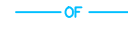- LEGEND:**
-  TELSTRA PIT, LIGHTS AND CROSSING MARKERS PICKED UP BY SURVEY, SERVICE CONDUIT LOCATION IS APPROXIMATE AND ALL FUTURE WORKS MUST HAVE SERVICES IDENTIFIED BY ACCREDITED SERVICES LOCATOR.
 -  AS-CONSTRUCTED CONTOURS AT 0.5m INTERVALS
 -  EXISTING OPTIC FIBRE, SERVICE CONDUIT LOCATION AND DEPTH RL IS APPROXIMATE AND ALL FUTURE WORKS MUST HAVE SERVICES IDENTIFIED BY ACCREDITED SERVICES LOCATOR BY VACUUM EXCAVATION.
 -  NEW STORMWATER PIPE


A3	0	2-6-21	AS CONSTRUCTED	ATH
	Rv	DATE	REVISIONS	APPR.

PSM No	OPM 196354
(AHD) RL	82.215
SURVEYED	Murray & Assoc. Pty Ltd






HAYNES CONSULTING ENGINEERS
 ABN 53 613 630 078
 PO BOX 549 NOOSA HEADS QLD 4567
 (0432) 784 150



GREENDALE DOWNS STAGE 5B
 Lots 9-25 on SP323061
 Surveyed by Murray and Associates Pty Ltd
AS CONSTRUCTED SURVEY LAYOUTS

1803
Sheet No. - Revision No.
S5B-S3 0

CERTIFIED BY: 
RPEQ No.: 13201 (Allister Haynes)
DATE: 2 / 6 / 21

This drawing is an accurate representation of the works as-constructed. All the locations and levels shown on this plan have been provided by a Surveyor as defined in the Surveyors Act 2003. I hereby accept responsibility for the as-constructed information shown on this plan.

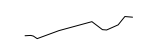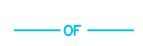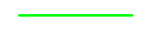- LEGEND:**
-  TELSTRA PIT, LIGHTS AND CROSSING MARKERS PICKED UP BY SURVEY, SERVICE CONDUIT LOCATION IS APPROXIMATE AND ALL FUTURE WORKS MUST HAVE SERVICES IDENTIFIED BY ACCREDITED SERVICES LOCATOR.
 -  LIGHT
 -  AS-CONSTRUCTED CONTOURS AT 0.5m INTERVALS
 -  EXISTING OPTIC FIBRE, SERVICE CONDUIT LOCATION AND DEPTH RL IS APPROXIMATE AND ALL FUTURE WORKS MUST HAVE SERVICES IDENTIFIED BY ACCREDITED SERVICES LOCATOR BY VACUUM EXCAVATION.
 -  NEW STORMWATER PIPE

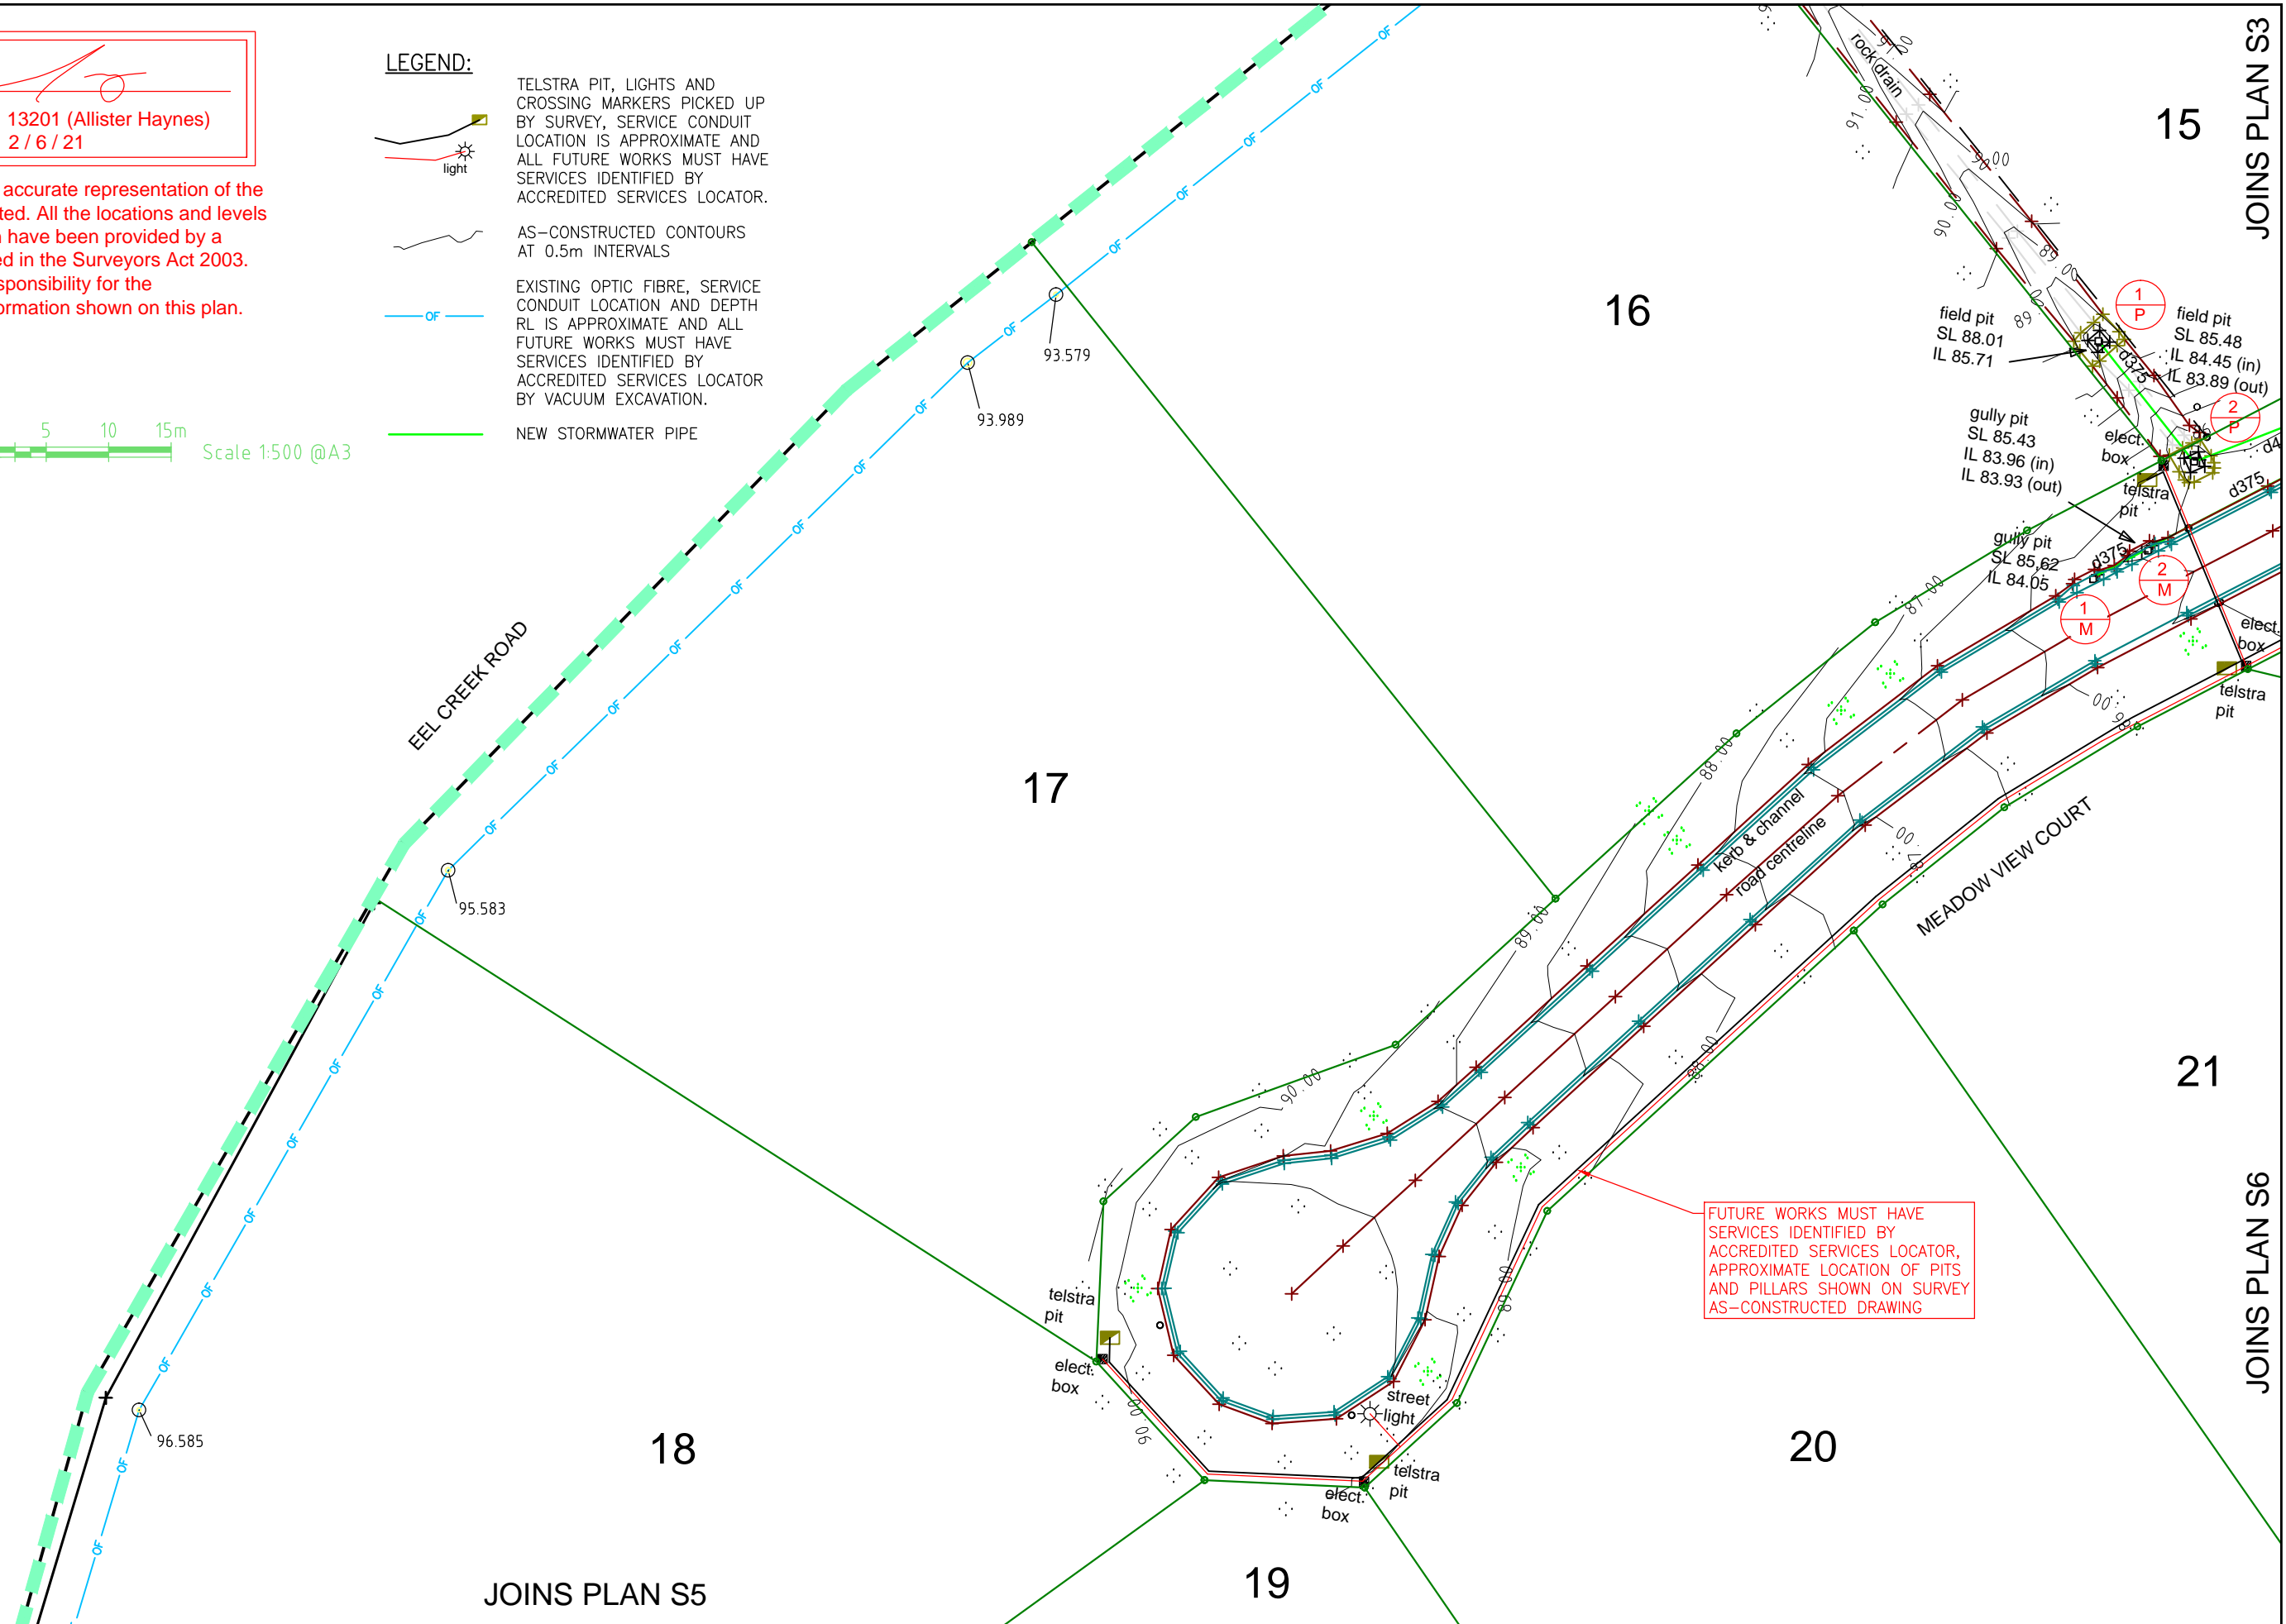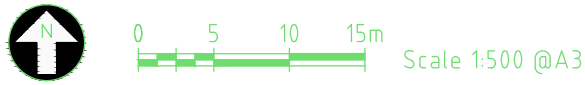

A3

0	2-6-21	AS CONSTRUCTED	ATH
Rv	DATE	REVISIONS	APPR.

PSM No	OPM 196354
(AHD) RL	82.215
SURVEYED	Murray & Assoc. Pty Ltd



HAYNES CONSULTING ENGINEERS
 ABN 53 613 630 078
 PO BOX 549 NOOSA HEADS QLD 4567
 (0432) 784 150


GREENDALE DOWNS STAGE 5B
 Lots 9-25 on SP323061
 Surveyed by Murray and Associates Pty Ltd
AS CONSTRUCTED SURVEY LAYOUTS

1803
 Sheet No. - Revision No.
S5B-S4 0






18

20


19

CERTIFIED BY: 
 RPEQ No.: 13201 (Allister Haynes)
 DATE: 2 / 6 / 21

This drawing is an accurate representation of the works as-constructed. All the locations and levels shown on this plan have been provided by a Surveyor as defined in the Surveyors Act 2003. I hereby accept responsibility for the as-constructed information shown on this plan.

- LEGEND:**
-  TELSTRA PIT, LIGHTS AND CROSSING MARKERS PICKED UP BY SURVEY, SERVICE CONDUIT LOCATION IS APPROXIMATE AND ALL FUTURE WORKS MUST HAVE SERVICES IDENTIFIED BY ACCREDITED SERVICES LOCATOR.
 -  light
 -  AS-CONSTRUCTED CONTOURS AT 0.5m INTERVALS
 -  EXISTING OPTIC FIBRE, SERVICE CONDUIT LOCATION AND DEPTH RL IS APPROXIMATE AND ALL FUTURE WORKS MUST HAVE SERVICES IDENTIFIED BY ACCREDITED SERVICES LOCATOR BY VACUUM EXCAVATION.
 -  NEW STORMWATER PIPE

EEL CREEK ROAD

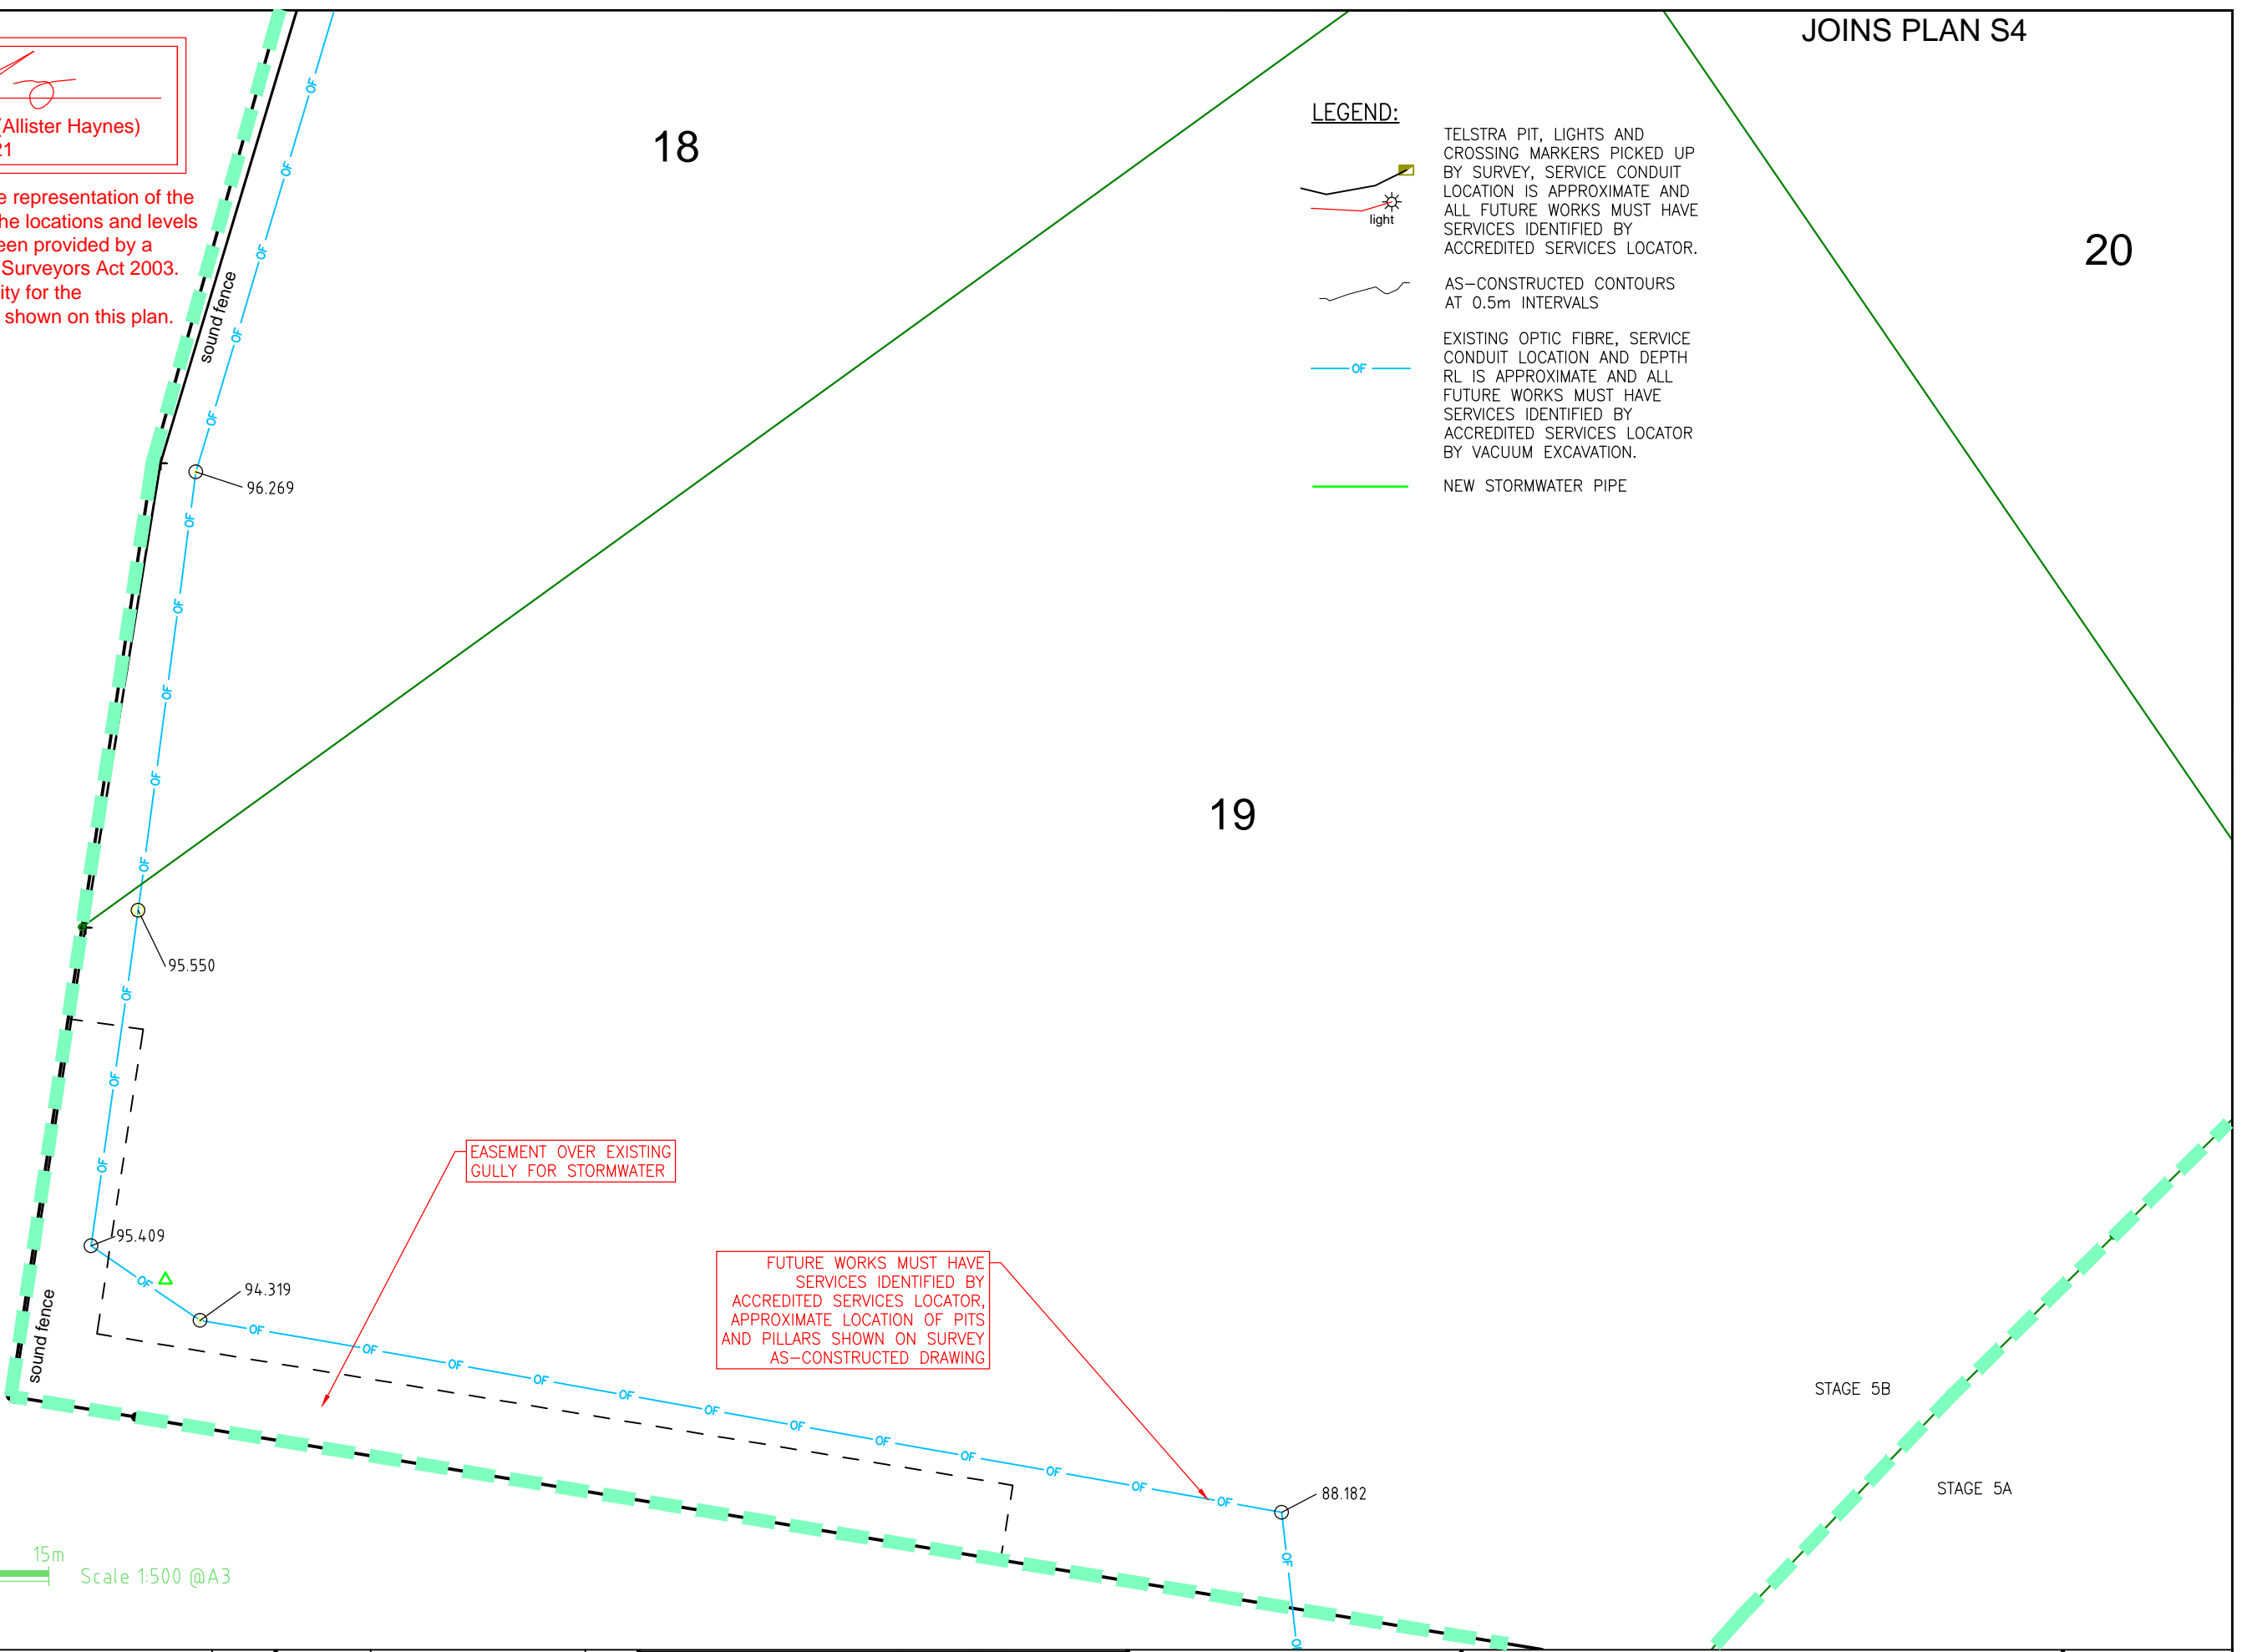



EASEMENT OVER EXISTING GULLY FOR STORMWATER

FUTURE WORKS MUST HAVE SERVICES IDENTIFIED BY ACCREDITED SERVICES LOCATOR, APPROXIMATE LOCATION OF PITS AND PILLARS SHOWN ON SURVEY AS-CONSTRUCTED DRAWING

STAGE 5B


STAGE 5A

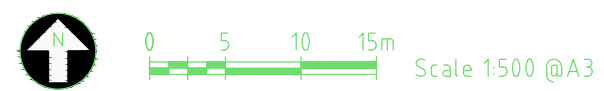

A3	0	2-6-21	AS CONSTRUCTED	ATH	PSM No	OPM 196354		HAYNES CONSULTING ENGINEERS ABN 53 613 630 078 PO BOX 549 NOOSA HEADS QLD 4567 (0432) 784 150	GREENDALE DOWNS STAGE 5B Lots 9-25 on SP323061 Surveyed by Murray and Associates Pty Ltd AS CONSTRUCTED SURVEY LAYOUTS	1803
	Rv	DATE	REVISIONS	APPR.	(AHD) RL	82.215				Sheet No. - Revision No.
					SURVEYED	Murray & Assoc. Pty Ltd				



0 5 10 15m Scale 1:500 @A3

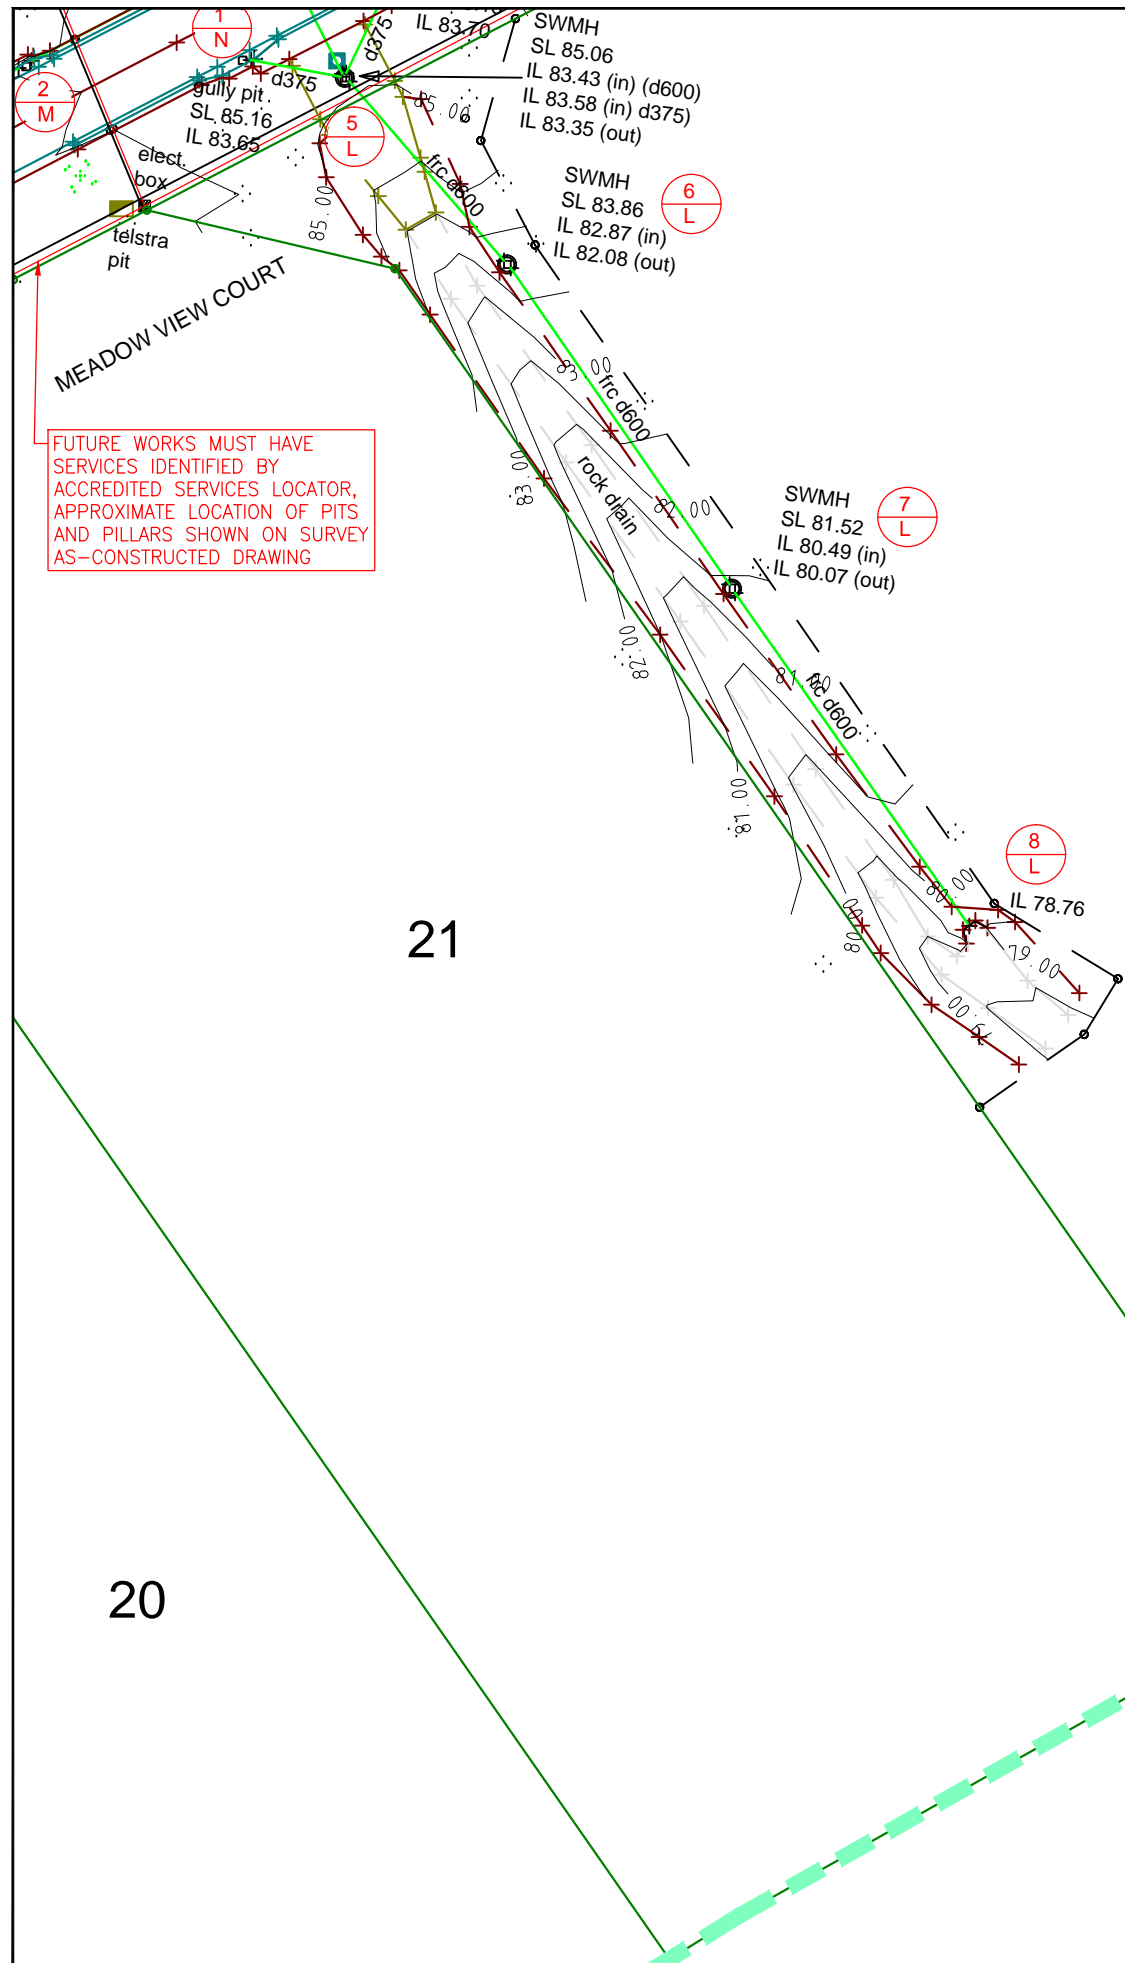

FUTURE WORKS MUST HAVE SERVICES IDENTIFIED BY ACCREDITED SERVICES LOCATOR, APPROXIMATE LOCATION OF PITS AND PILLARS SHOWN ON SURVEY AS-CONSTRUCTED DRAWING

LEGEND:

- TELSTRA PIT, LIGHTS AND CROSSING MARKERS PICKED UP BY SURVEY, SERVICE CONDUIT LOCATION IS APPROXIMATE AND ALL FUTURE WORKS MUST HAVE SERVICES IDENTIFIED BY ACCREDITED SERVICES LOCATOR.
- AS-CONSTRUCTED CONTOURS AT 0.5m INTERVALS
- EXISTING OPTIC FIBRE, SERVICE CONDUIT LOCATION AND DEPTH RL IS APPROXIMATE AND ALL FUTURE WORKS MUST HAVE SERVICES IDENTIFIED BY ACCREDITED SERVICES LOCATOR BY VACUUM EXCAVATION.
- NEW STORMWATER PIPE

CERTIFIED BY:
 RPEQ No.: 13201 (Allister Haynes)
 DATE: 2 / 6 / 21

This drawing is an accurate representation of the works as-constructed. All the locations and levels shown on this plan have been provided by a Surveyor as defined in the Surveyors Act 2003. I hereby accept responsibility for the as-constructed information shown on this plan.

A3	0	2-6-21	AS CONSTRUCTED	ATH
	Rv	DATE	REVISIONS	APPR.

PSM No	OPM 196354
(AHD) RL	82.215
SURVEYED	Murray & Assoc. Pty Ltd



HAYNES CONSULTING ENGINEERS
 ABN 53 613 630 078
 PO BOX 549 NOOSA HEADS QLD 4567
 (0432) 784 150

GREENDALE DOWNS STAGE 5B
 Lots 9-25 on SP323061
 Surveyed by Murray and Associates Pty Ltd
AS CONSTRUCTED SURVEY LAYOUTS

1803
Sheet No. - Revision No.
S5B-S6 0