


 


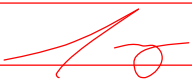


CERTIFIED BY: 
 RPEQ No.: 13201 (Allister Haynes)
 DATE: 3 / 8 / 22

This drawing is an accurate representation of the works as-constructed. All the locations and levels shown on this plan have been provided by a Surveyor as defined in the Surveyors Act 2003. I hereby accept responsibility for the as-constructed information shown on this plan.

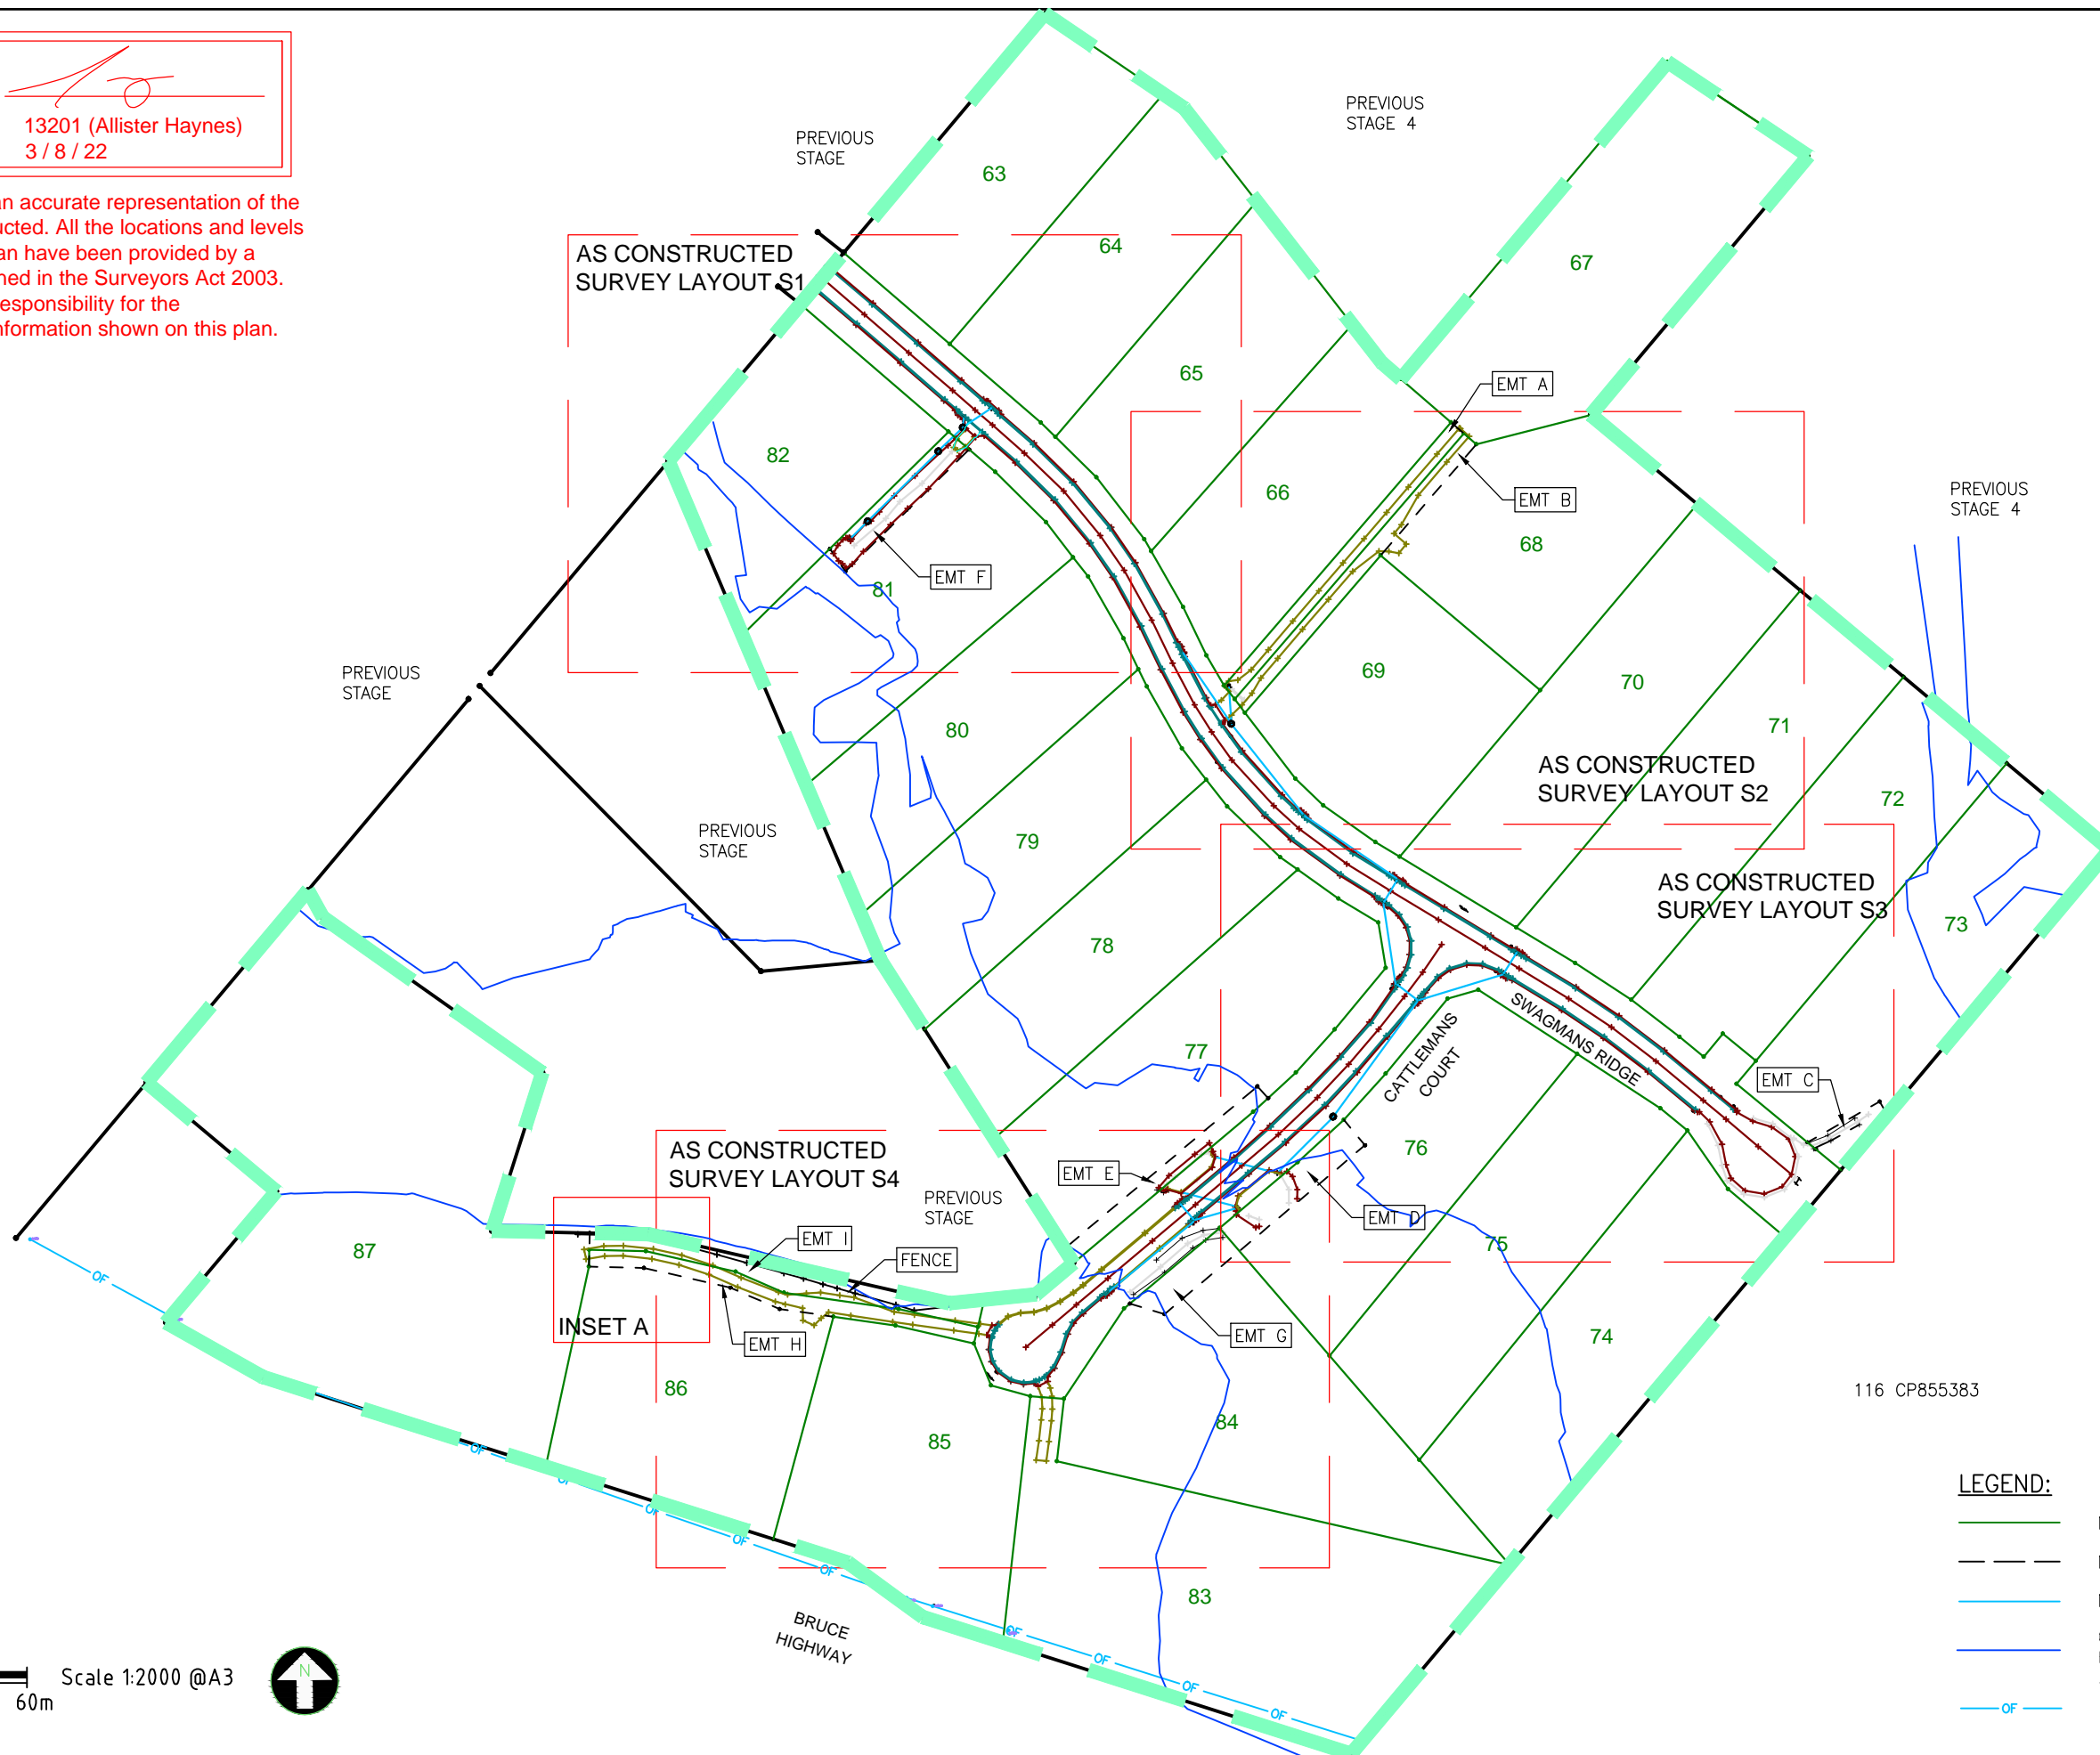


LEGEND:


-  NEW LOT BOUNDARY
-  NEW EASEMENT
-  NEW STORMWATER PIPE
-  Q100 OVERLAND FLOW LEVEL. REFER TO BSM FLOOD STUDY 15-10-2010 FOR CALCULATIONS AND DETAILS.
-  EXISTING OPTIC FIBRE

0 20 40 60m



Scale 1:2000 @A3







A3	1	3-8-22	ADD FLOOD LINES	ATH	PSM No	OPM 196358		HAYNES CONSULTING ENGINEERS ABN 53 613 630 078 PO BOX 549 NOOSA HEADS QLD 4567 (0432) 784 150	CHATSWORTH STAGE 4 Lots 63-87 on SP328631 Surveyed by Murray and Associates Pty Ltd AS CONSTRUCTED SURVEY LAYOUTS	2005
	0	27-7-22	AS CONSTRUCTED		(AHD) RL	84.831				
	Rv	DATE	REVISIONS	APPR.	SURVEYED	Murray & Assoc. Pty Ltd				


CERTIFIED BY: 
 RPEQ No.: 13201 (Allister Haynes)
 DATE: 3/8/22

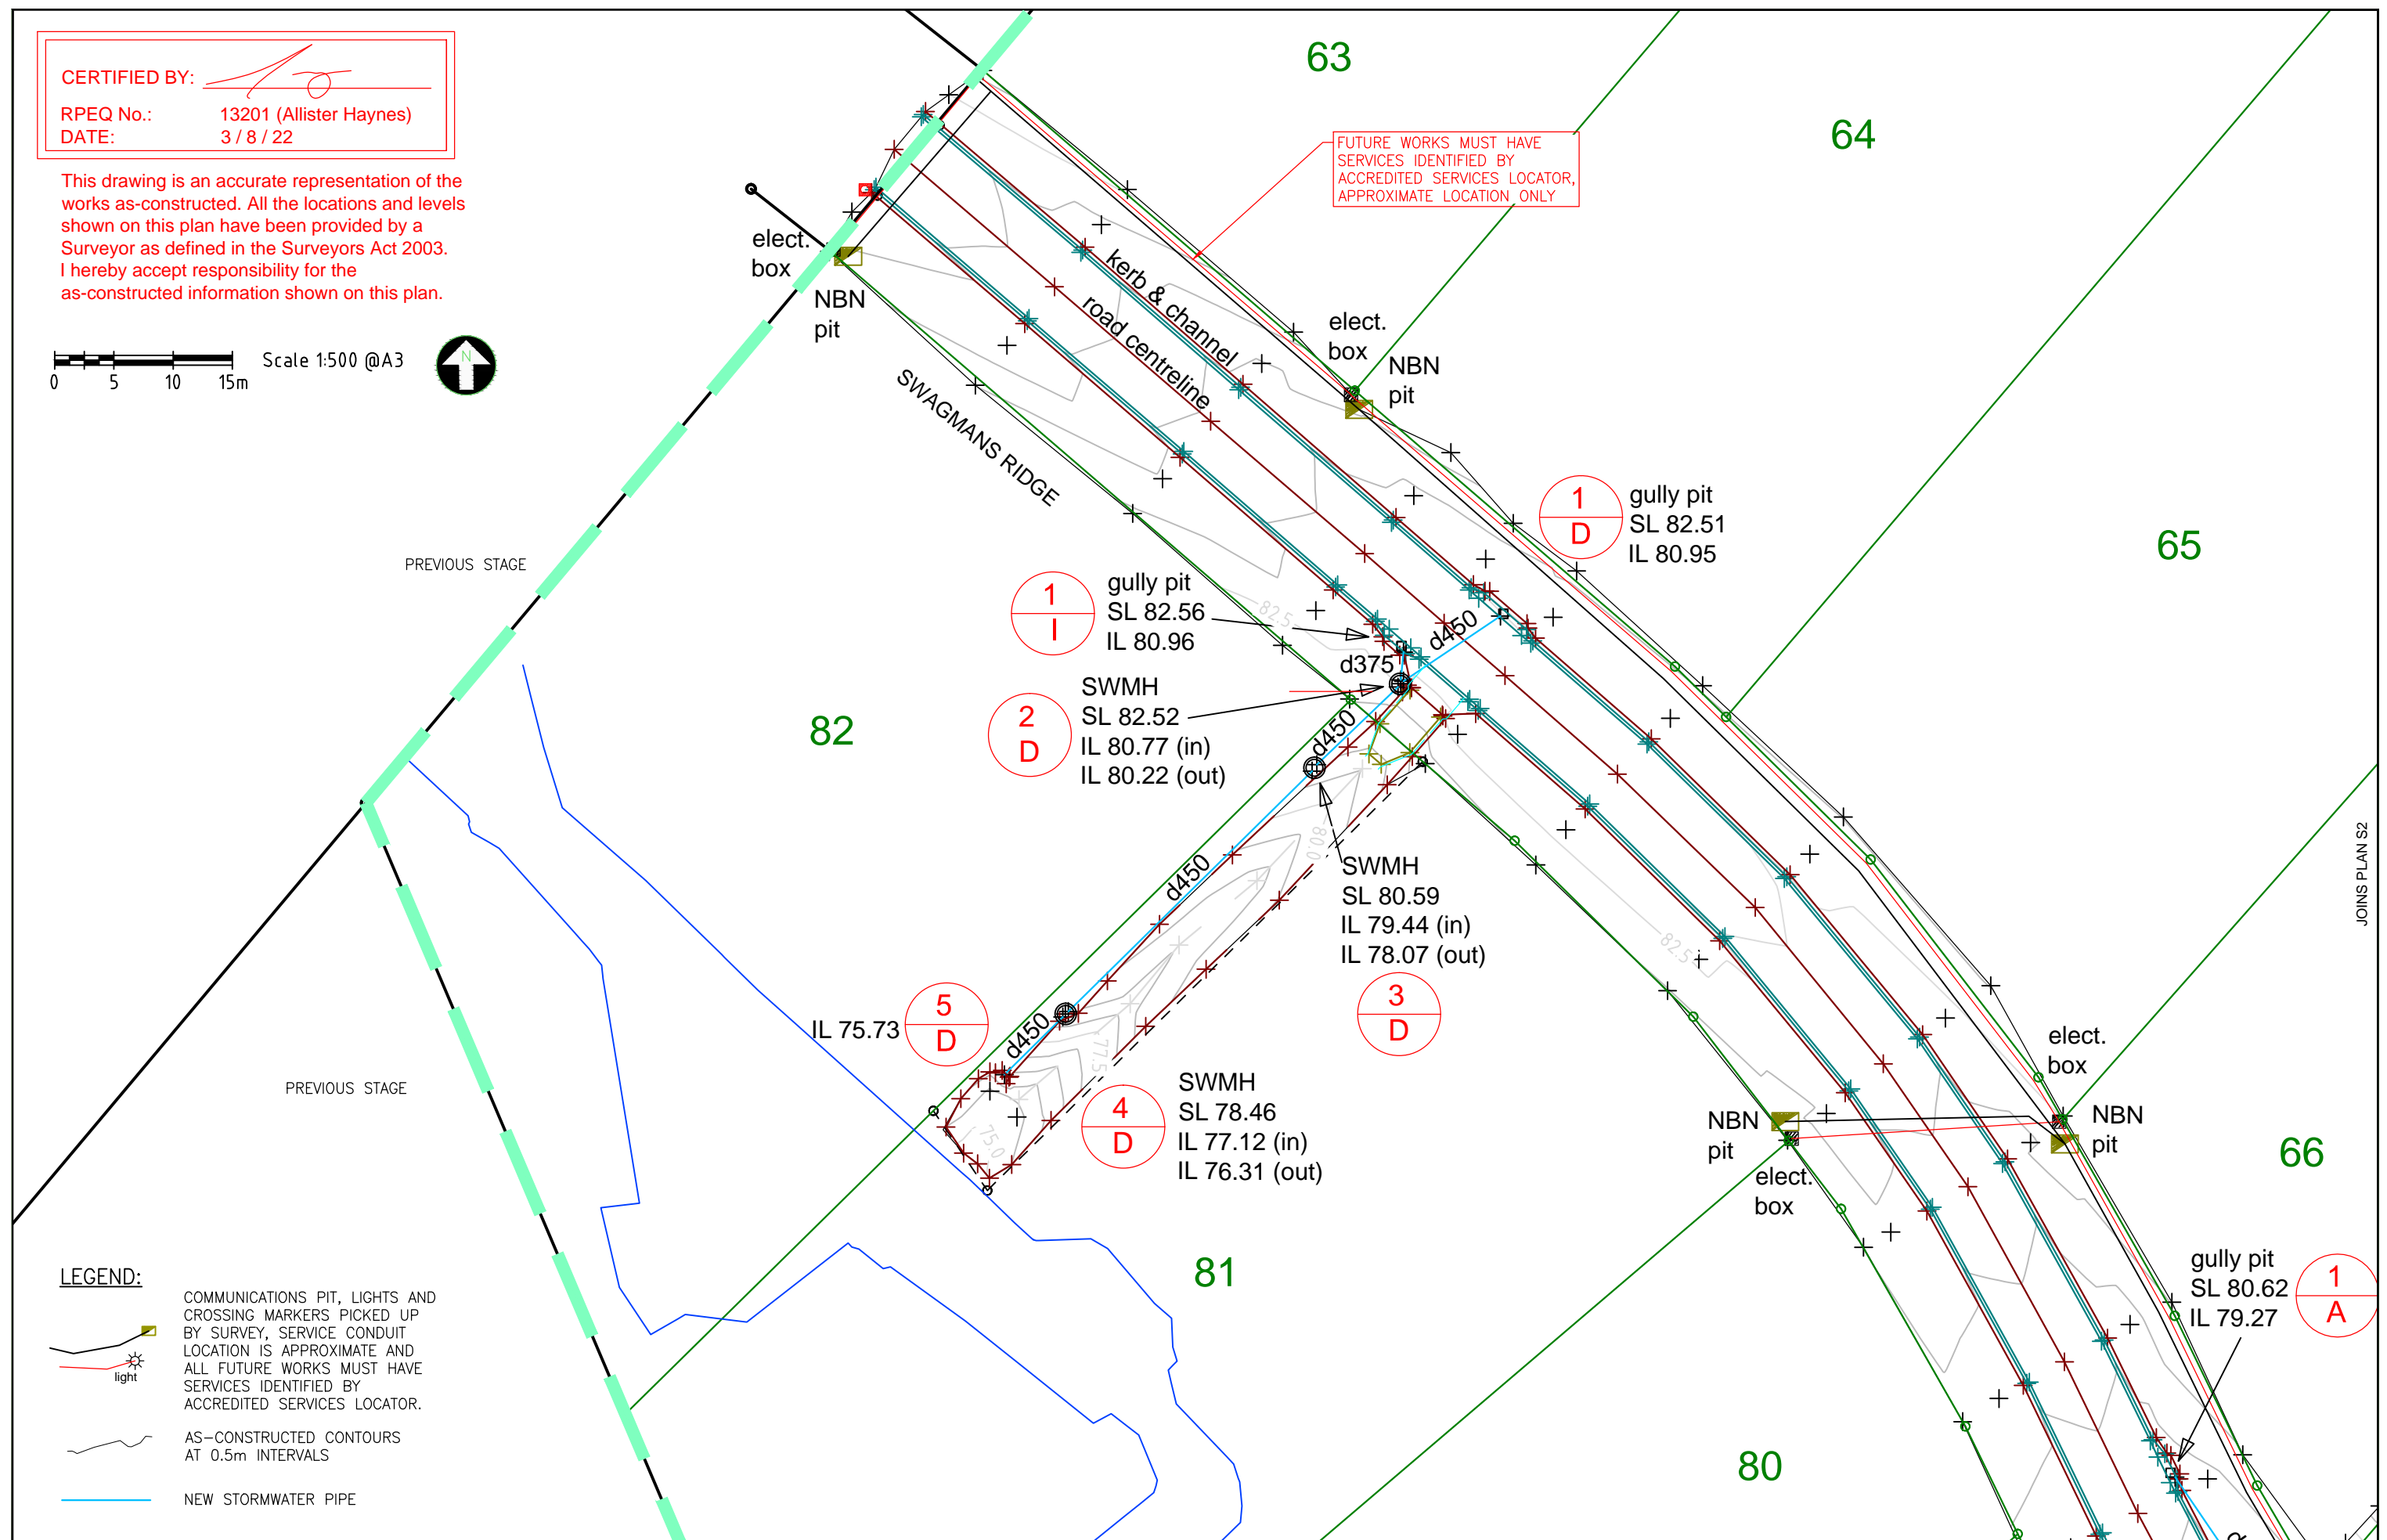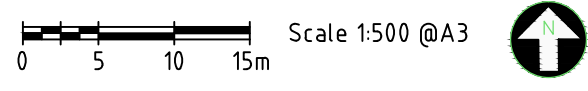This drawing is an accurate representation of the works as-constructed. All the locations and levels shown on this plan have been provided by a Surveyor as defined in the Surveyors Act 2003. I hereby accept responsibility for the as-constructed information shown on this plan.

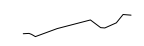

- LEGEND:**
-  COMMUNICATIONS PIT, LIGHTS AND CROSSING MARKERS PICKED UP BY SURVEY, SERVICE CONDUIT LOCATION IS APPROXIMATE AND ALL FUTURE WORKS MUST HAVE SERVICES IDENTIFIED BY ACCREDITED SERVICES LOCATOR.
 -  light
 -  AS-CONSTRUCTED CONTOURS AT 0.5m INTERVALS
 -  NEW STORMWATER PIPE

A3	1	3-8-22	ADD FLOOD LINES AS CONSTRUCTED	ATH	PSM No	OPM 196358
	0	27-7-22		ATH	(AHD) RL	84.831
Rv	DATE	REVISIONS	APPR.		SURVEYED	Murray & Assoc. Pty Ltd

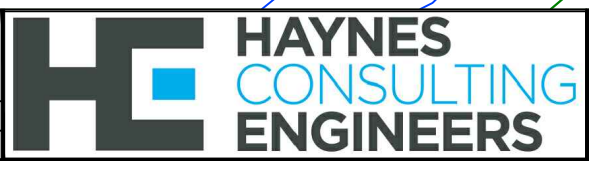




HAYNES CONSULTING ENGINEERS

HAYNES CONSULTING ENGINEERS
 ABN 53 613 630 078
 PO BOX 549 NOOSA HEADS QLD 4567
 (0432) 784 150


CHATSWORTH STAGE 4
 Lots 63-87 on SP328631
 Surveyed by Murray and Associates Pty Ltd
AS CONSTRUCTED SURVEY LAYOUTS

2005	Sheet No. - Revision No.
S4-S1	1




CERTIFIED BY: 
 RPEQ No.: 13201 (Allister Haynes)
 DATE: 3 / 8 / 22

Scale 1:500 @A3

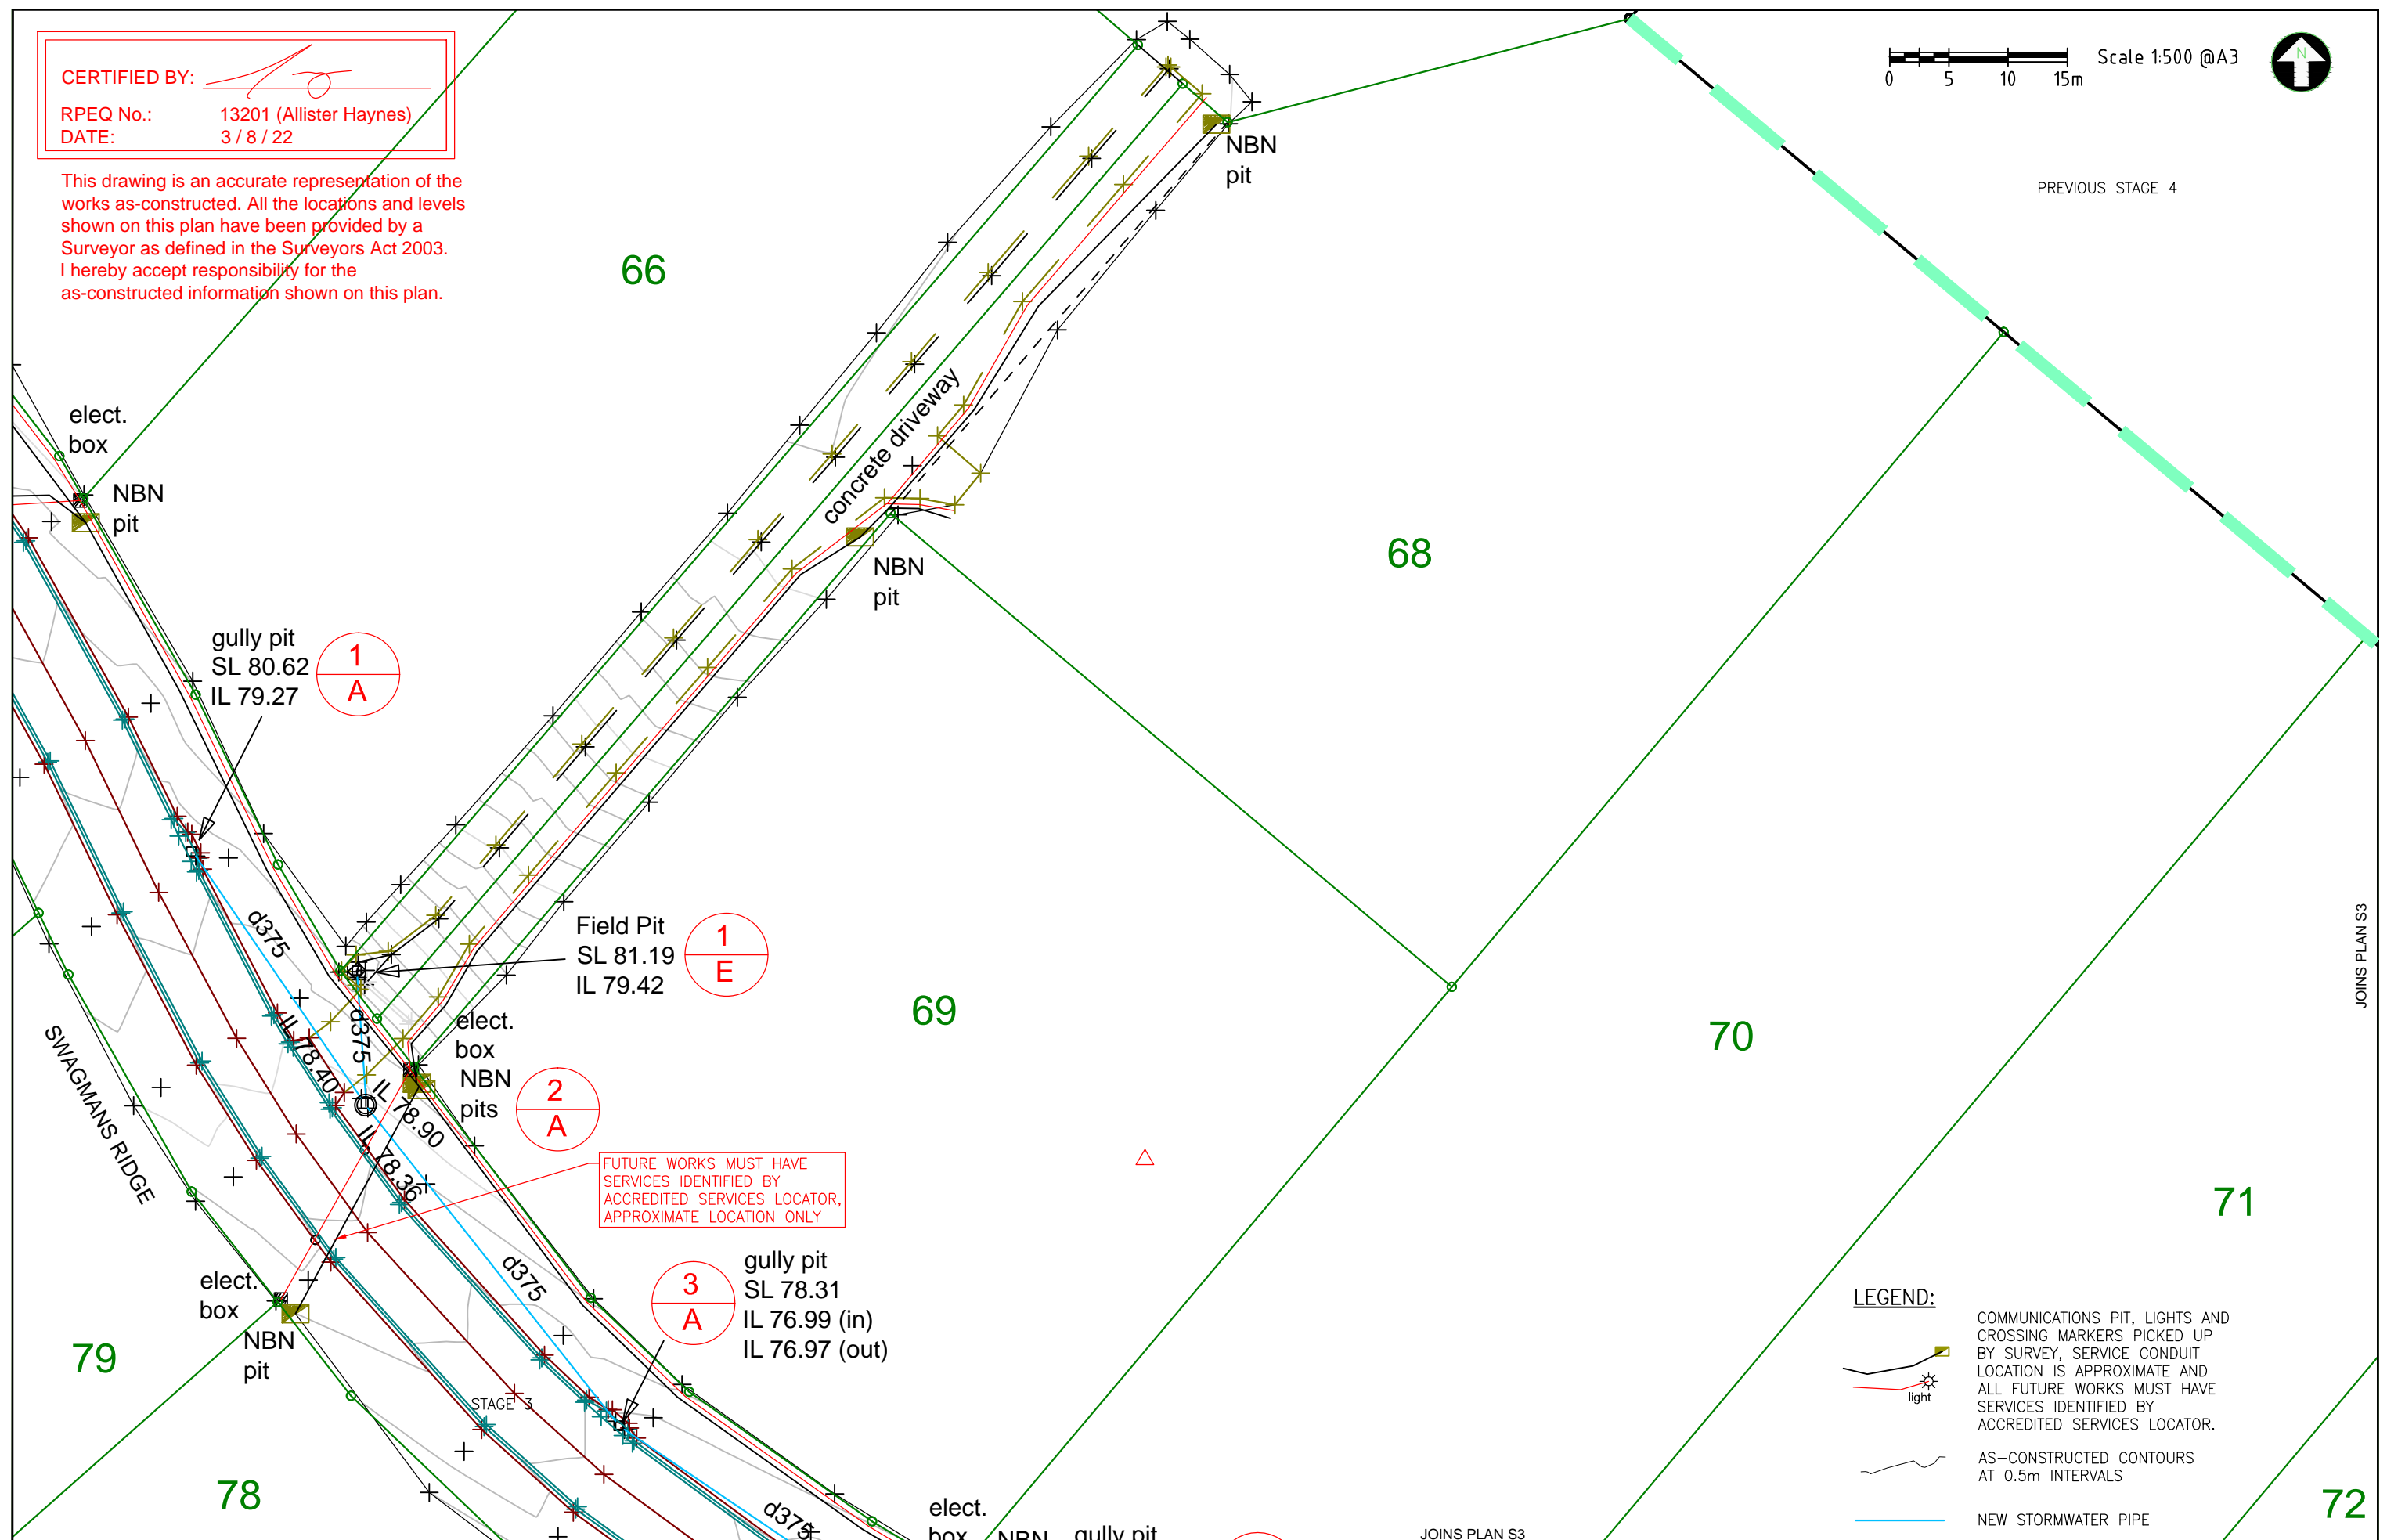

This drawing is an accurate representation of the works as-constructed. All the locations and levels shown on this plan have been provided by a Surveyor as defined in the Surveyors Act 2003. I hereby accept responsibility for the as-constructed information shown on this plan.

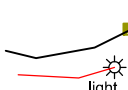

LEGEND:

-  COMMUNICATIONS PIT, LIGHTS AND CROSSING MARKERS PICKED UP BY SURVEY, SERVICE CONDUIT LOCATION IS APPROXIMATE AND ALL FUTURE WORKS MUST HAVE SERVICES IDENTIFIED BY ACCREDITED SERVICES LOCATOR.
-  AS-CONSTRUCTED CONTOURS AT 0.5m INTERVALS
-  NEW STORMWATER PIPE

A3	1	3-8-22	ADD FLOOD LINES AS CONSTRUCTED	ATH	PSM No	OPM 196358
	0	27-7-22		ATH	(AHD) RL	84.831
Rv	DATE	REVISIONS	APPR.		SURVEYED	Murray & Assoc. Pty Ltd

ATH	PSM No	OPM 196358
ATH	(AHD) RL	84.831
APPR.	SURVEYED	Murray & Assoc. Pty Ltd




HAYNES CONSULTING ENGINEERS

HAYNES CONSULTING ENGINEERS
 ABN 53 613 630 078
 PO BOX 549 NOOSA HEADS QLD 4567
 (0432) 784 150

CHATS WORTH STAGE 4
 Lots 63-87 on SP328631
 Surveyed by Murray and Associates Pty Ltd
AS CONSTRUCTED SURVEY LAYOUTS

2005	Sheet No. - Revision No.
S4-S2	1

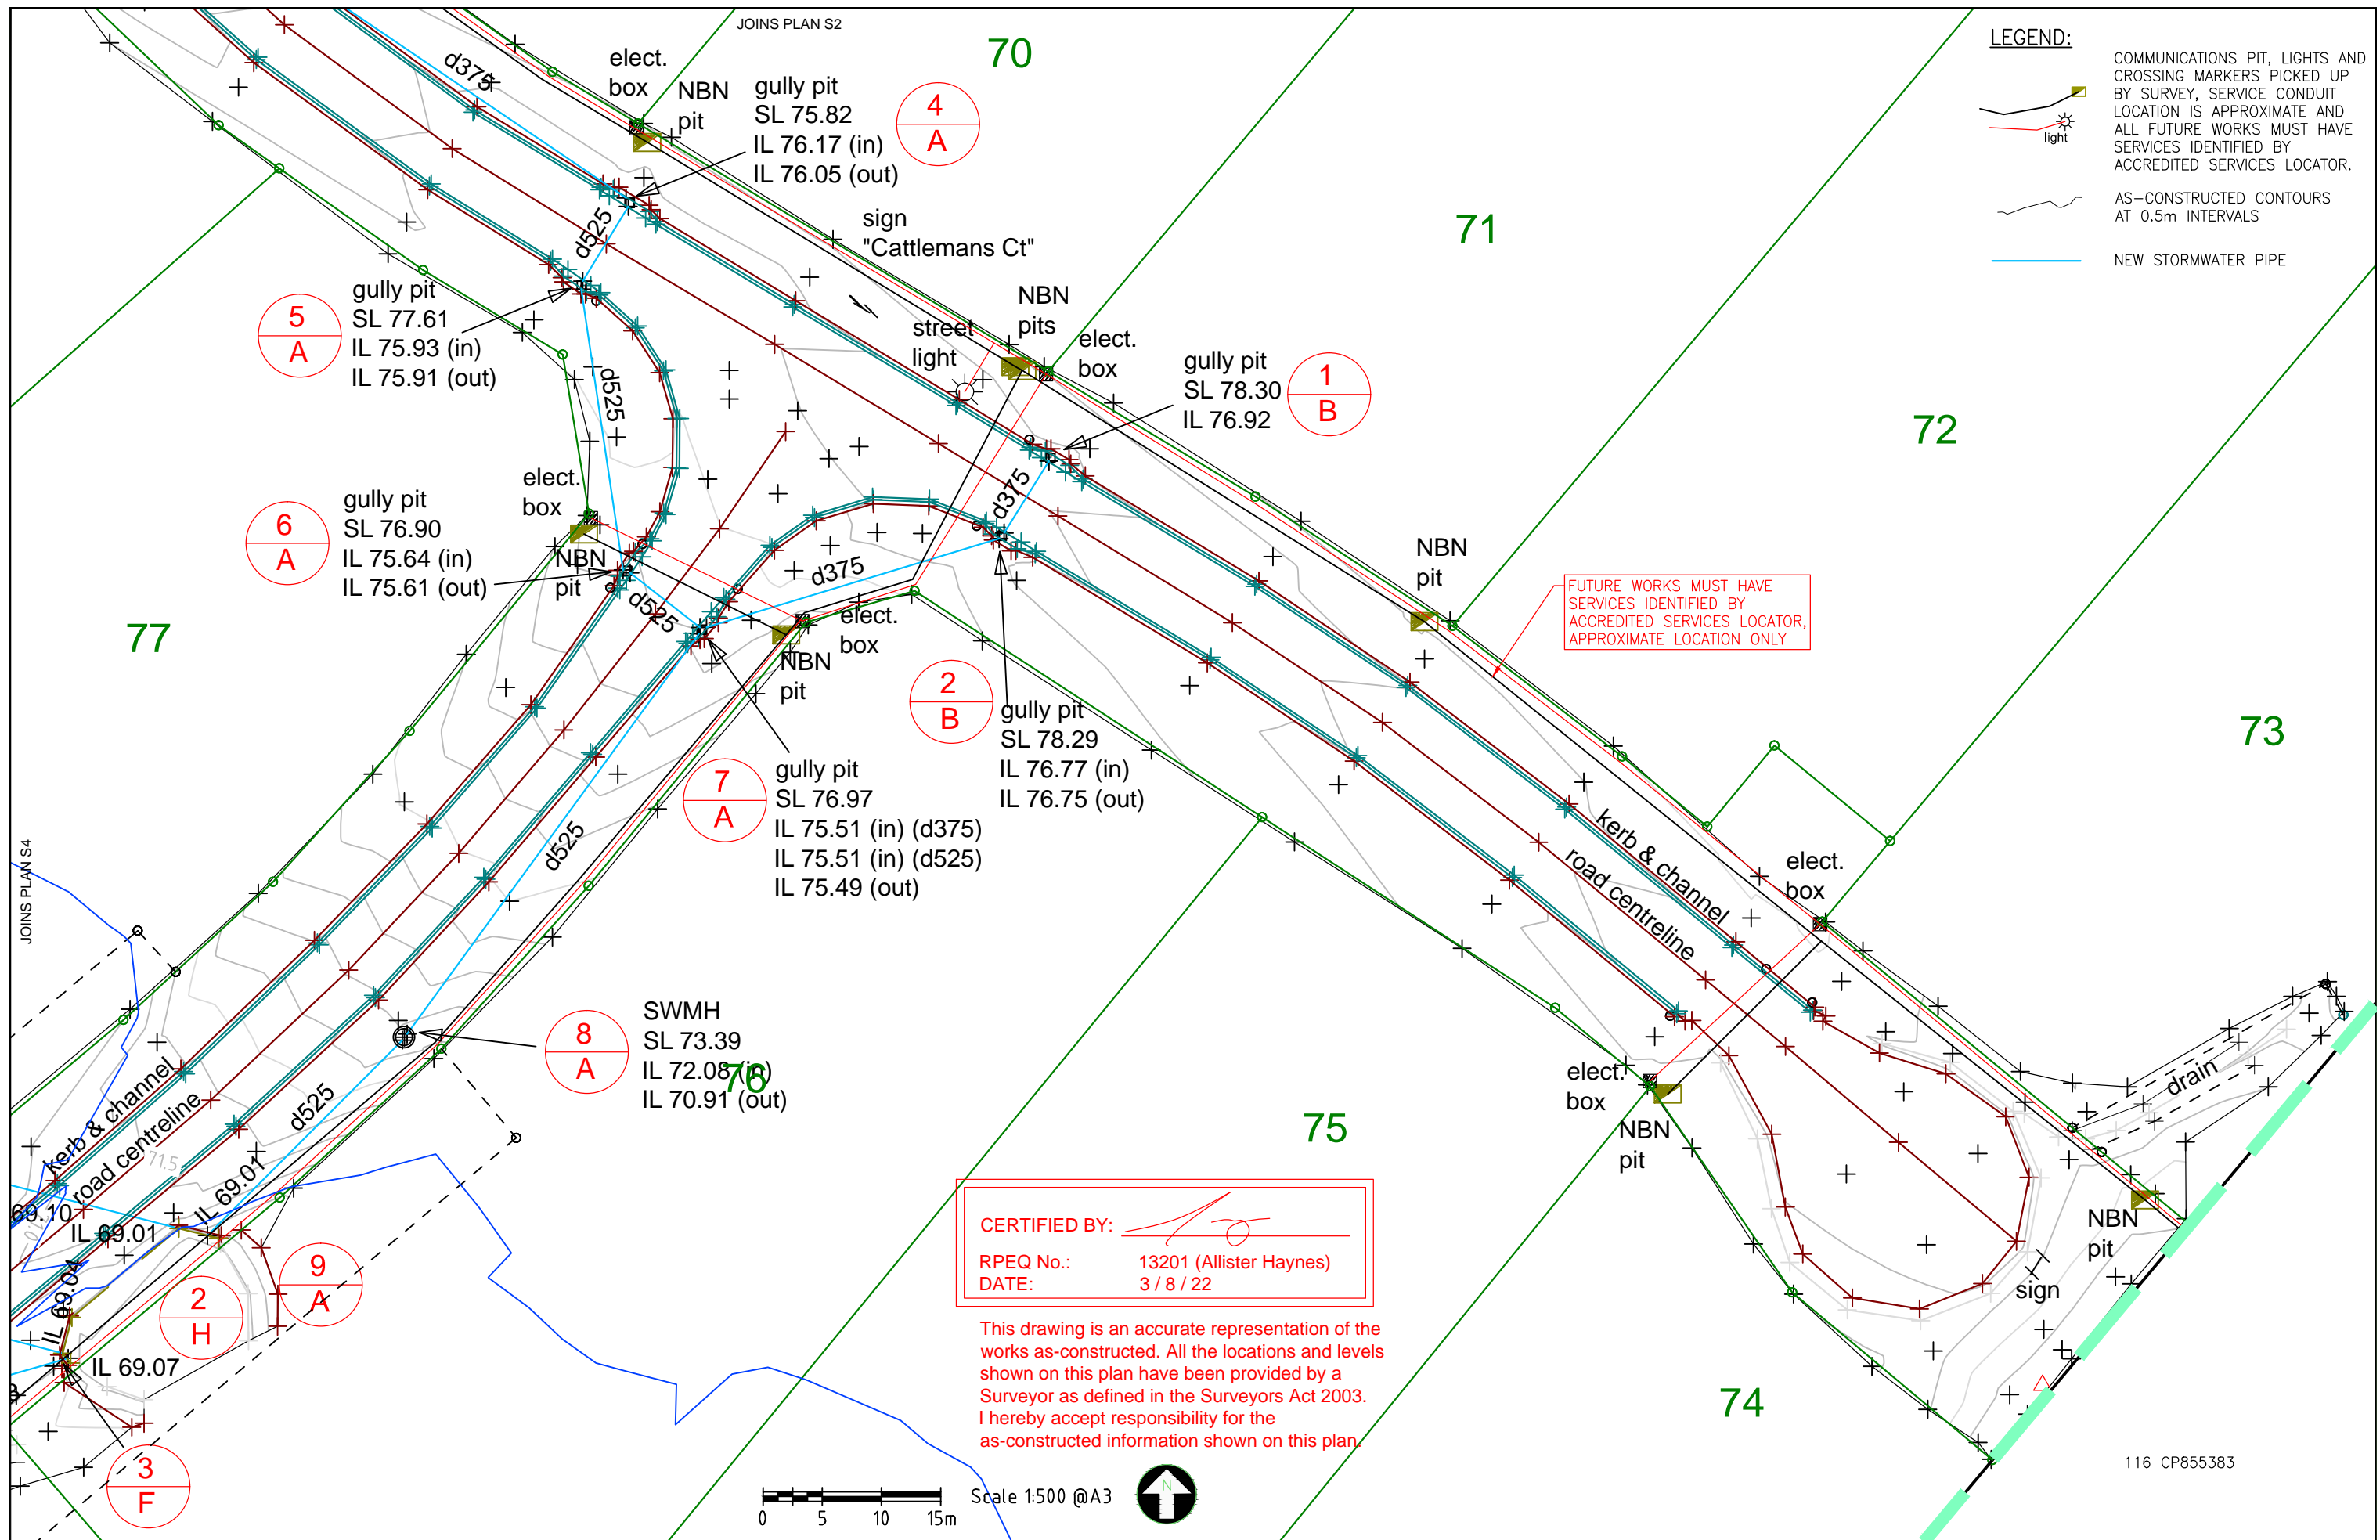

A3	1	3-8-22	ADD FLOOD LINES	ATH
	0	27-7-22	AS CONSTRUCTED	
	Rv	DATE	REVISIONS	APPR.


PSM No	OPM 196358
(AHD) RL	84.831
SURVEYED	Murray & Assoc. Pty Ltd




HAYNES CONSULTING ENGINEERS
ABN 53 613 630 078
PO BOX 549 NOOSA HEADS QLD 4567
(0432) 784 150

CHATSWORTH STAGE 4
Lots 63-87 on SP328631
Surveyed by Murray and Associates Pty Ltd
AS CONSTRUCTED SURVEY LAYOUTS

2005
Sheet No. - Revision No.
S4-S3 1

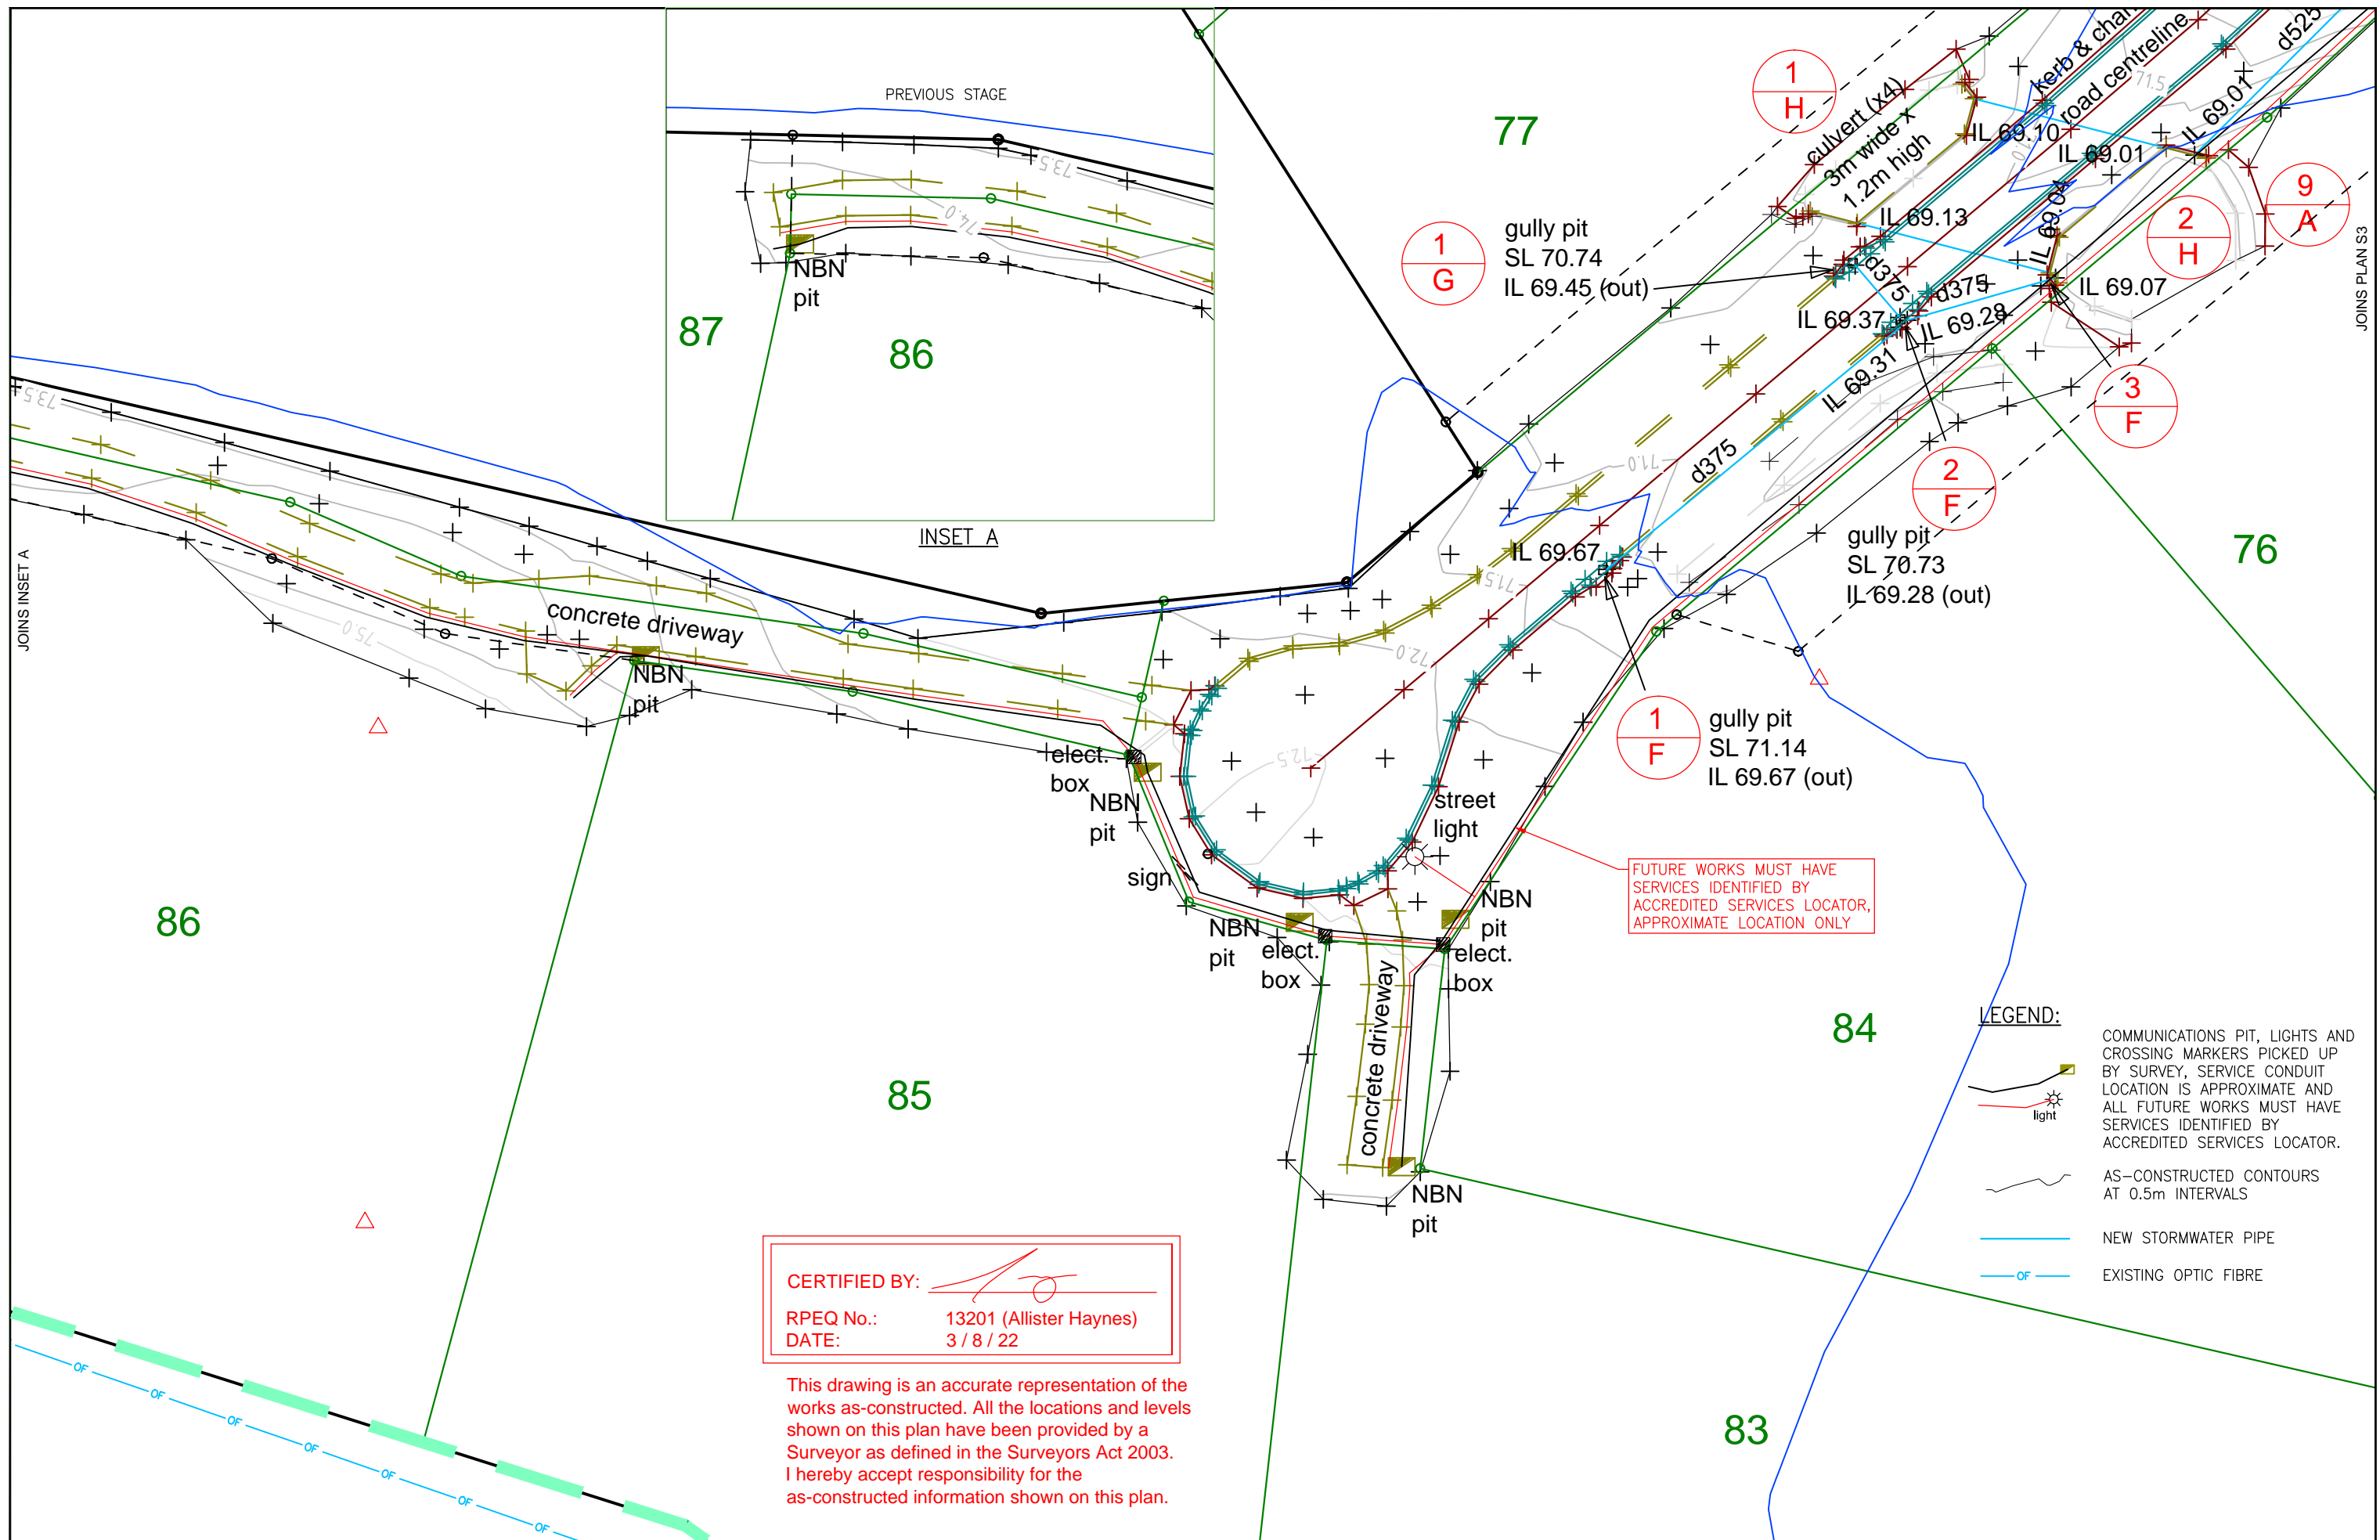
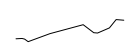




CERTIFIED BY: 

RPEQ No.: 13201 (Allister Haynes)
 DATE: 3 / 8 / 22


This drawing is an accurate representation of the works as-constructed. All the locations and levels shown on this plan have been provided by a Surveyor as defined in the Surveyors Act 2003. I hereby accept responsibility for the as-constructed information shown on this plan.

FUTURE WORKS MUST HAVE SERVICES IDENTIFIED BY ACCREDITED SERVICES LOCATOR, APPROXIMATE LOCATION ONLY

- LEGEND:**
-  COMMUNICATIONS PIT, LIGHTS AND CROSSING MARKERS PICKED UP BY SURVEY, SERVICE CONDUIT LOCATION IS APPROXIMATE AND ALL FUTURE WORKS MUST HAVE SERVICES IDENTIFIED BY ACCREDITED SERVICES LOCATOR.
 -  AS-CONSTRUCTED CONTOURS AT 0.5m INTERVALS
 -  NEW STORMWATER PIPE
 -  EXISTING OPTIC FIBRE

A3	1	3-8-22	ADD FLOOD LINES	ATH
	0	27-7-22	AS CONSTRUCTED	
	Rv	DATE	REVISIONS	APPR.

PSM No	OPM 196358
(AHD) RL	84.831
SURVEYED	Murray & Assoc. Pty Ltd

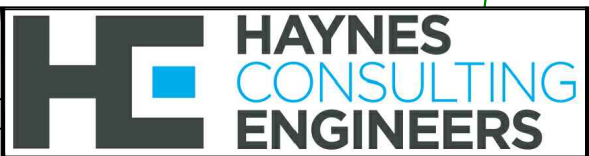

HAYNES CONSULTING ENGINEERS
 ABN 53 613 630 078
 PO BOX 549 NOOSA HEADS QLD 4567
 (0432) 784 150

CHATSWORTH STAGE 4
 Lots 63-87 on SP328631
 Surveyed by Murray and Associates Pty Ltd
AS CONSTRUCTED SURVEY LAYOUTS

2005
Sheet No. - Revision No.
S4-S4 1