


NOTE: PLANS AND ADAC ARE ON GDA2020 COORDINATES


CERTIFIED BY:

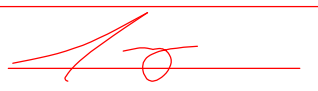

RPEQ No.: 13201 (Allister Haynes)

DATE: 7/11/23

This drawing is an accurate representation of the works as-constructed. All the locations and levels shown on this plan have been provided by a Surveyor as defined in the Surveyors Act 2003. I hereby accept responsibility for the as-constructed information shown on this plan.

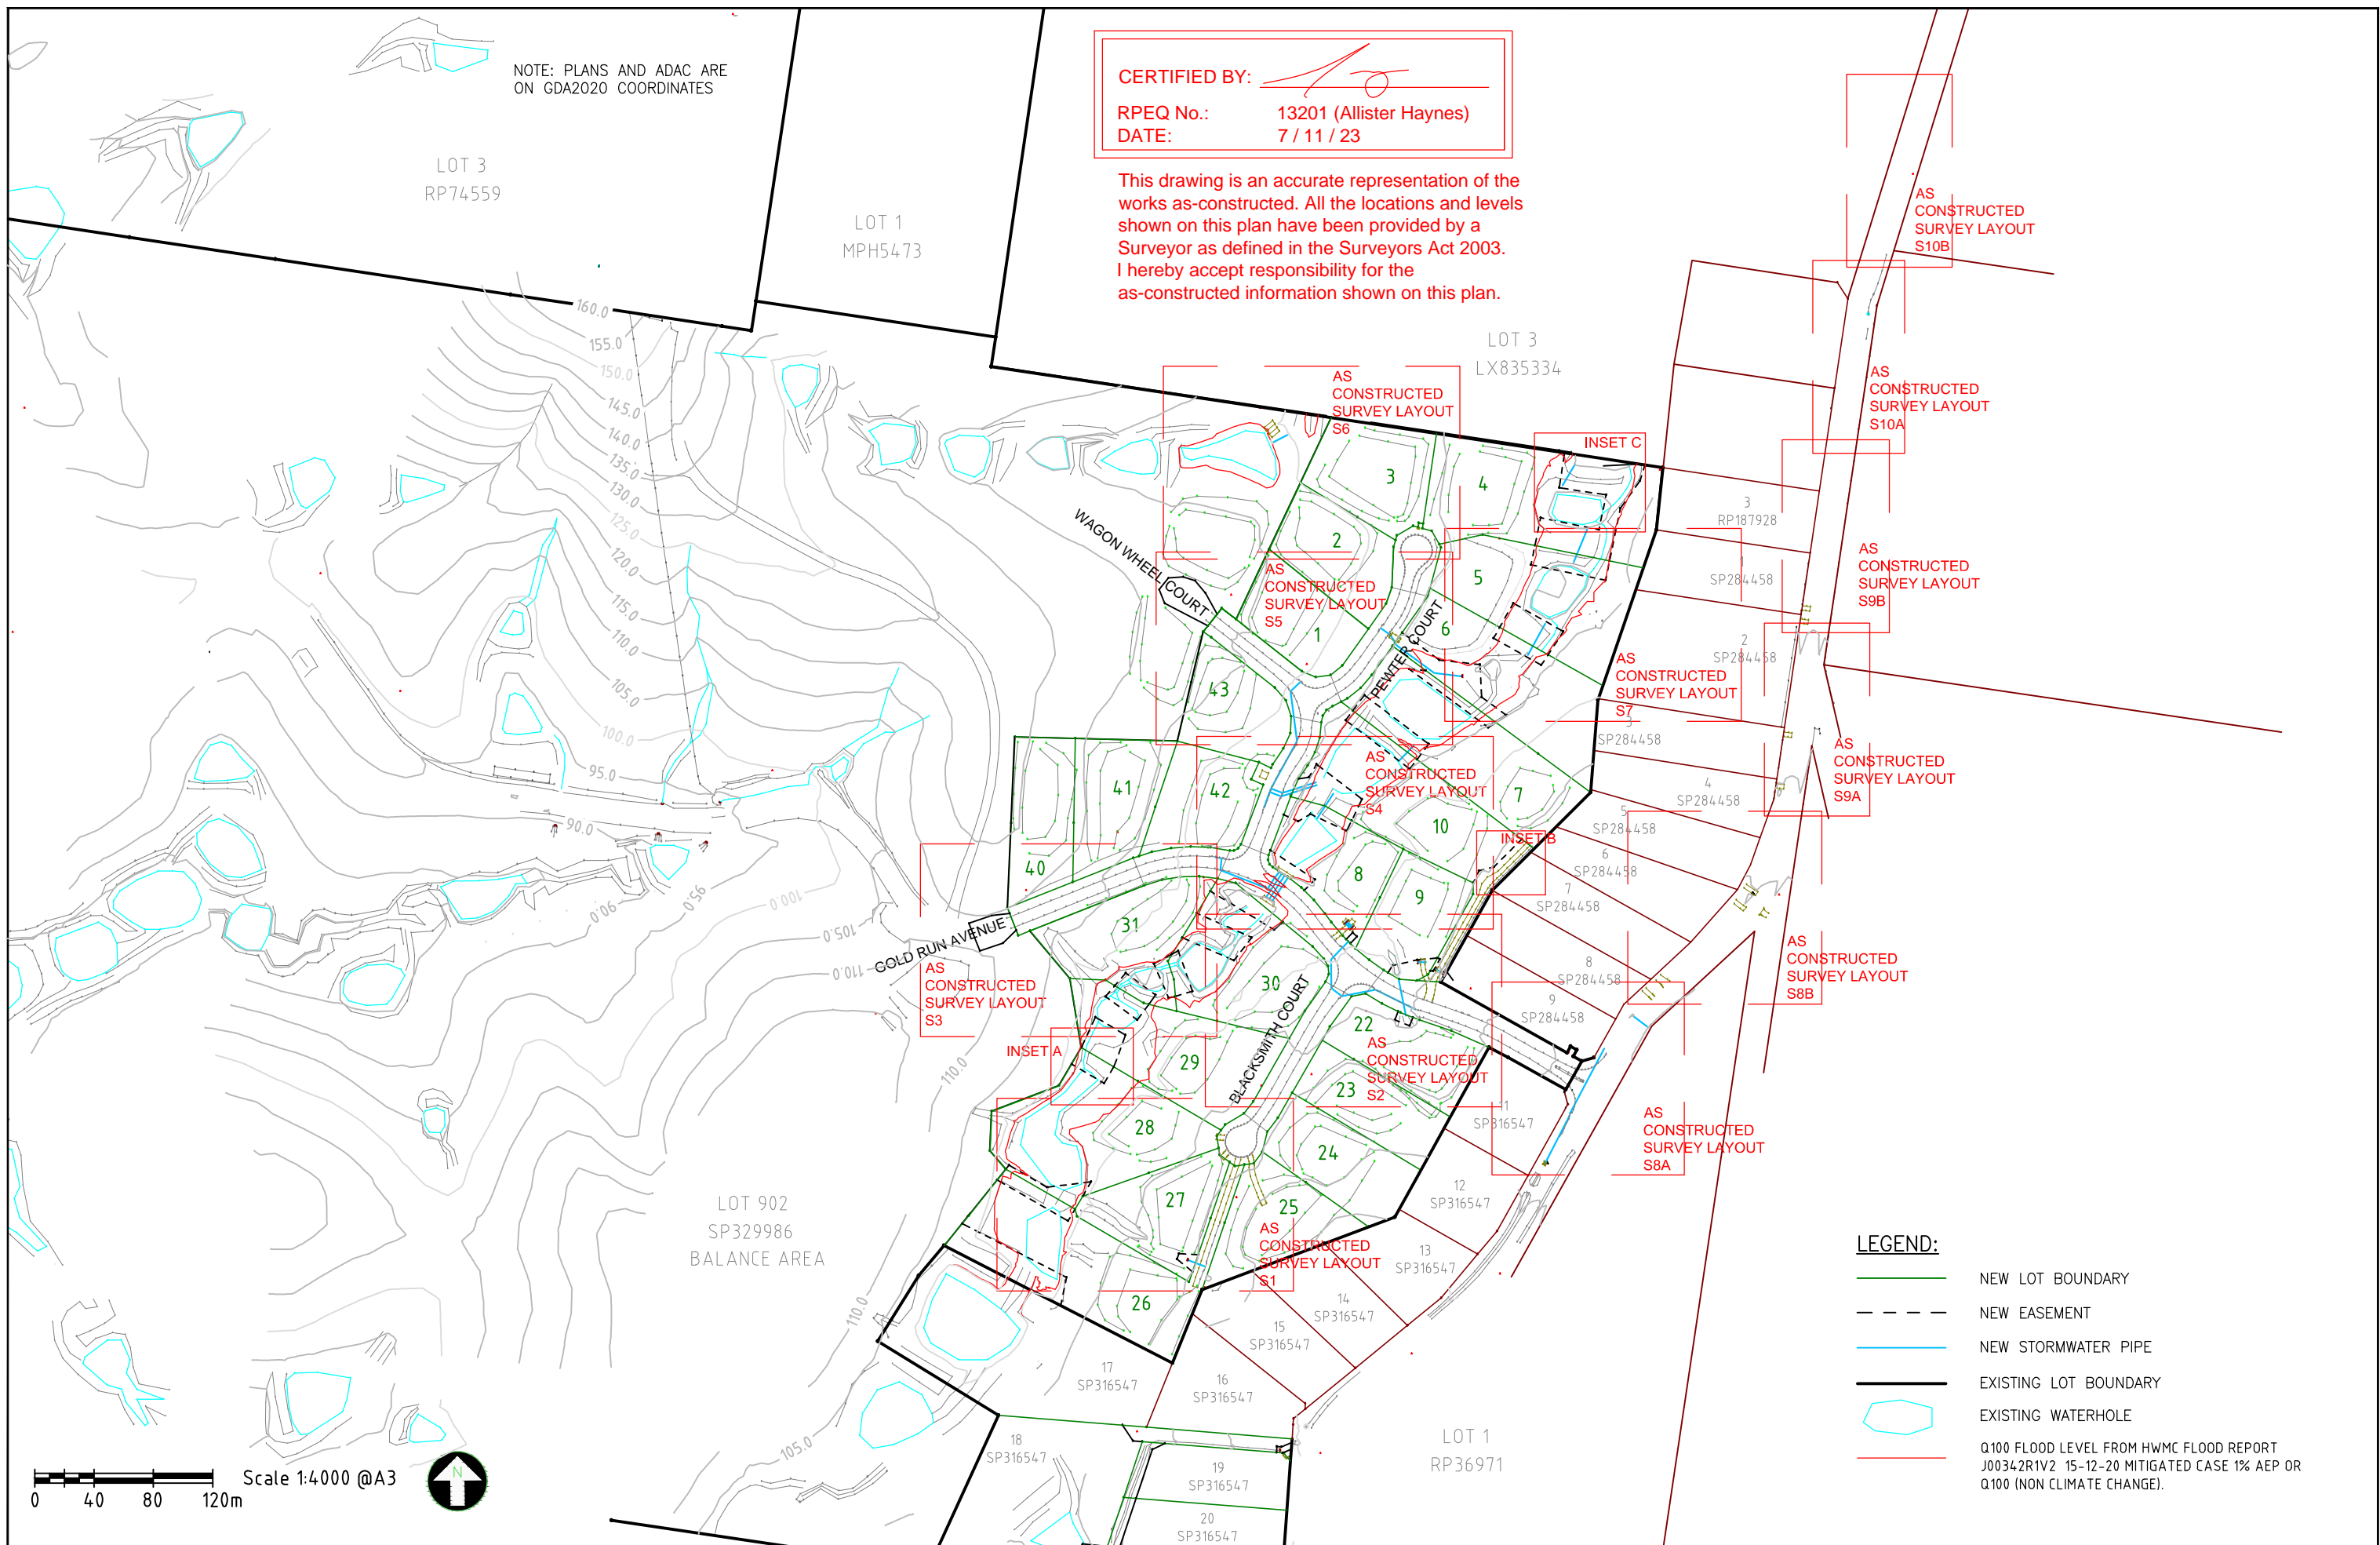


LEGEND:








- NEW LOT BOUNDARY
- - - NEW EASEMENT
- NEW STORMWATER PIPE
- EXISTING LOT BOUNDARY
- EXISTING WATERHOLE
- Q100 FLOOD LEVEL FROM HPMC FLOOD REPORT J00342R1V2 15-12-20 MITIGATED CASE 1% AEP OR Q100 (NON CLIMATE CHANGE).



Scale 1:4000 @A3




A3	1	21-11-23	AMEND TITLE BLOCK	ATH	PSM No OPM/42916	(AHD) RL 161.931	SURVEYED Murray & Assoc. Pty Ltd		HAYNES CONSULTING ENGINEERS ABN 53 613 630 078 PO BOX 549 NOOSA HEADS QLD 4667 (0432) 784 150	MCINTOSH PARK STAGE 3-4 Lots 1-10, 22-31, 40-43 on SP329986 Surveyed by Murray and Associates Pty Ltd AS CONSTRUCTED SURVEY LAYOUTS	1803-MP
	0	7-11-23	AS CONSTRUCTED								


LEGEND:

-  COMMUNICATIONS PIT, LIGHTS AND CROSSING MARKERS PICKED UP BY SURVEY, SERVICE CONDUIT LOCATION IS APPROXIMATE AND ALL FUTURE WORKS MUST HAVE SERVICES IDENTIFIED BY ACCREDITED SERVICES LOCATOR.
-  AS-CONSTRUCTED CONTOURS AT 0.5m INTERVALS
-  NEW STORMWATER PIPE
-  NEW SUBSOIL DRAIN INSPECTION POINT
-  EXISTING WATERHOLE
-  Q100 FLOOD LEVEL FROM HWMC FLOOD REPORT J00342R1V2 15-12-20 MITIGATED CASE 1% AEP OR Q100 (NON CLIMATE CHANGE).
-  NEW TREE, T=TUCKEROO, L=LUSCIOUS

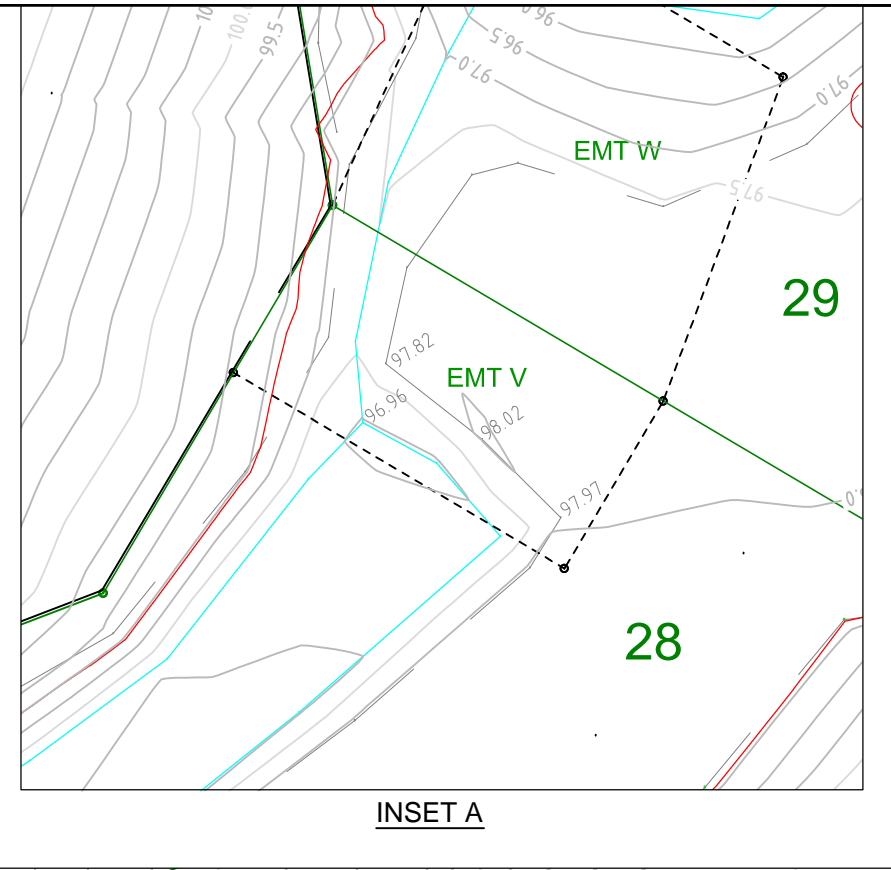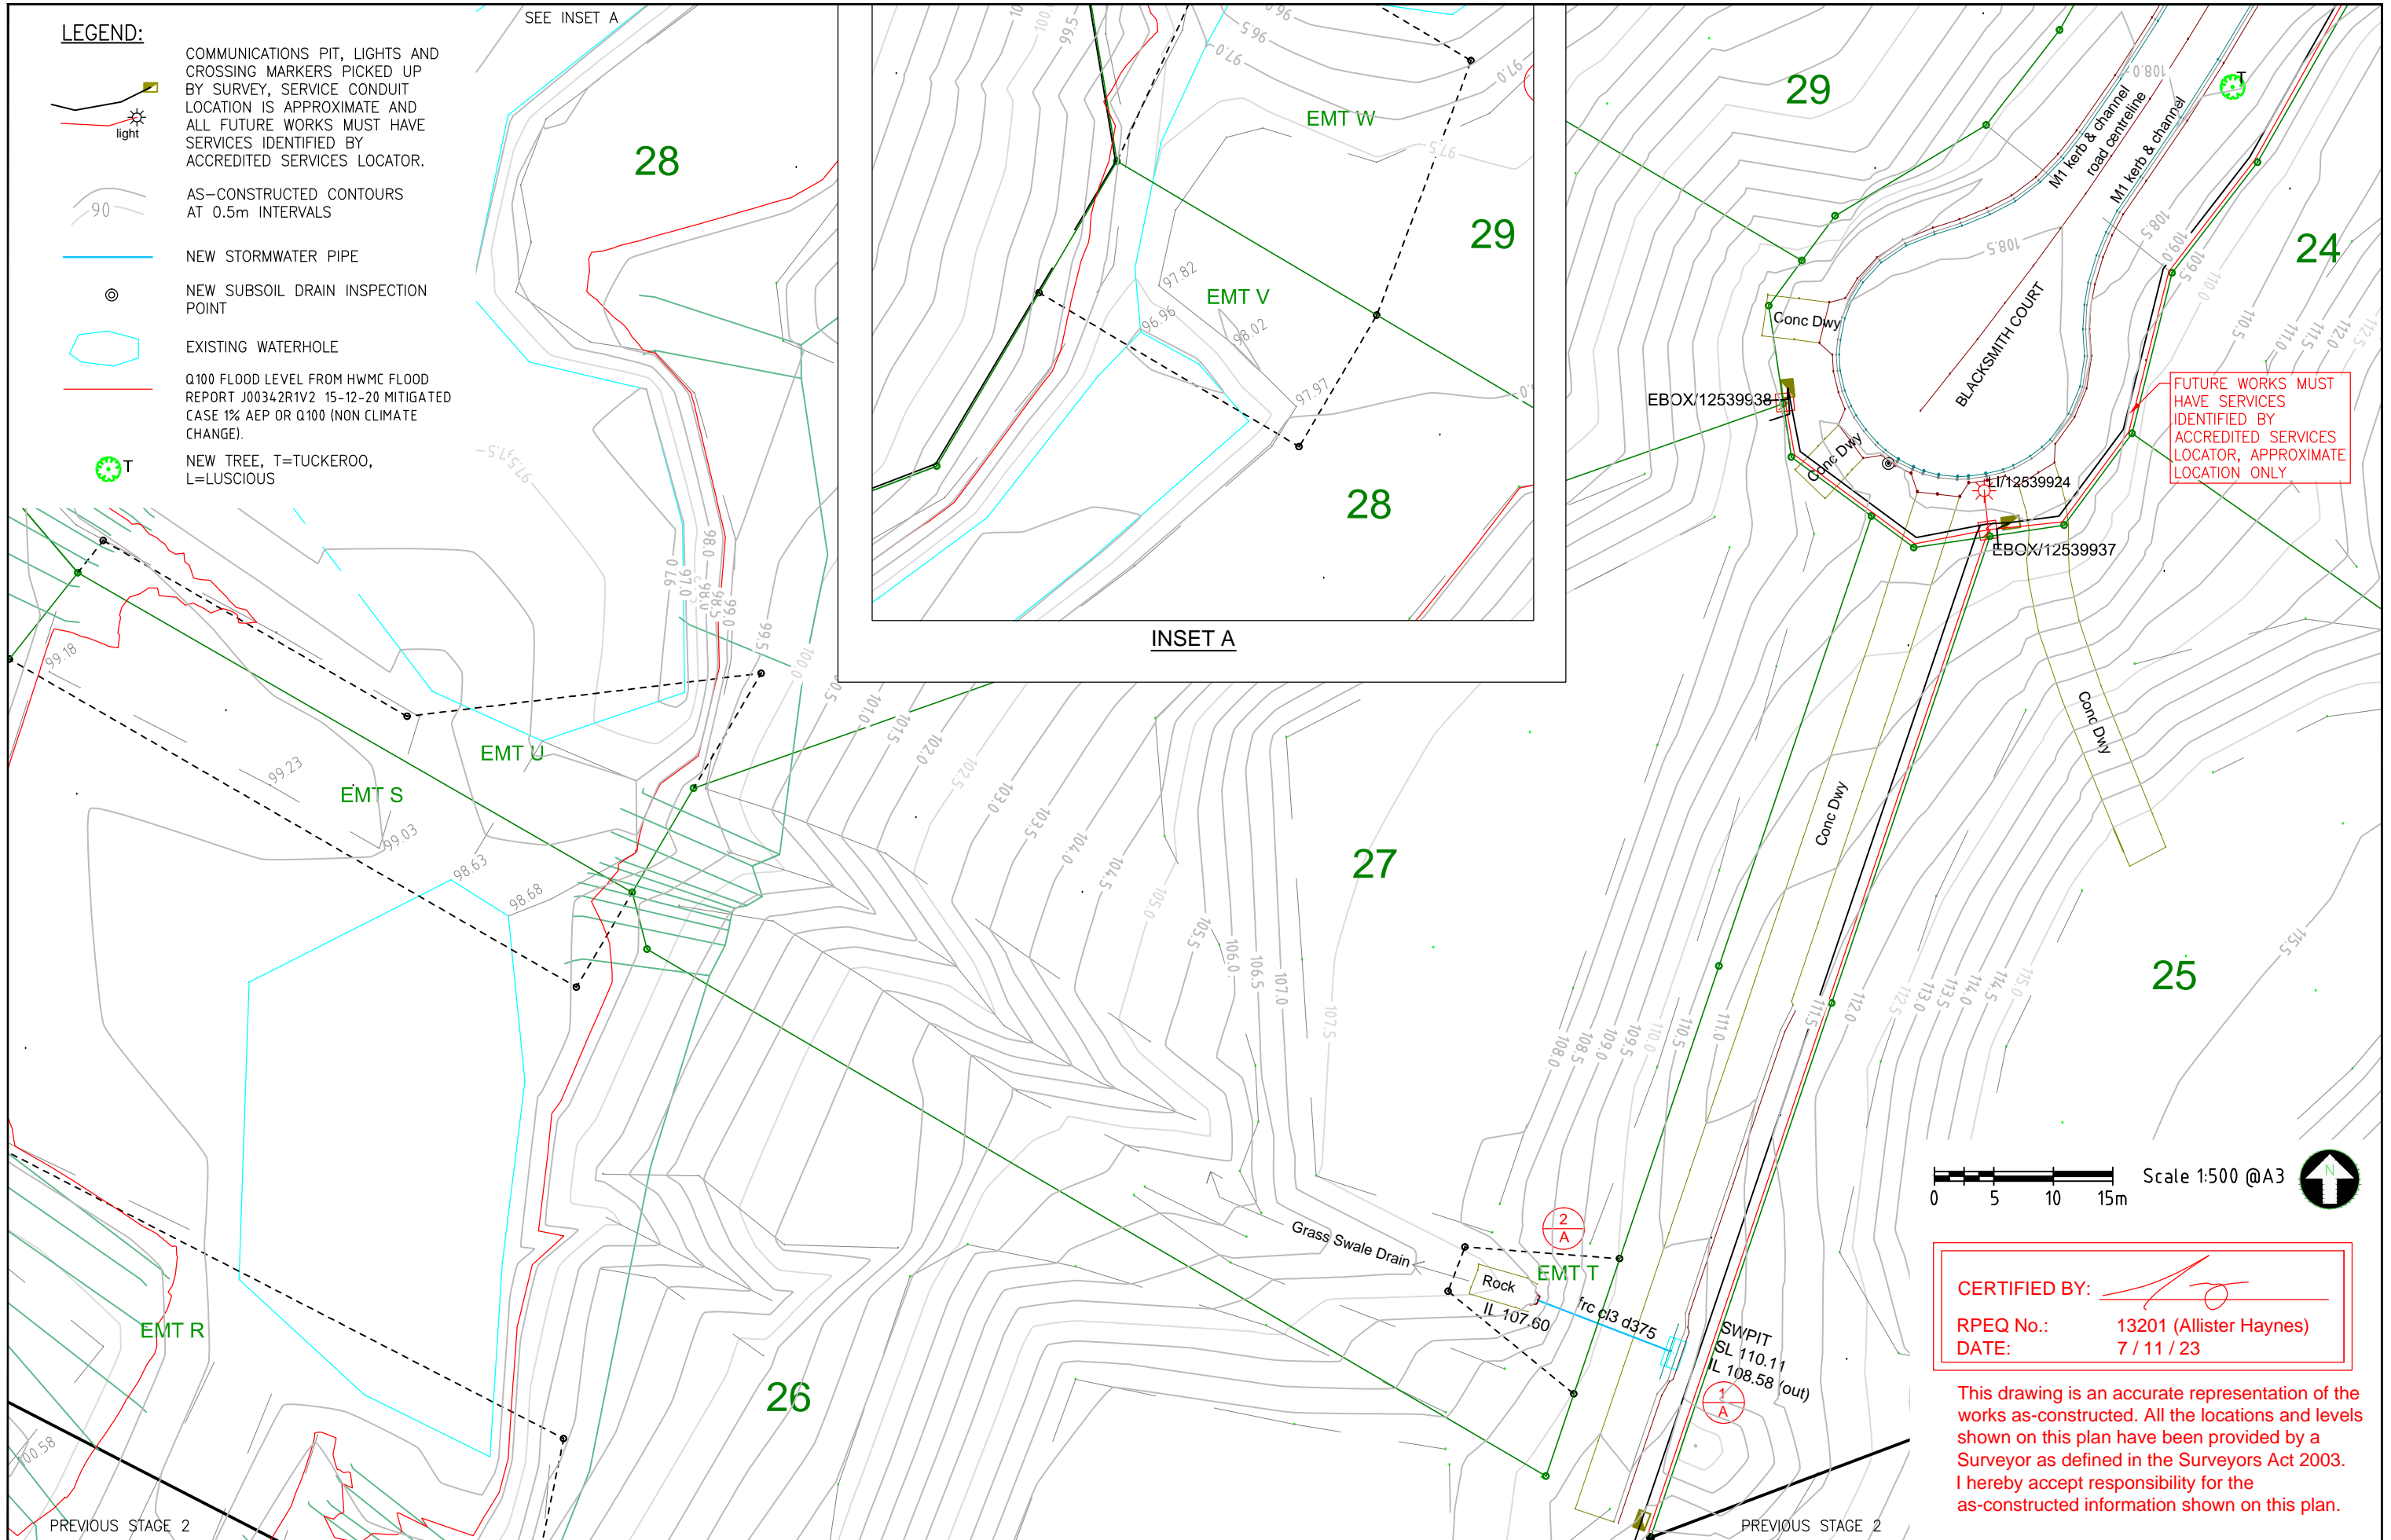

FUTURE WORKS MUST HAVE SERVICES IDENTIFIED BY ACCREDITED SERVICES LOCATOR, APPROXIMATE LOCATION ONLY

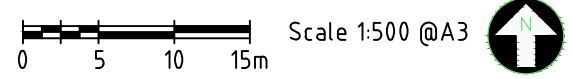

CERTIFIED BY: 
RPEQ No.: 13201 (Allister Haynes)
DATE: 7 / 11 / 23

This drawing is an accurate representation of the works as-constructed. All the locations and levels shown on this plan have been provided by a Surveyor as defined in the Surveyors Act 2003. I hereby accept responsibility for the as-constructed information shown on this plan.

A3	1	21-11-23	AMEND TITLE BLOCK	ATH
	0	7-11-23	AS CONSTRUCTED	
Rv	DATE	REVISIONS		APPR.


PSM No	OPM/42916
(AHD) RL	161.931
SURVEYED	Murray & Assoc. Pty Ltd



HAYNES CONSULTING ENGINEERS
 ABN 53 613 630 078
 PO BOX 549 NOOSA HEADS QLD 4667
 (0432) 784 150

MCINTOSH PARK STAGE 3-4
 Lots 1-10, 22-31, 40-43 on SP329986
 Surveyed by Murray and Associates Pty Ltd
AS CONSTRUCTED SURVEY LAYOUTS

1803-MP
Sheet No. - Revision No.
S34-S1 1

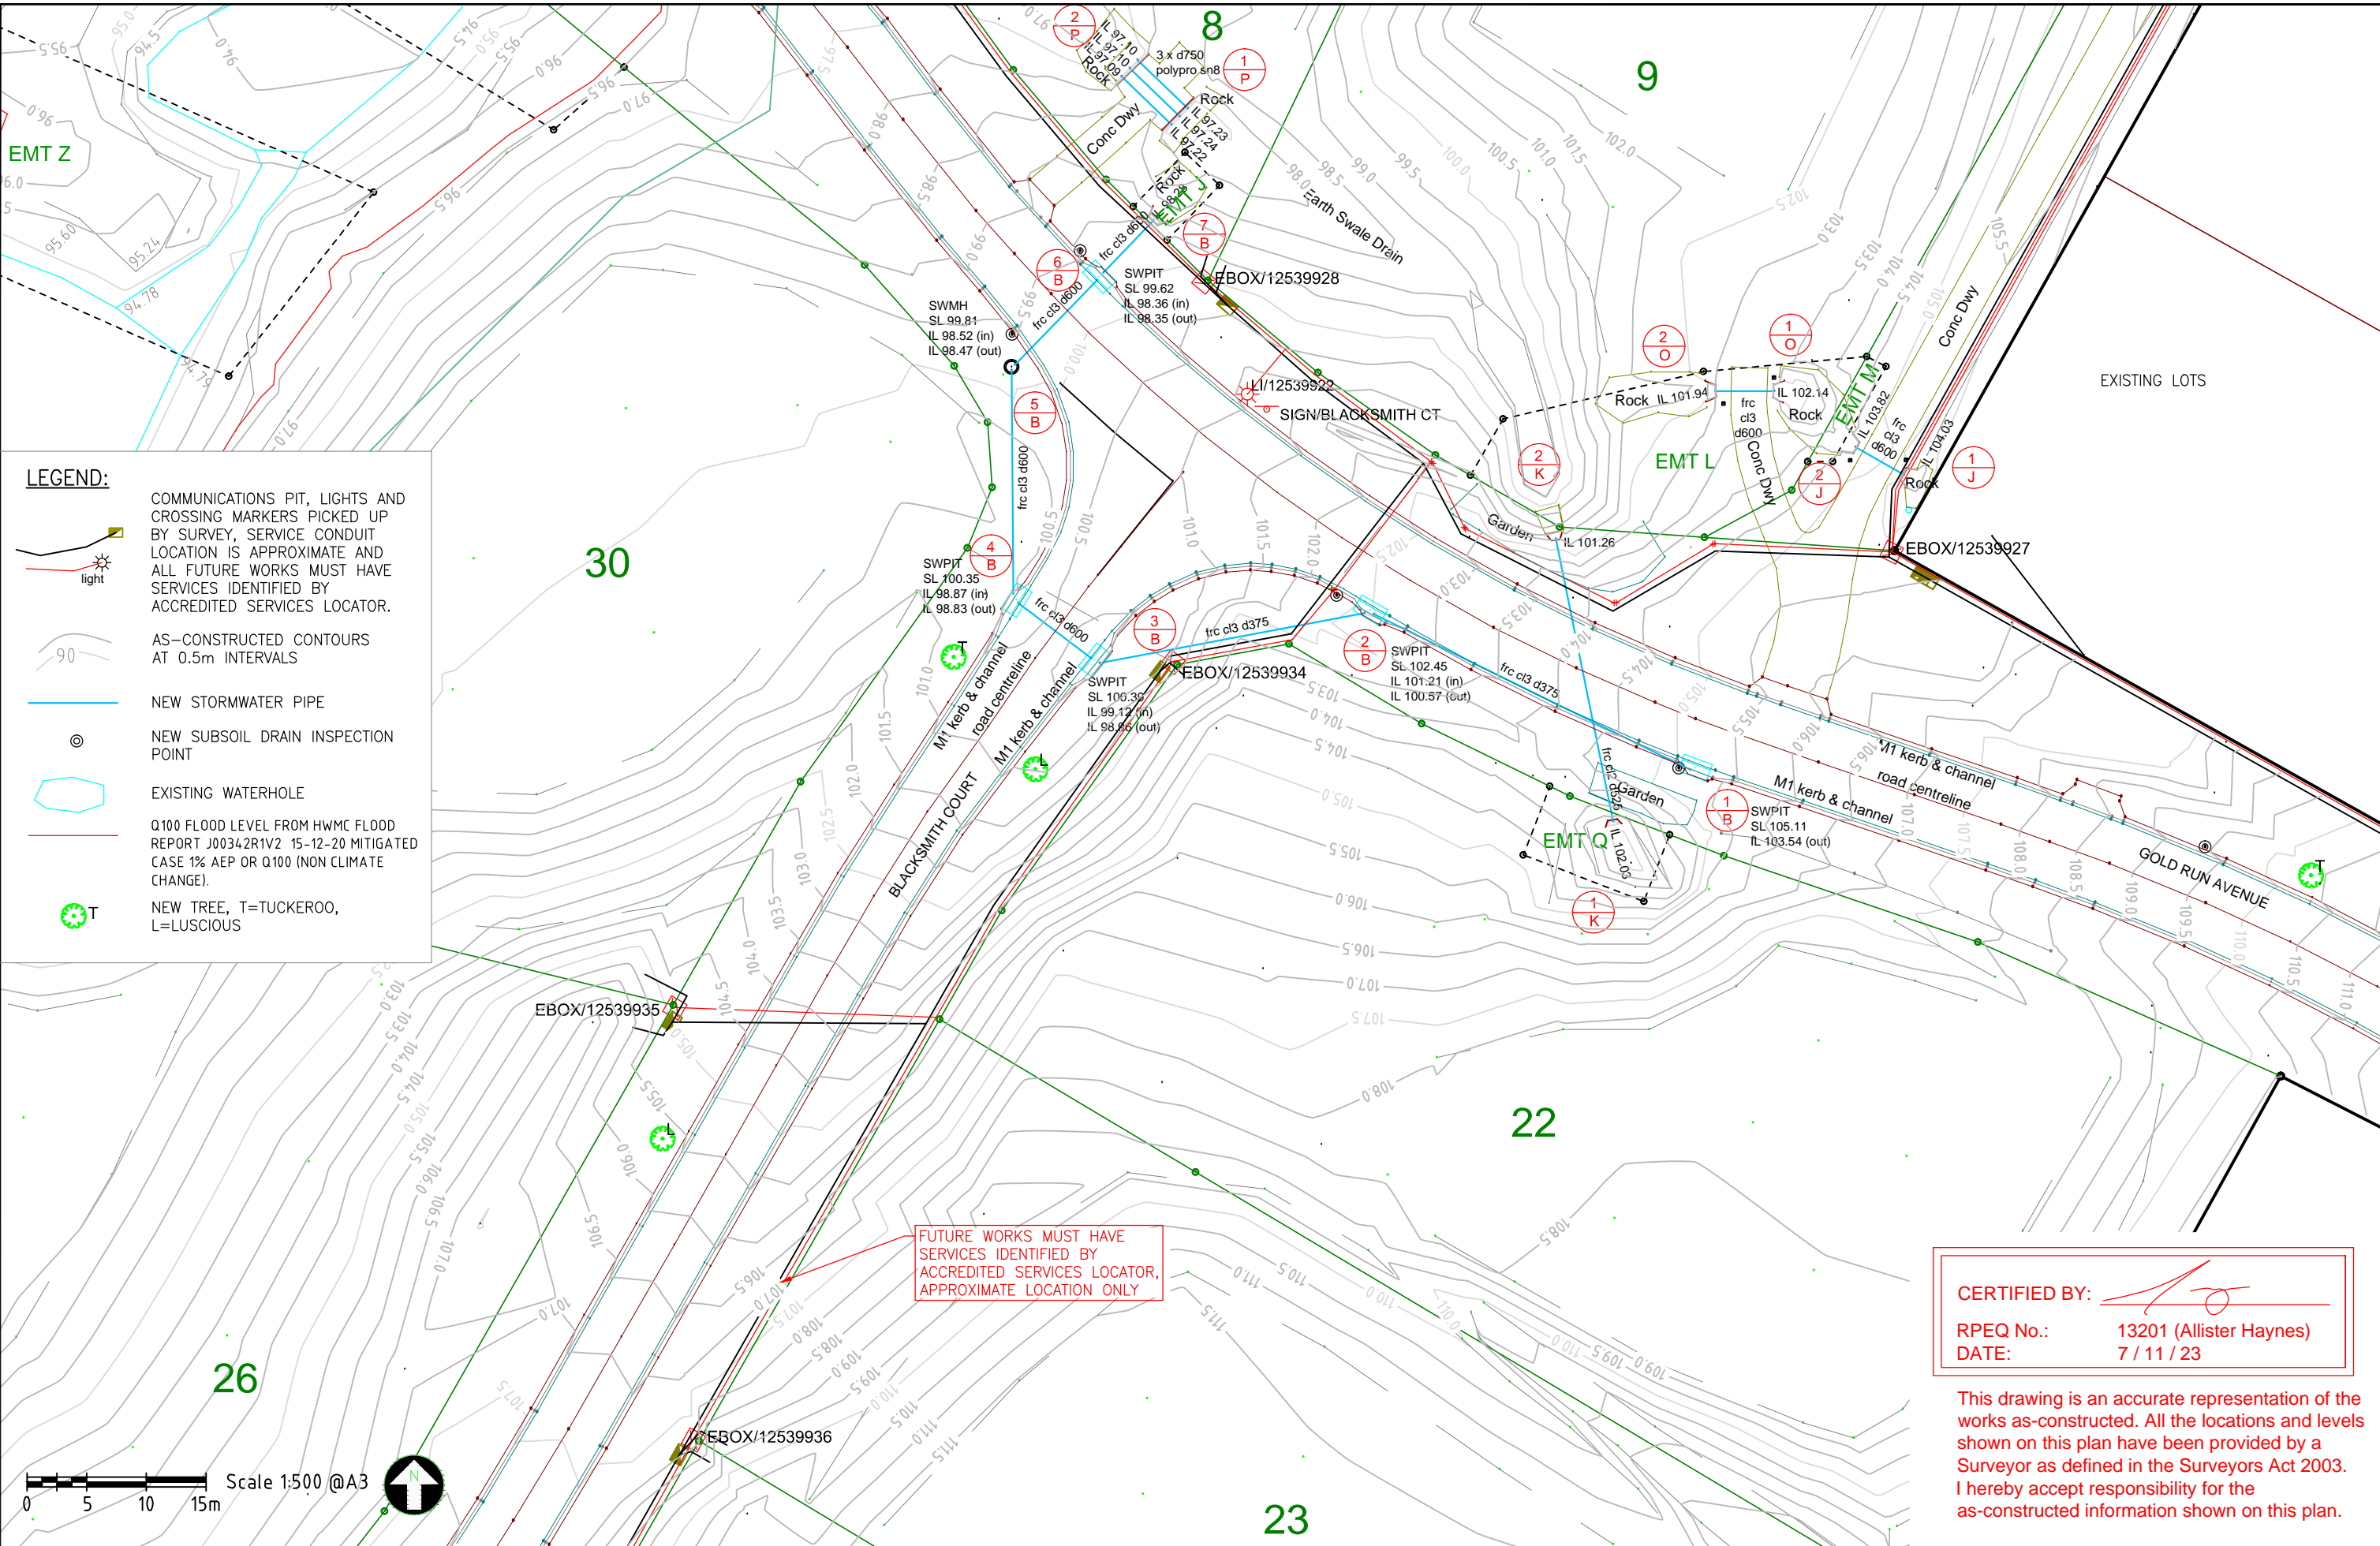

- LEGEND:**
- COMMUNICATIONS PIT, LIGHTS AND CROSSING MARKERS PICKED UP BY SURVEY, SERVICE CONDUIT LOCATION IS APPROXIMATE AND ALL FUTURE WORKS MUST HAVE SERVICES IDENTIFIED BY ACCREDITED SERVICES LOCATOR.
 - AS-CONSTRUCTED CONTOURS AT 0.5m INTERVALS
 - NEW STORMWATER PIPE
 - NEW SUBSOIL DRAIN INSPECTION POINT
 - EXISTING WATERHOLE
 - Q100 FLOOD LEVEL FROM HMC FLOOD REPORT J00342R1V2 15-12-20 MITIGATED CASE 1% AEP OR Q100 (NON CLIMATE CHANGE).
 - NEW TREE, T=TUCKEROO, L=LUSCIOUS

FUTURE WORKS MUST HAVE SERVICES IDENTIFIED BY ACCREDITED SERVICES LOCATOR, APPROXIMATE LOCATION ONLY

CERTIFIED BY:
RPEQ No.: 13201 (Allister Haynes)
DATE: 7 / 11 / 23

This drawing is an accurate representation of the works as-constructed. All the locations and levels shown on this plan have been provided by a Surveyor as defined in the Surveyors Act 2003. I hereby accept responsibility for the as-constructed information shown on this plan.

A3	1	21-11-23	AMEND TITLE BLOCK AS CONSTRUCTED	ATH ATH
	0	7-11-23		
Rv	DATE	REVISIONS	APPR.	

PSM No	OPM42916
(AHD) RL	161.931
SURVEYED	Murray & Assoc. Pty Ltd











HAYNES CONSULTING ENGINEERS
 ABN 53 613 630 078
 PO BOX 549 NOOSA HEADS QLD 4567
 (0432) 784 150

MCINTOSH PARK STAGE 3-4
 Lots 1-10, 22-31, 40-43 on SP329986
 Surveyed by Murray and Associates Pty Ltd
AS CONSTRUCTED SURVEY LAYOUTS

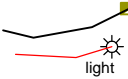
1803-MP
Sheet No. - Revision No.
S34-S2 1

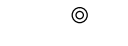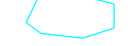LEGEND:

-  COMMUNICATIONS PIT, LIGHTS AND CROSSING MARKERS PICKED UP BY SURVEY, SERVICE CONDUIT LOCATION IS APPROXIMATE AND ALL FUTURE WORKS MUST HAVE SERVICES IDENTIFIED BY ACCREDITED SERVICES LOCATOR.
-  AS-CONSTRUCTED CONTOURS AT 0.5m INTERVALS
-  NEW STORMWATER PIPE
-  NEW SUBSOIL DRAIN INSPECTION POINT
-  EXISTING WATERHOLE
-  Q100 FLOOD LEVEL FROM HVMC FLOOD REPORT J00342RV2 15-12-20 MITIGATED CASE 1% AEP OR Q100 (NON CLIMATE CHANGE).
-  NEW TREE, T=TUCKEROO, L=LUSCIOUS

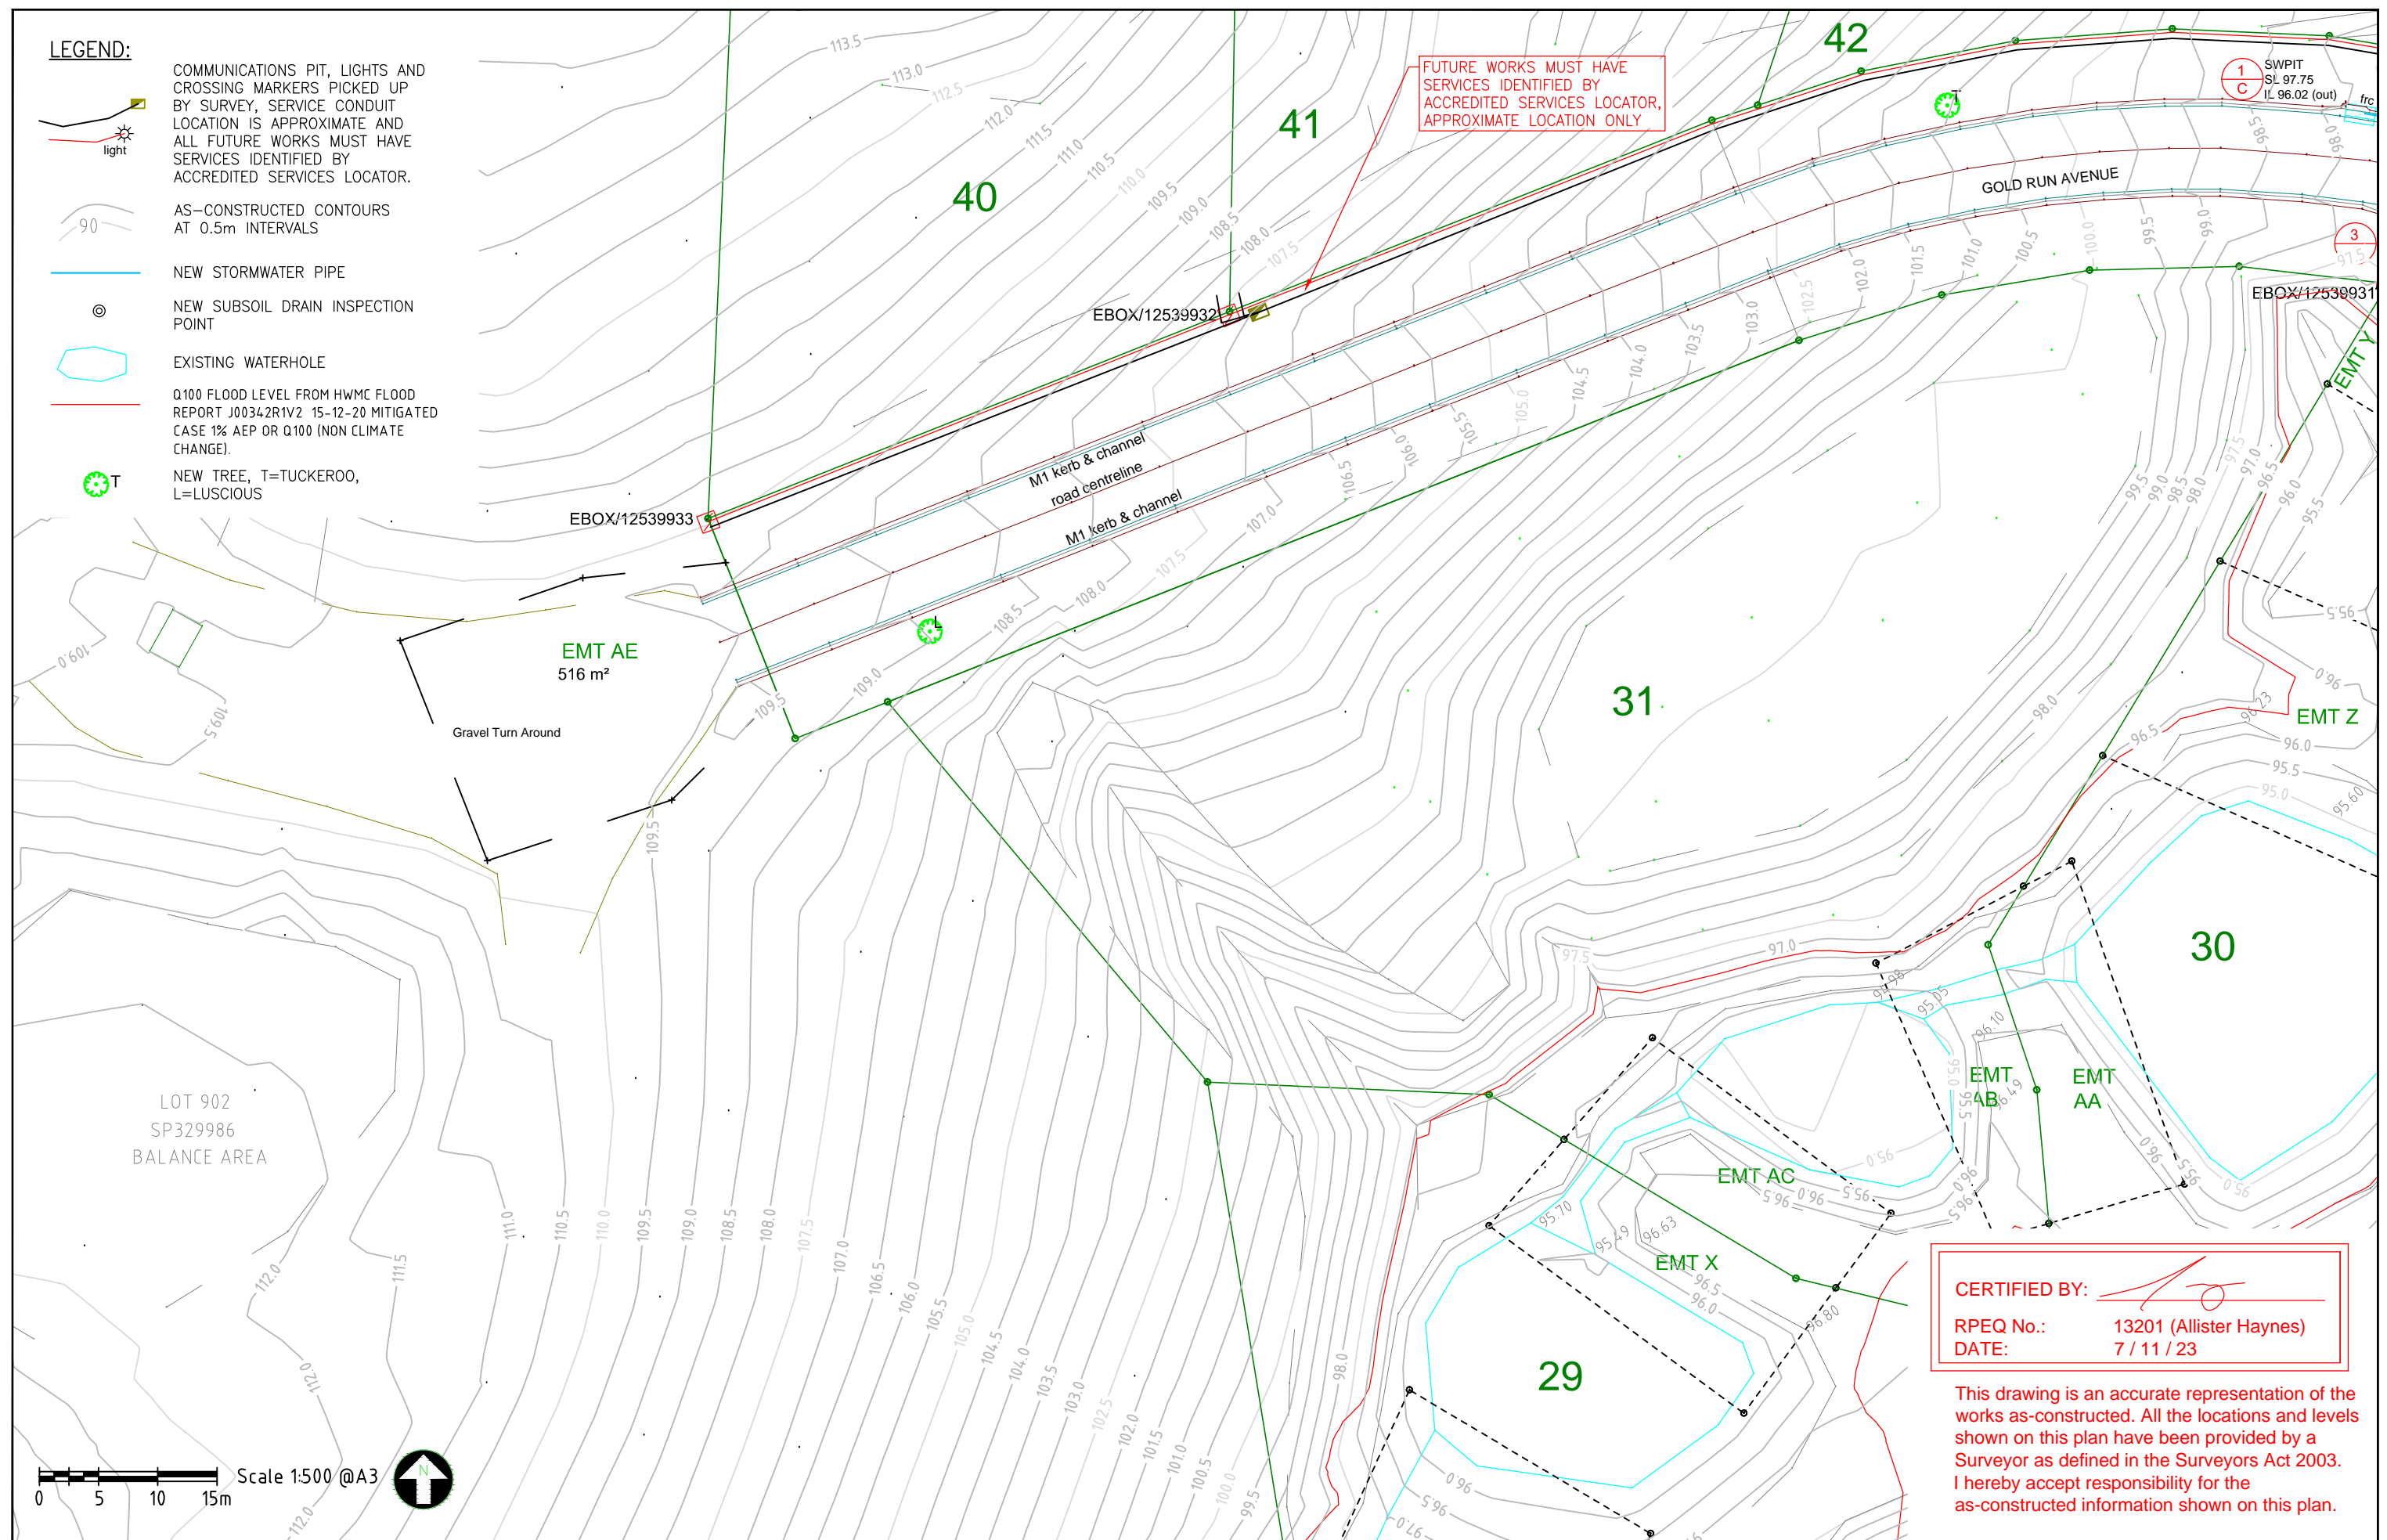

FUTURE WORKS MUST HAVE SERVICES IDENTIFIED BY ACCREDITED SERVICES LOCATOR, APPROXIMATE LOCATION ONLY

CERTIFIED BY: 
RPEQ No.: 13201 (Allister Haynes)
DATE: 7 / 11 / 23

This drawing is an accurate representation of the works as-constructed. All the locations and levels shown on this plan have been provided by a Surveyor as defined in the Surveyors Act 2003. I hereby accept responsibility for the as-constructed information shown on this plan.

A3	1	21-11-23	AMEND TITLE BLOCK	ATH ATH
	0	7-11-23	AS CONSTRUCTED	
Rv	DATE	REVISIONS	APPR.	

PSM No	OPM/42916
(AHD) RL	161.931
SURVEYED	Murray & Assoc. Pty Ltd










HAYNES CONSULTING ENGINEERS
 ABN 53 613 630 078
 PO BOX 549 NOOSA HEADS QLD 4567
 (0432) 784 150



MCINTOSH PARK STAGE 3-4
 Lots 1-10, 22-31, 40-43 on SP329986
 Surveyed by Murray and Associates Pty Ltd
AS CONSTRUCTED SURVEY LAYOUTS

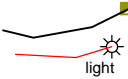1803-MP
Sheet No. - Revision No.
S34-S3 1

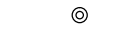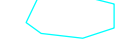
LEGEND:

-  light
-  AS-CONSTRUCTED CONTOURS AT 0.5m INTERVALS
-  NEW STORMWATER PIPE
-  NEW SUBSOIL DRAIN INSPECTION POINT
-  EXISTING WATERHOLE
-  Q100 FLOOD LEVEL FROM HVMC FLOOD REPORT J00342RV2 15-12-20 MITIGATED CASE 1% AEP OR Q100 (NON CLIMATE CHANGE).
-  NEW TREE, T=TUCKEROO, L=LUSCIOUS

Scale 1:500 @A3
0 5 10 15m

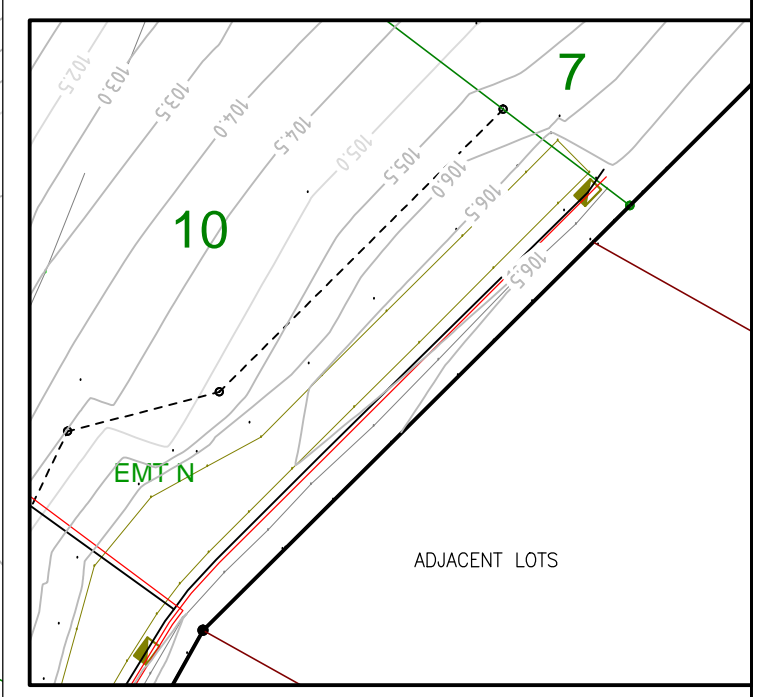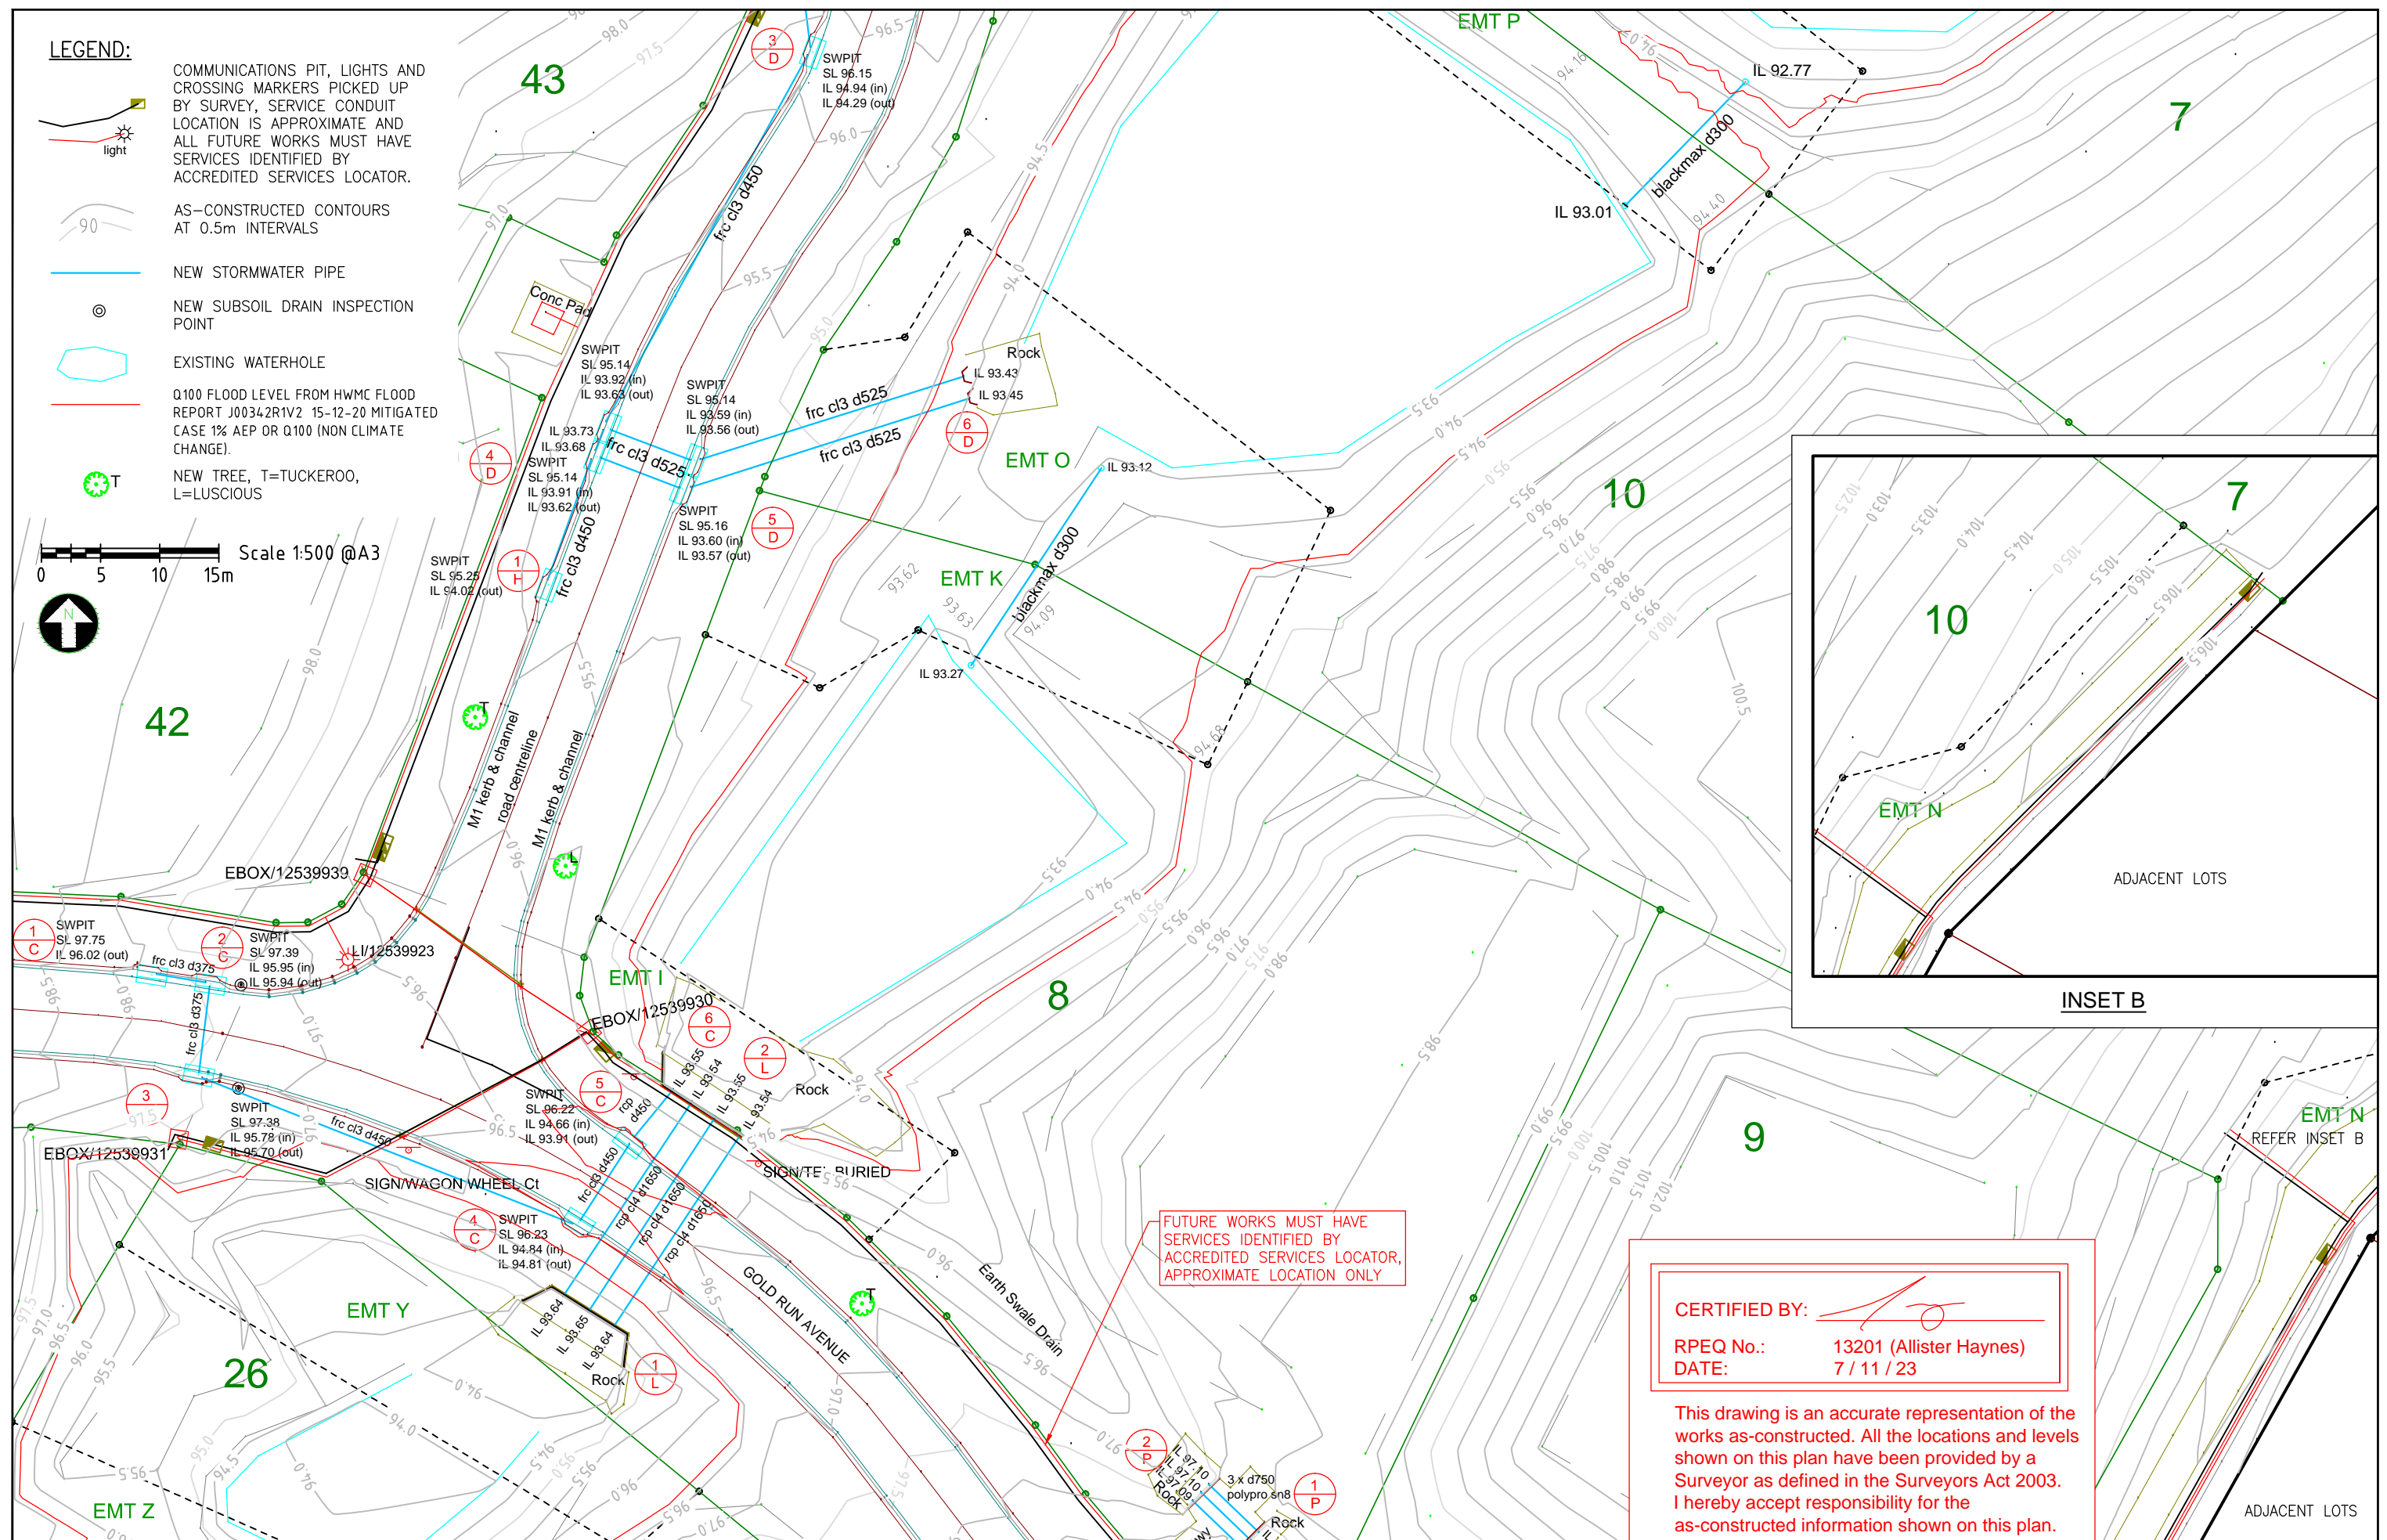

FUTURE WORKS MUST HAVE SERVICES IDENTIFIED BY ACCREDITED SERVICES LOCATOR, APPROXIMATE LOCATION ONLY

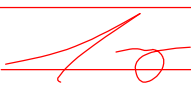CERTIFIED BY: 
RPEQ No.: 13201 (Allister Haynes)
DATE: 7 / 11 / 23

This drawing is an accurate representation of the works as-constructed. All the locations and levels shown on this plan have been provided by a Surveyor as defined in the Surveyors Act 2003. I hereby accept responsibility for the as-constructed information shown on this plan.

A3	1	21-11-23	AMEND TITLE BLOCK
	0	7-11-23	AS CONSTRUCTED
Rv	DATE	REVISIONS	APPR.


PSM No	OPM42916
(AHD) RL	161.931
SURVEYED	Murray & Assoc. Pty Ltd




HAYNES CONSULTING ENGINEERS
 ABN 53 613 630 078
 PO BOX 549 NOOSA HEADS QLD 4567
 (0432) 784 150

MCINTOSH PARK STAGE 3-4
 Lots 1-10, 22-31, 40-43 on SP329986
 Surveyed by Murray and Associates Pty Ltd
AS CONSTRUCTED SURVEY LAYOUTS




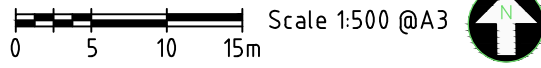

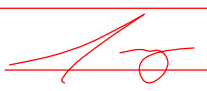

1803-MP
 Sheet No. - Revision No.
S34-S4 1

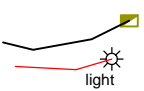


CERTIFIED BY: 
RPEQ No.: 13201 (Allister Haynes)
DATE: 7/11/23

This drawing is an accurate representation of the works as-constructed. All the locations and levels shown on this plan have been provided by a Surveyor as defined in the Surveyors Act 2003. I hereby accept responsibility for the as-constructed information shown on this plan.

FUTURE WORKS MUST HAVE SERVICES IDENTIFIED BY ACCREDITED SERVICES LOCATOR, APPROXIMATE LOCATION ONLY

- LEGEND:**
-  COMMUNICATIONS PIT, LIGHTS AND CROSSING MARKERS PICKED UP BY SURVEY, SERVICE CONDUIT LOCATION IS APPROXIMATE AND ALL FUTURE WORKS MUST HAVE SERVICES IDENTIFIED BY ACCREDITED SERVICES LOCATOR.
 -  AS-CONSTRUCTED CONTOURS AT 0.5m INTERVALS
 -  NEW STORMWATER PIPE
 -  NEW SUBSOIL DRAIN INSPECTION POINT
 -  EXISTING WATERHOLE
 -  Q100 FLOOD LEVEL FROM HVMC FLOOD REPORT J0034.2R1V2 15-12-20 MITIGATED CASE 1% AEP OR Q100 (NON CLIMATE CHANGE).
 -  NEW TREE, T=TUCKEROO, L=LUSCIOUS

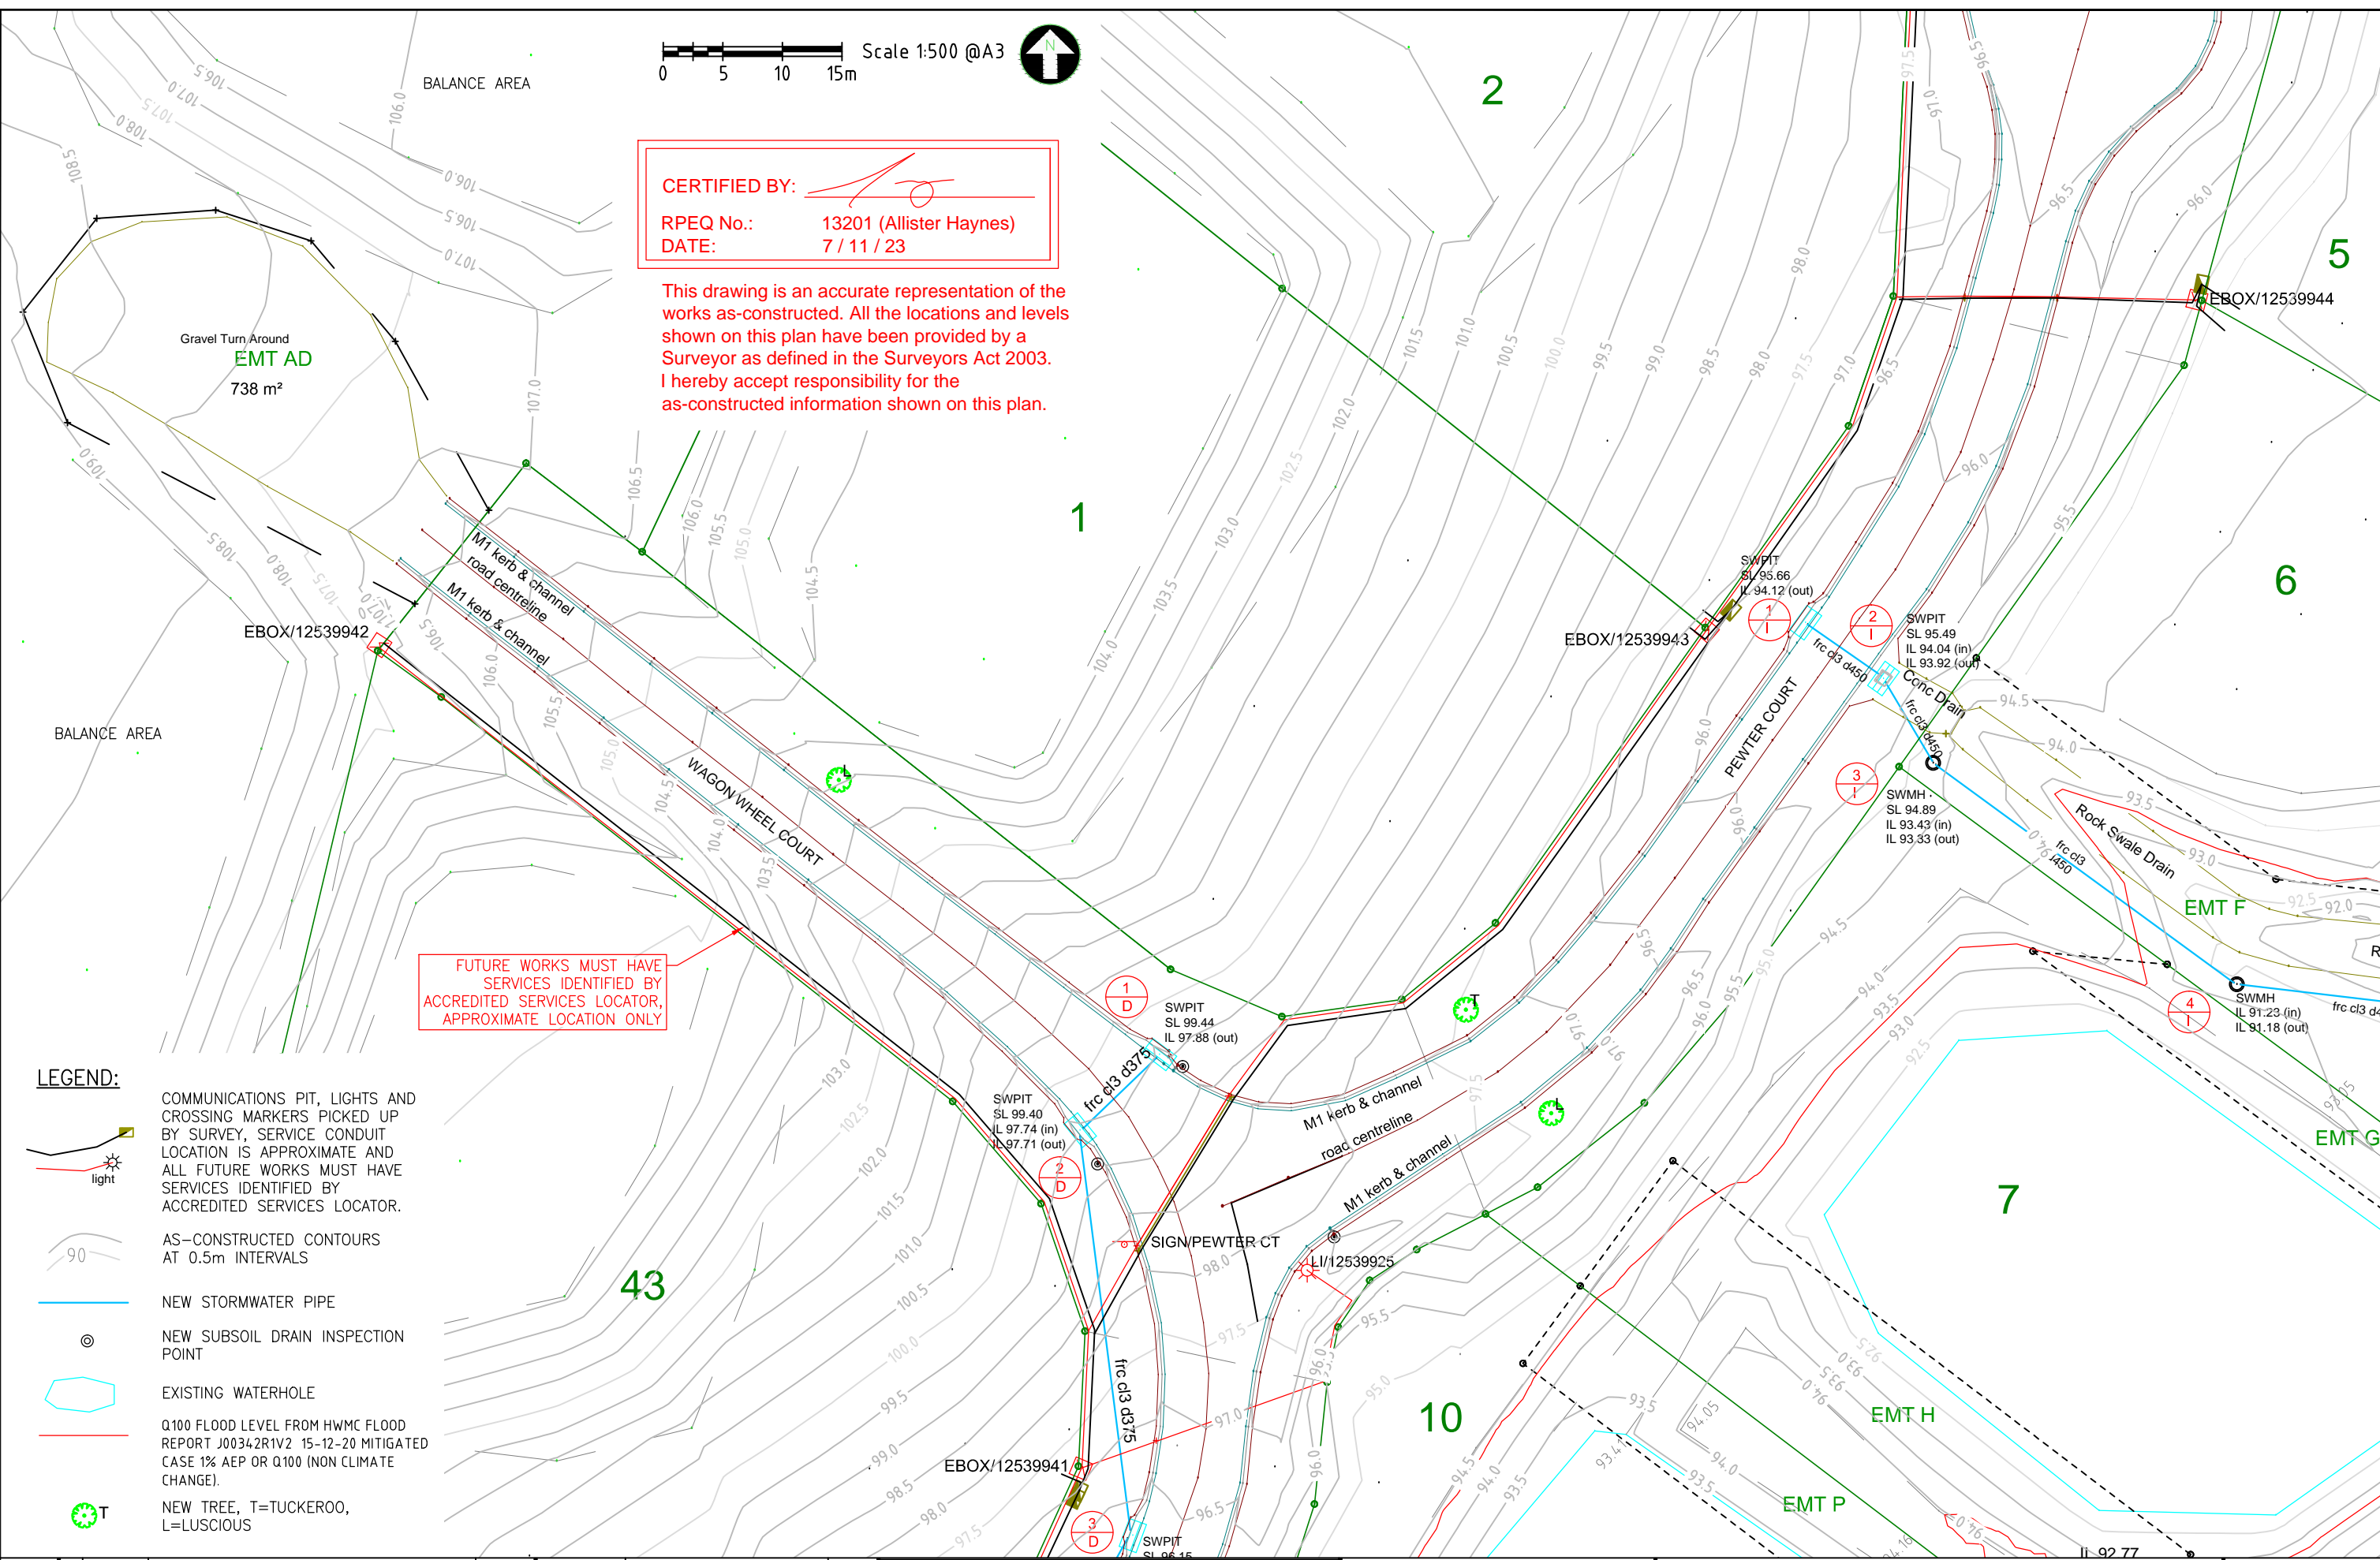

A3	1	21-11-23	AMEND TITLE BLOCK	ATH	PSM No	OPM42916
	0	7-11-23	AS CONSTRUCTED	ATH	(AHD) RL	161.931
Rv	DATE	REVISIONS	APPR.		SURVEYED	Murray & Assoc. Pty Ltd

ATH	PSM No	OPM42916
ATH	(AHD) RL	161.931
APPR.	SURVEYED	Murray & Assoc. Pty Ltd



HAYNES CONSULTING ENGINEERS


HAYNES CONSULTING ENGINEERS
 ABN 53 613 630 078
 PO BOX 549 NOOSA HEADS QLD 4667
 (0432) 784 150

MCINTOSH PARK STAGE 3-4
 Lots 1-10, 22-31, 40-43 on SP329986
 Surveyed by Murray and Associates Pty Ltd
AS CONSTRUCTED SURVEY LAYOUTS

1803-MP
 Sheet No. - Revision No.
S34-S5 1






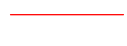

Scale 1:500 @A3
0 5 10 15m




CERTIFIED BY: 
RPEQ No.: 13201 (Allister Haynes)
DATE: 7 / 11 / 23

This drawing is an accurate representation of the works as-constructed. All the locations and levels shown on this plan have been provided by a Surveyor as defined in the Surveyors Act 2003. I hereby accept responsibility for the as-constructed information shown on this plan.


LEGEND:

-  COMMUNICATIONS PIT, LIGHTS AND CROSSING MARKERS PICKED UP BY SURVEY, SERVICE CONDUIT LOCATION IS APPROXIMATE AND ALL FUTURE WORKS MUST HAVE SERVICES IDENTIFIED BY ACCREDITED SERVICES LOCATOR.
-  AS-CONSTRUCTED CONTOURS AT 0.5m INTERVALS
-  NEW STORMWATER PIPE
-  NEW SUBSOIL DRAIN INSPECTION POINT
-  EXISTING WATERHOLE
-  Q100 FLOOD LEVEL FROM HMC FLOOD REPORT J00342R1V2 15-12-20 MITIGATED CASE 1% AEP OR Q100 (NON CLIMATE CHANGE).
-  NEW TREE, T=TUCKEROO, L=LUSCIUS

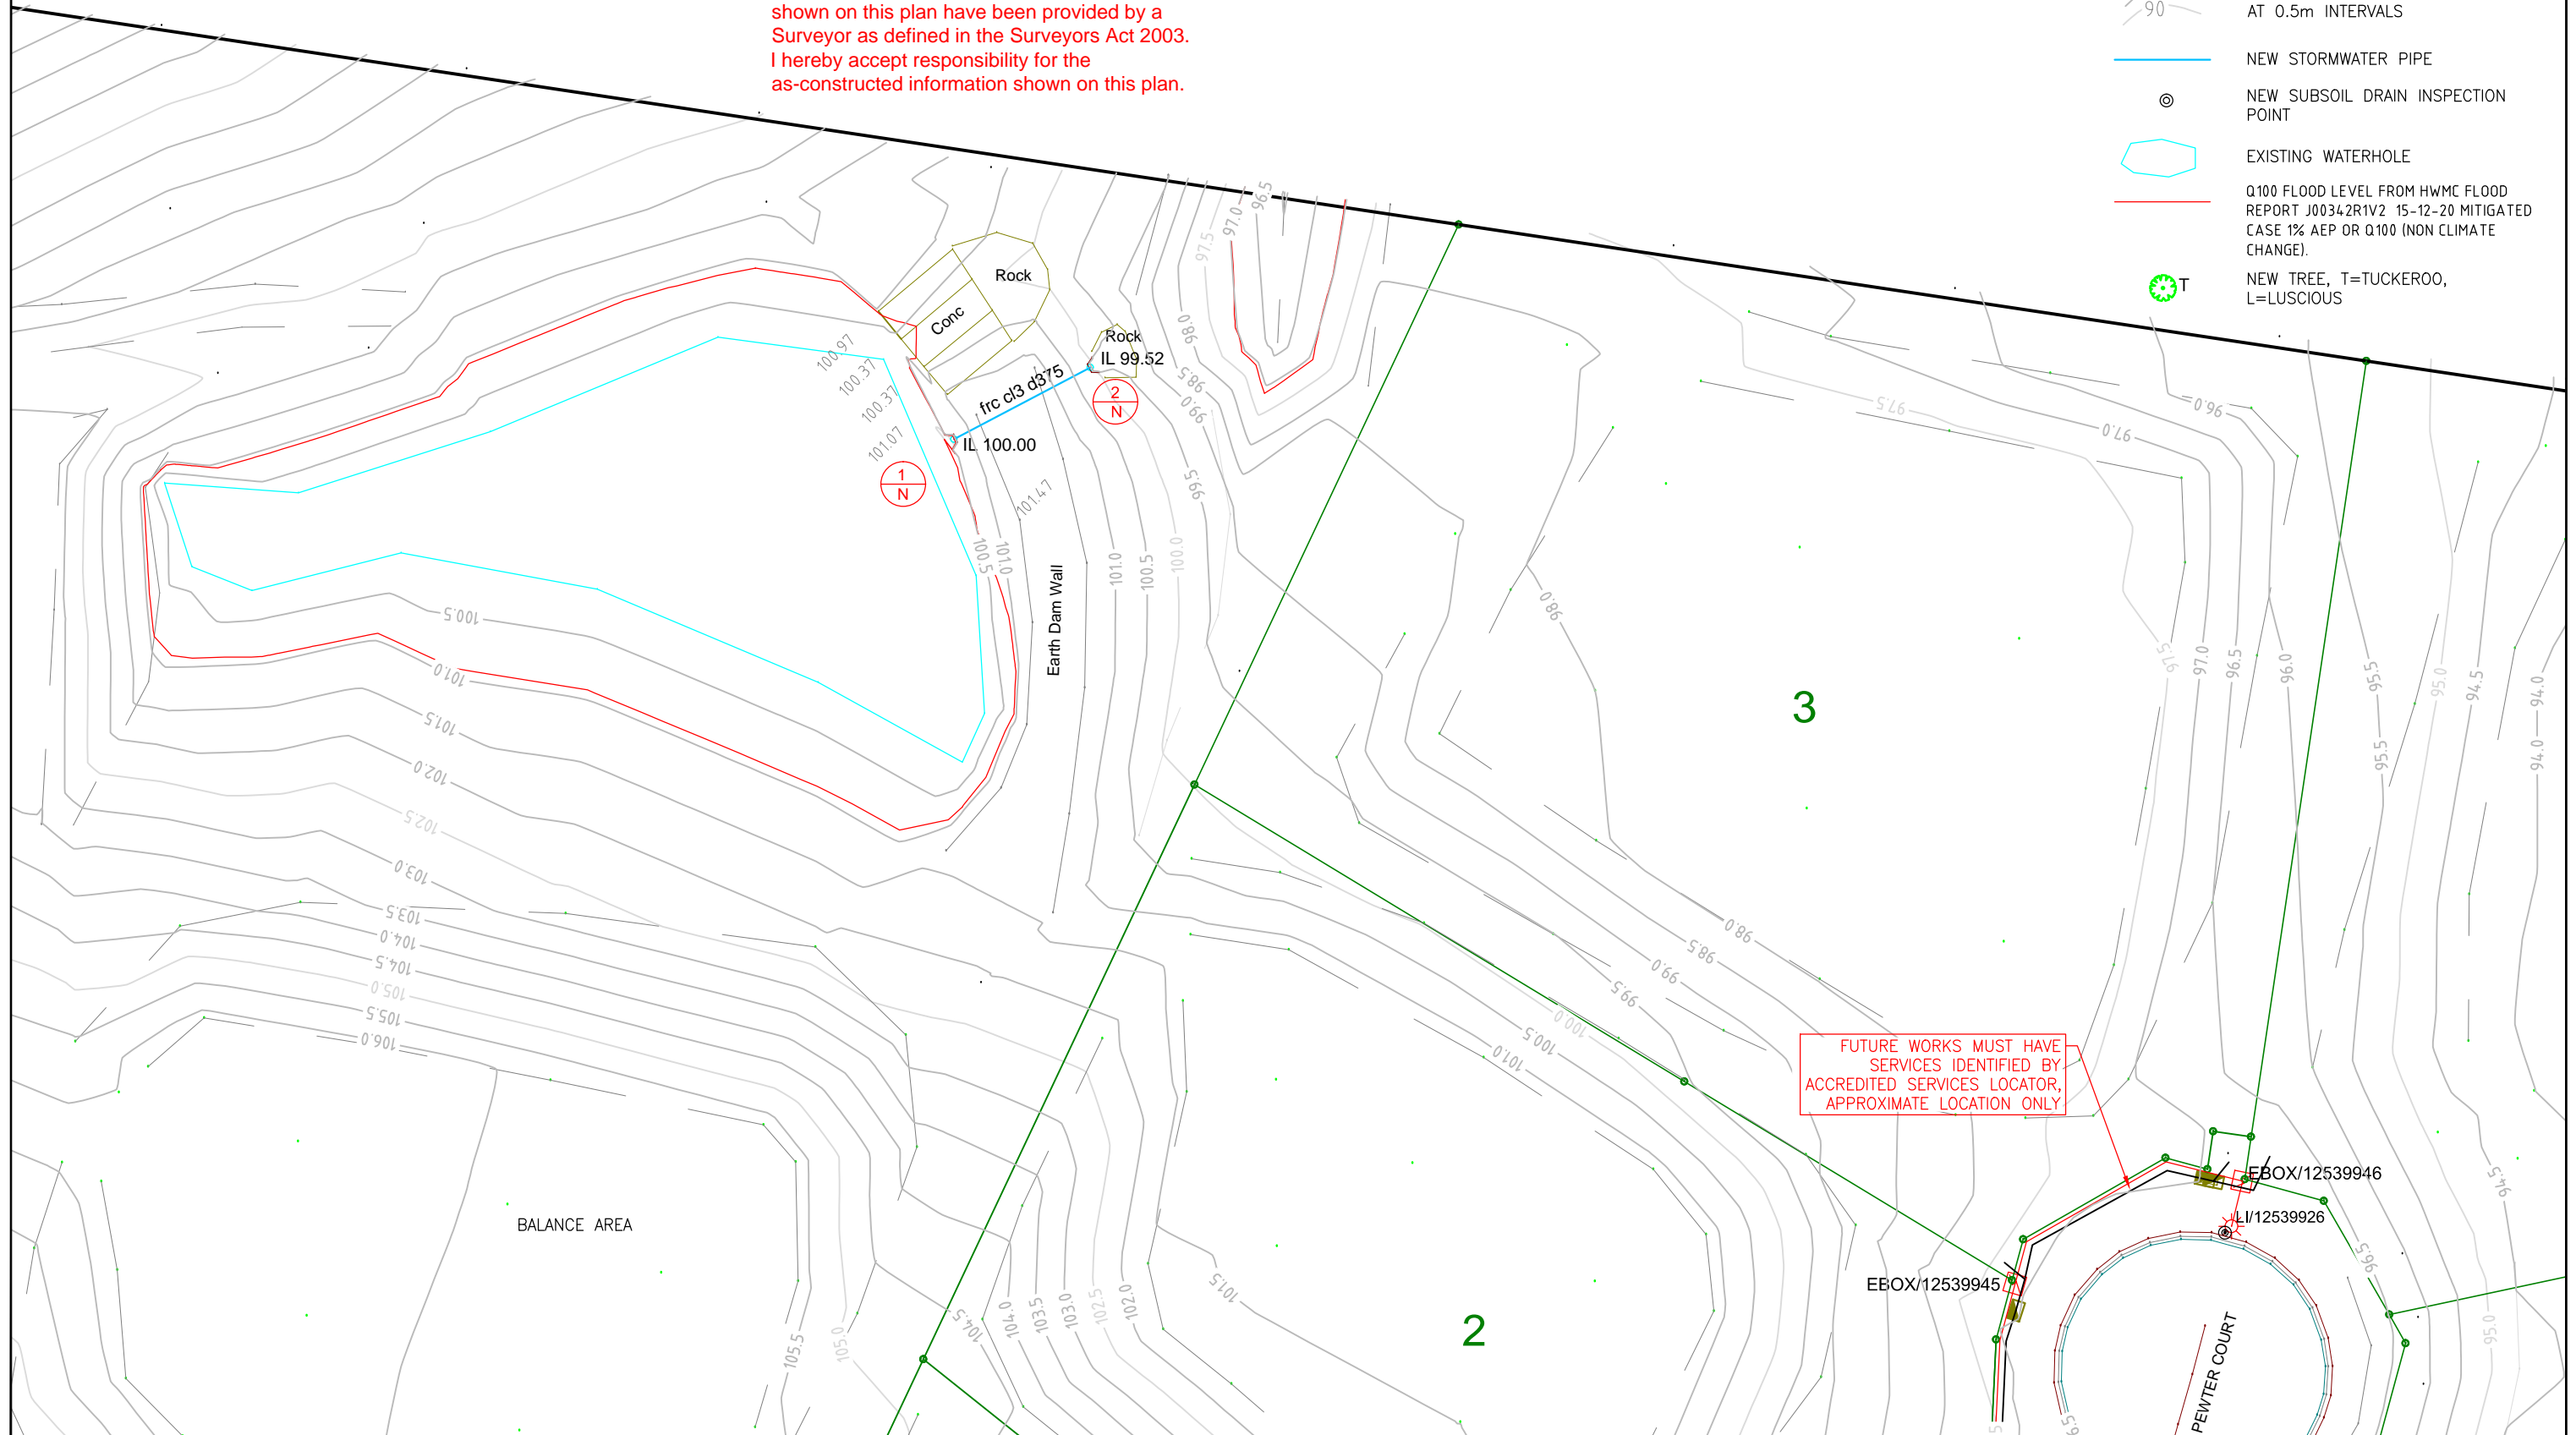

A3	1	21-11-23	AMEND TITLE BLOCK	ATH
	0	7-11-23	AS CONSTRUCTED	
	Rv	DATE	REVISIONS	APPR.



PSM No	OPM/42916
(AHD) RL	161.931
SURVEYED	Murray & Assoc. Pty Ltd

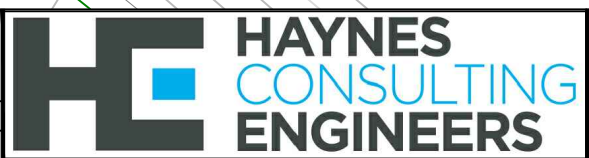


HAYNES CONSULTING ENGINEERS
 ABN 53 613 630 078
 PO BOX 549 NOOSA HEADS QLD 4567
 (0432) 784 150

MCINTOSH PARK STAGE 3-4
 Lots 1-10, 22-31, 40-43 on SP329986
 Surveyed by Murray and Associates Pty Ltd
AS CONSTRUCTED SURVEY LAYOUTS

1803-MP
 Sheet No. - Revision No.
S34-S6 1

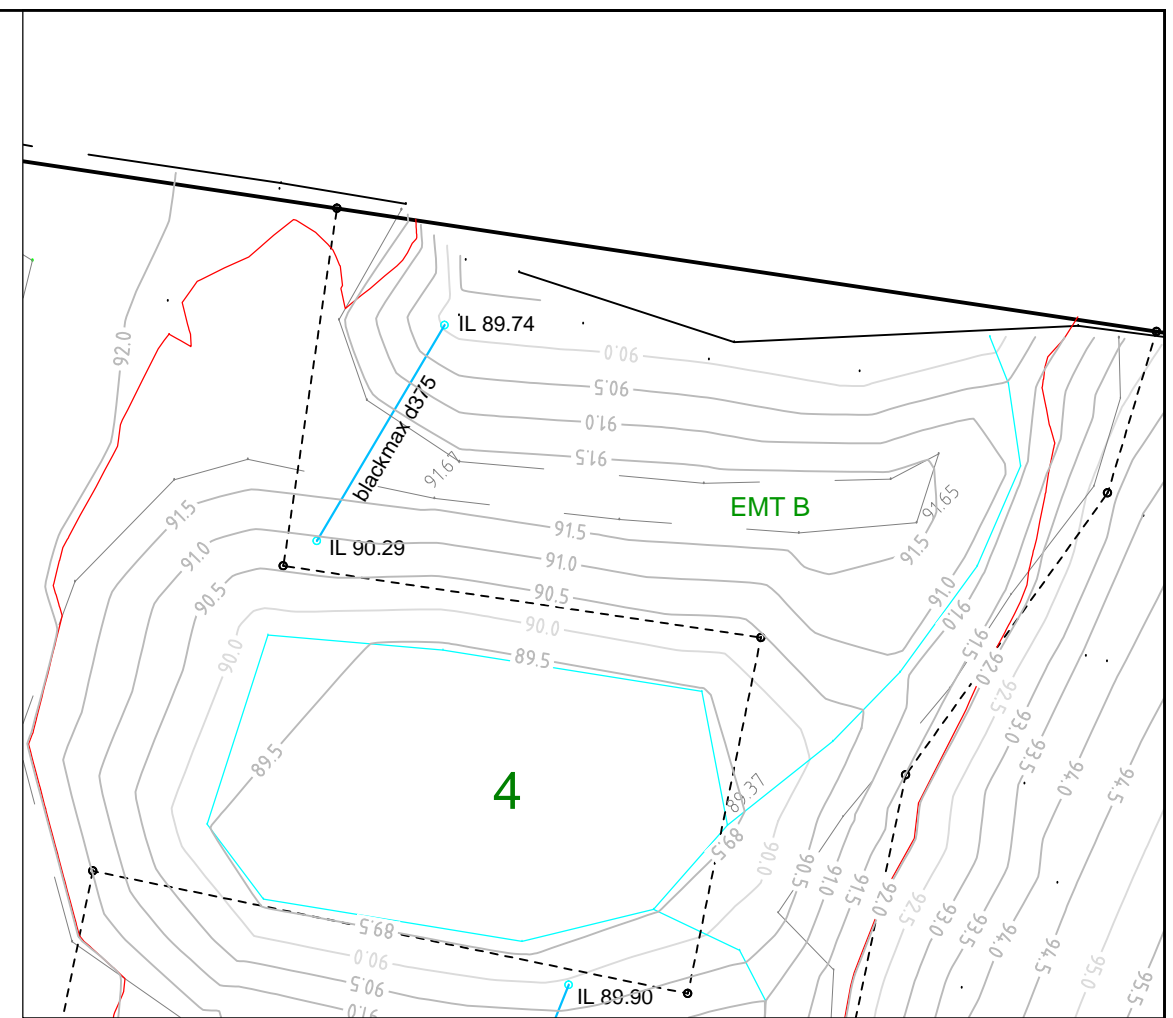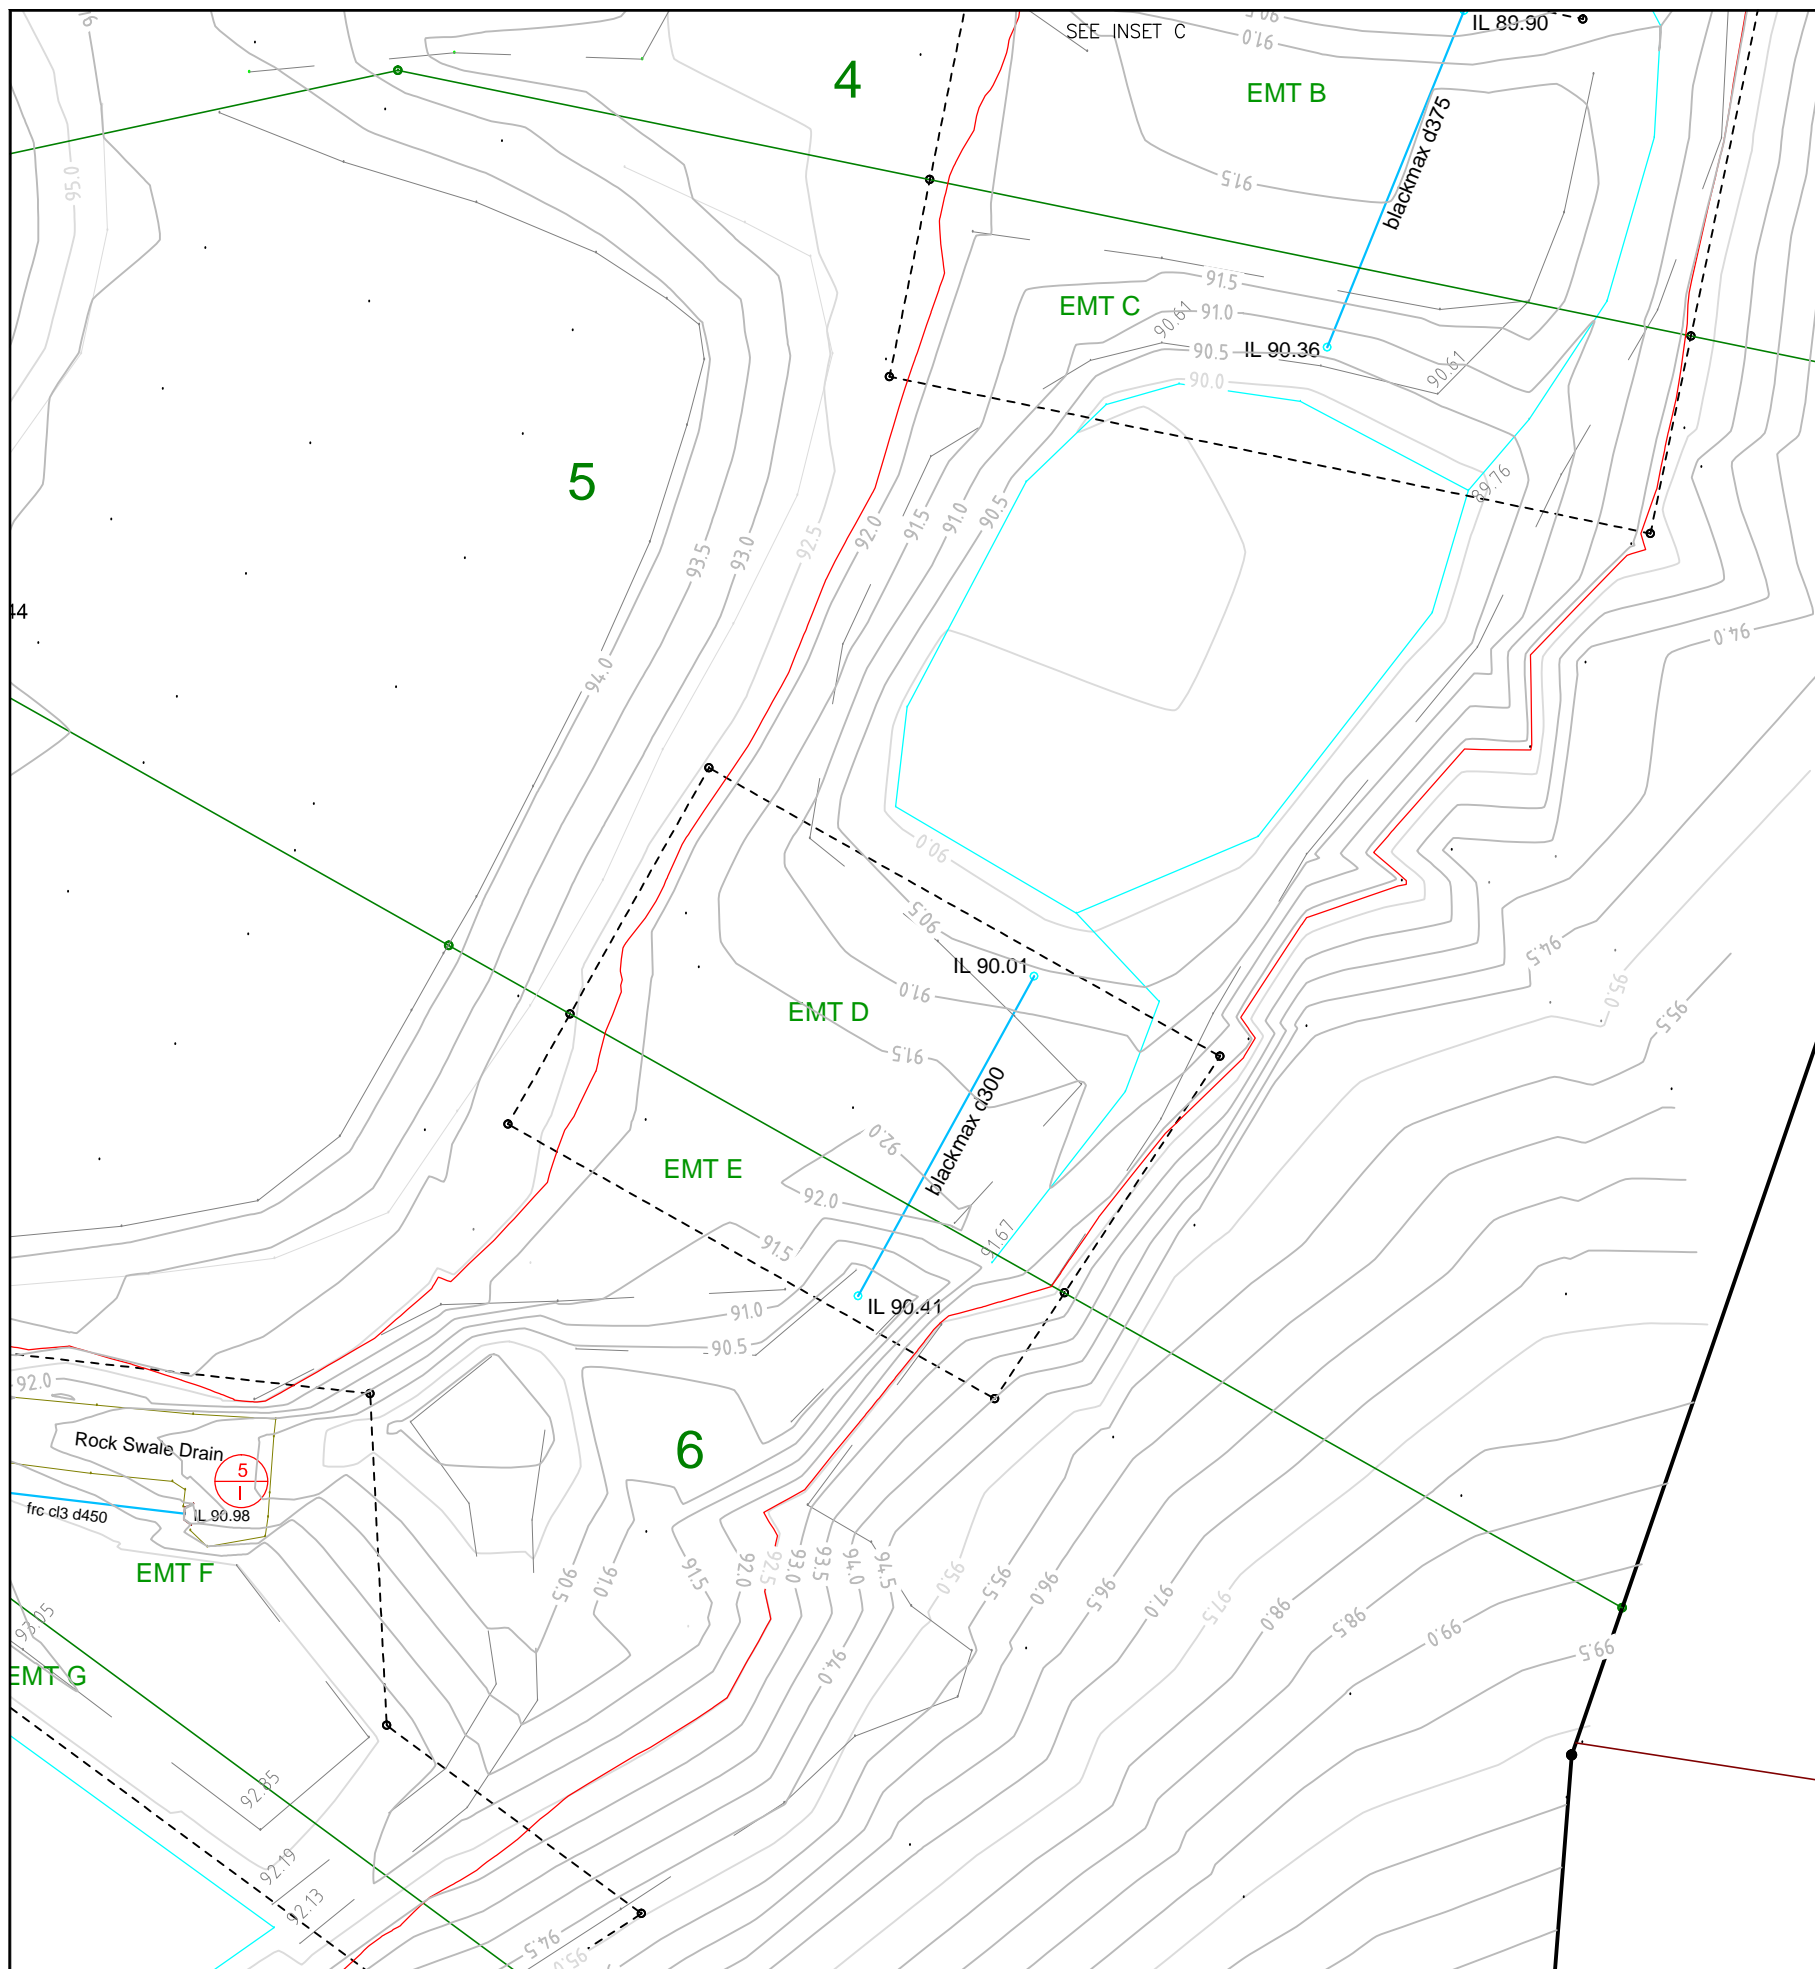



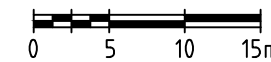




INSET C




Scale 1:500 @A3



LEGEND:


-  COMMUNICATIONS PIT, LIGHTS AND CROSSING MARKERS PICKED UP BY SURVEY, SERVICE CONDUIT LOCATION IS APPROXIMATE AND ALL FUTURE WORKS MUST HAVE SERVICES IDENTIFIED BY ACCREDITED SERVICES LOCATOR.
-  AS-CONSTRUCTED CONTOURS AT 0.5m INTERVALS
-  NEW STORMWATER PIPE
-  NEW SUBSOIL DRAIN INSPECTION POINT
-  EXISTING WATERHOLE
-  Q100 FLOOD LEVEL FROM Hwmc FLOOD REPORT J00342R1V2 15-12-20 MITIGATED CASE 1% AEP OR Q100 (NON CLIMATE CHANGE).
-  NEW TREE, T=TUCKEROO, L=LUSCIOUS

CERTIFIED BY: 
RPEQ No.: 13201 (Allister Haynes)
DATE: 7 / 11 / 23

This drawing is an accurate representation of the works as-constructed. All the locations and levels shown on this plan have been provided by a Surveyor as defined in the Surveyors Act 2003. I hereby accept responsibility for the as-constructed information shown on this plan.

A3	1	21-11-23	AMEND TITLE BLOCK	ATH
	0	7-11-23	AS CONSTRUCTED	
Rv	DATE	REVISIONS		APPR.

PSM No	OPM/42916
(AHD) RL	161.931
SURVEYED	Murray & Assoc. Pty Ltd

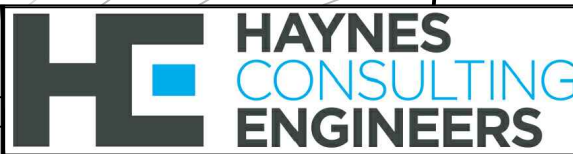

HAYNES CONSULTING ENGINEERS
 ABN 53 613 630 078
 PO BOX 549 NOOSA HEADS QLD 4567
 (0432) 784 150


MCINTOSH PARK STAGE 3-4
 Lots 1-10, 22-31, 40-43 on SP329986
 Surveyed by Murray and Associates Pty Ltd
AS CONSTRUCTED SURVEY LAYOUTS

1803-MP
 Sheet No. - Revision No.
S34-S7 1

Scale 1:500 @A3
0 5 10 15m








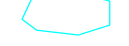
 



FUTURE WORKS MUST HAVE SERVICES IDENTIFIED BY ACCREDITED SERVICES LOCATOR, APPROXIMATE LOCATION ONLY

CERTIFIED BY: 
RPEQ No.: 13201 (Allister Haynes)
DATE: 7 / 11 / 23

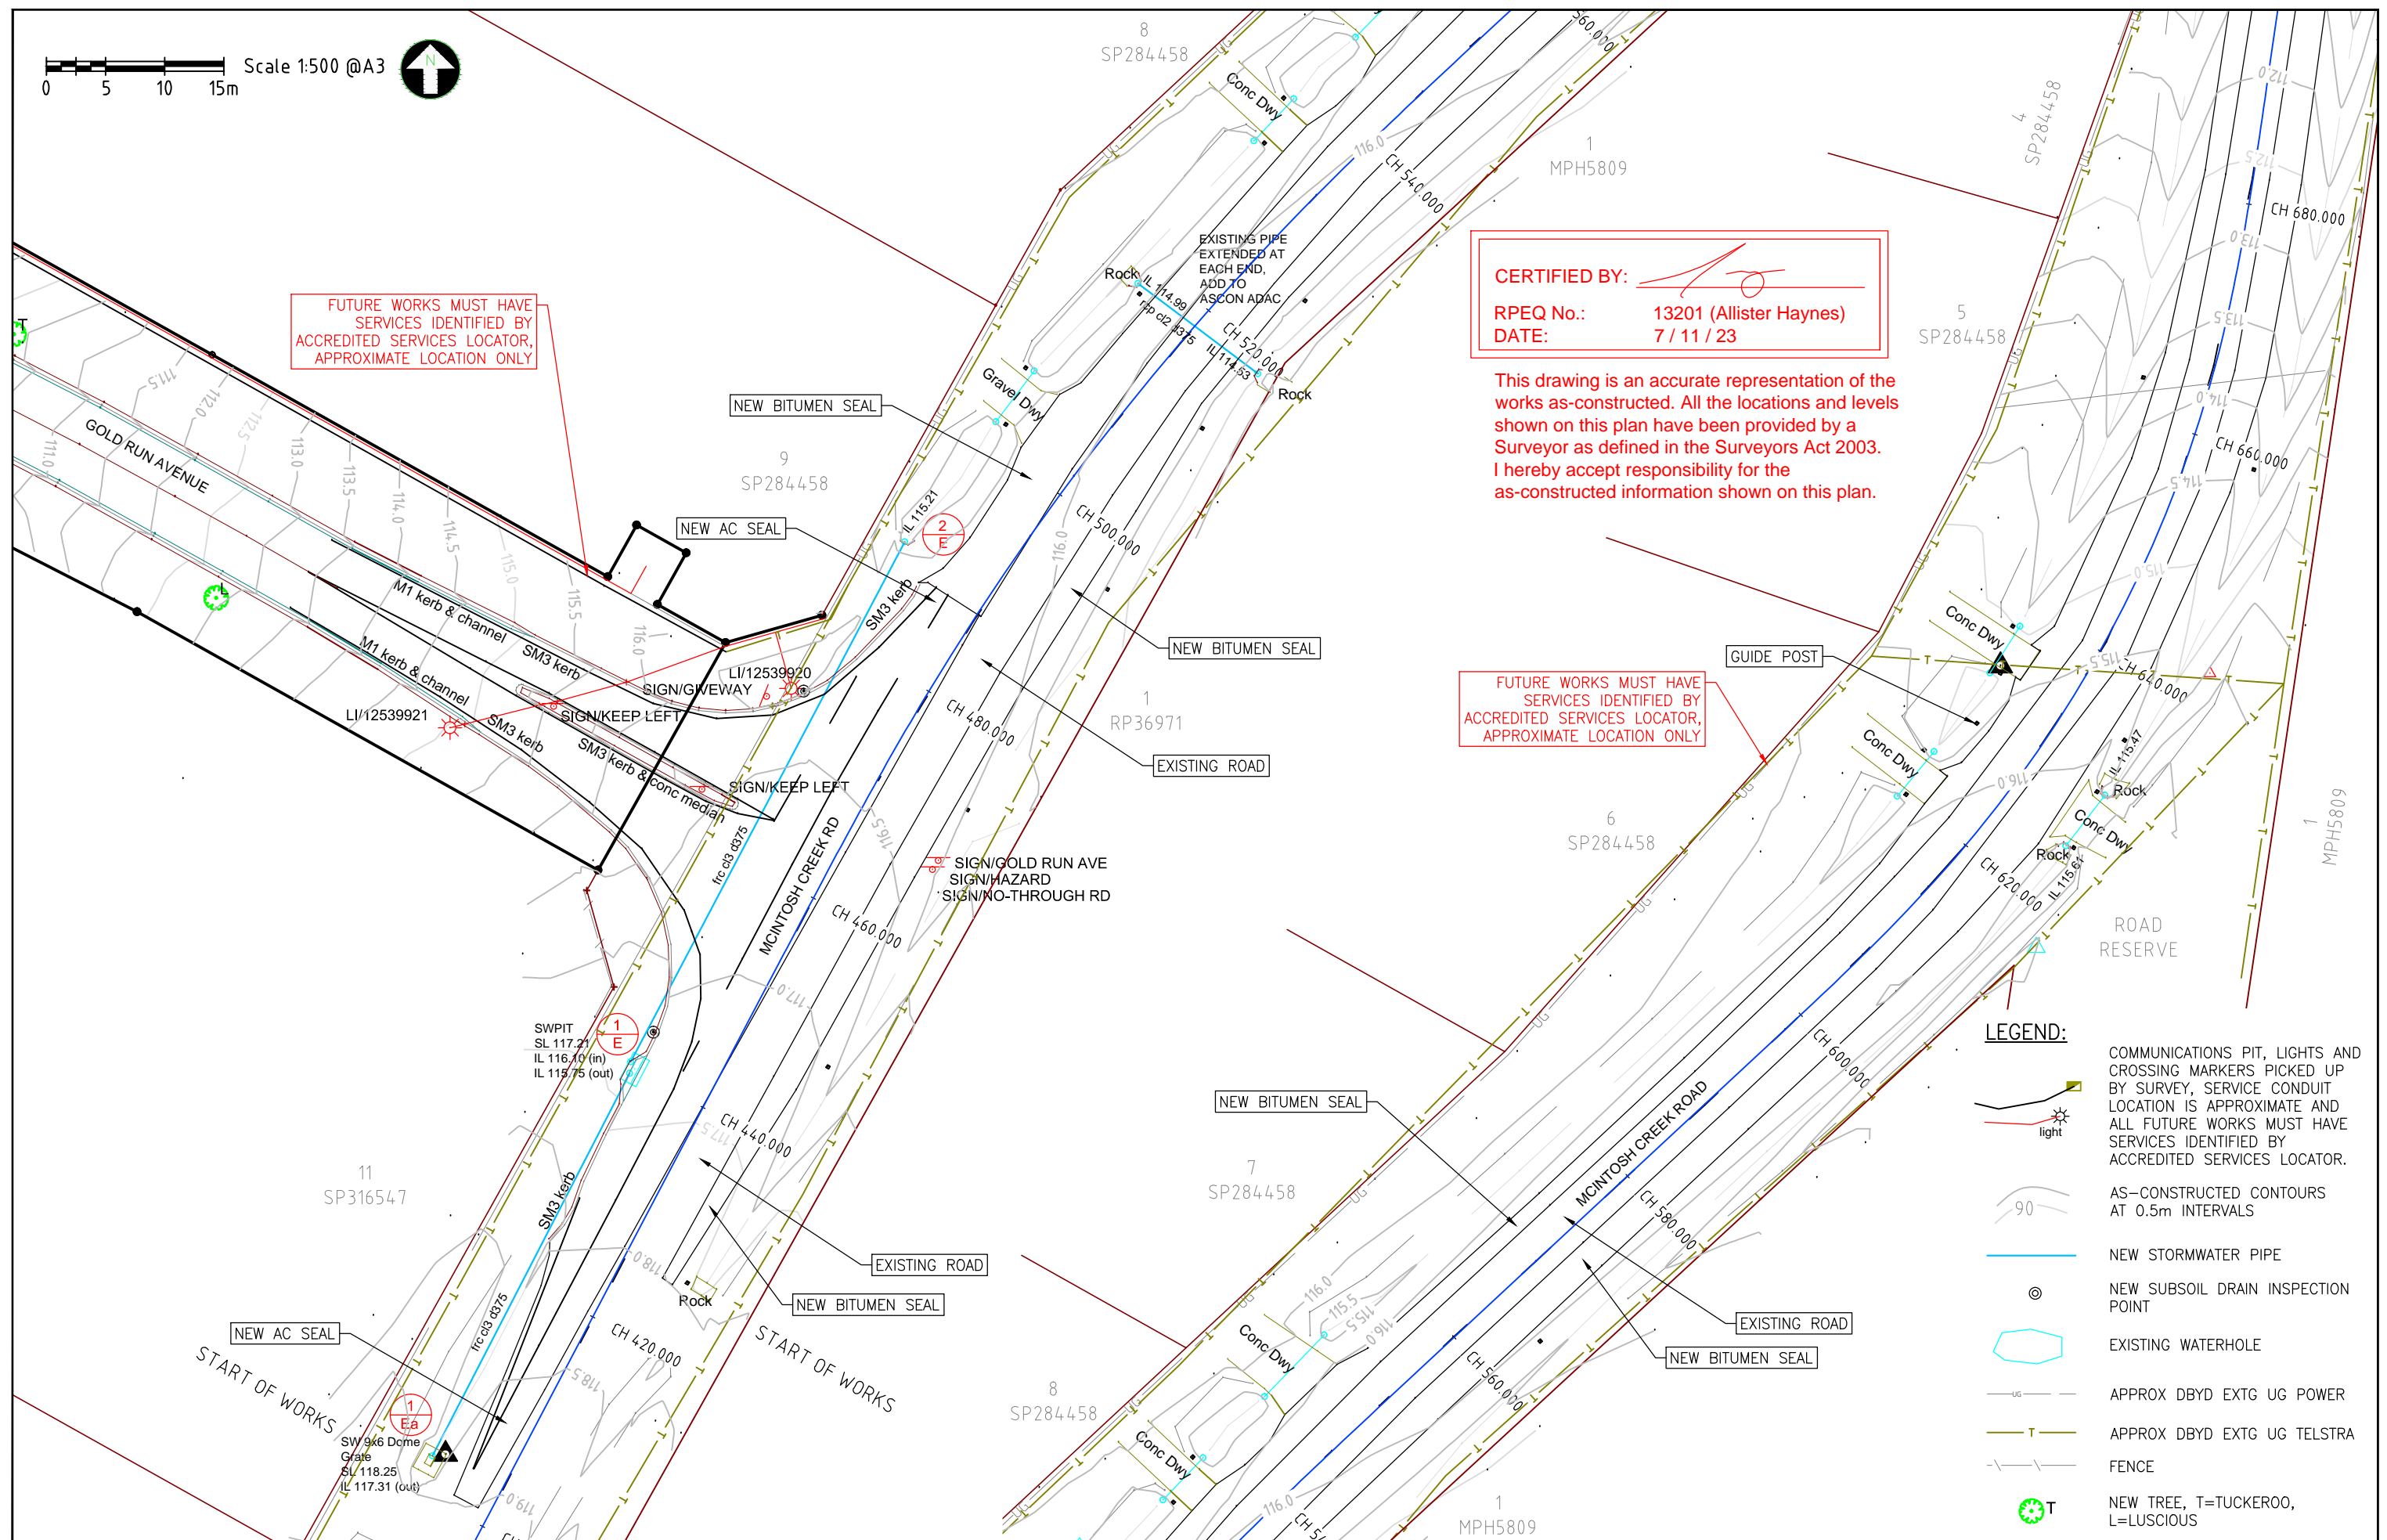This drawing is an accurate representation of the works as-constructed. All the locations and levels shown on this plan have been provided by a Surveyor as defined in the Surveyors Act 2003. I hereby accept responsibility for the as-constructed information shown on this plan.

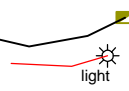
FUTURE WORKS MUST HAVE SERVICES IDENTIFIED BY ACCREDITED SERVICES LOCATOR, APPROXIMATE LOCATION ONLY



- LEGEND:**
-  COMMUNICATIONS PIT, LIGHTS AND CROSSING MARKERS PICKED UP BY SURVEY, SERVICE CONDUIT LOCATION IS APPROXIMATE AND ALL FUTURE WORKS MUST HAVE SERVICES IDENTIFIED BY ACCREDITED SERVICES LOCATOR.
 -  AS-CONSTRUCTED CONTOURS AT 0.5m INTERVALS
 -  NEW STORMWATER PIPE
 -  NEW SUBSOIL DRAIN INSPECTION POINT
 -  EXISTING WATERHOLE
 -  APPROX DBYD EXTG UG POWER
 -  APPROX DBYD EXTG UG TELSTRA
 -  FENCE
 -  NEW TREE, T=TUCKEROO, L=LUSCIOUS

A3	1	21-11-23	AMEND TITLE BLOCK	ATH	PSM No	OPM42916
	0	7-11-23	AS CONSTRUCTED	ATH	(AHD) RL	161.931
Rv	DATE	REVISIONS	APPR.		SURVEYED	Murray & Assoc. Pty Ltd


ATH	PSM No	OPM42916
ATH	(AHD) RL	161.931
APPR.	SURVEYED	Murray & Assoc. Pty Ltd

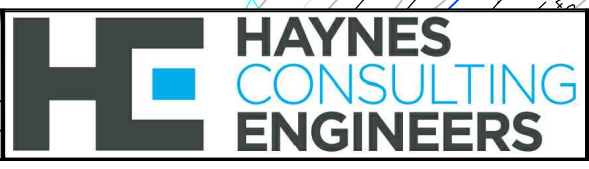


HAYNES CONSULTING ENGINEERS
ABN 53 613 630 078
PO BOX 549 NOOSA HEADS QLD 4567
(0432) 784 150


MCINTOSH PARK STAGE 3-4
Lots 1-10, 22-31, 40-43 on SP329986
Surveyed by Murray and Associates Pty Ltd
AS CONSTRUCTED SURVEY LAYOUTS




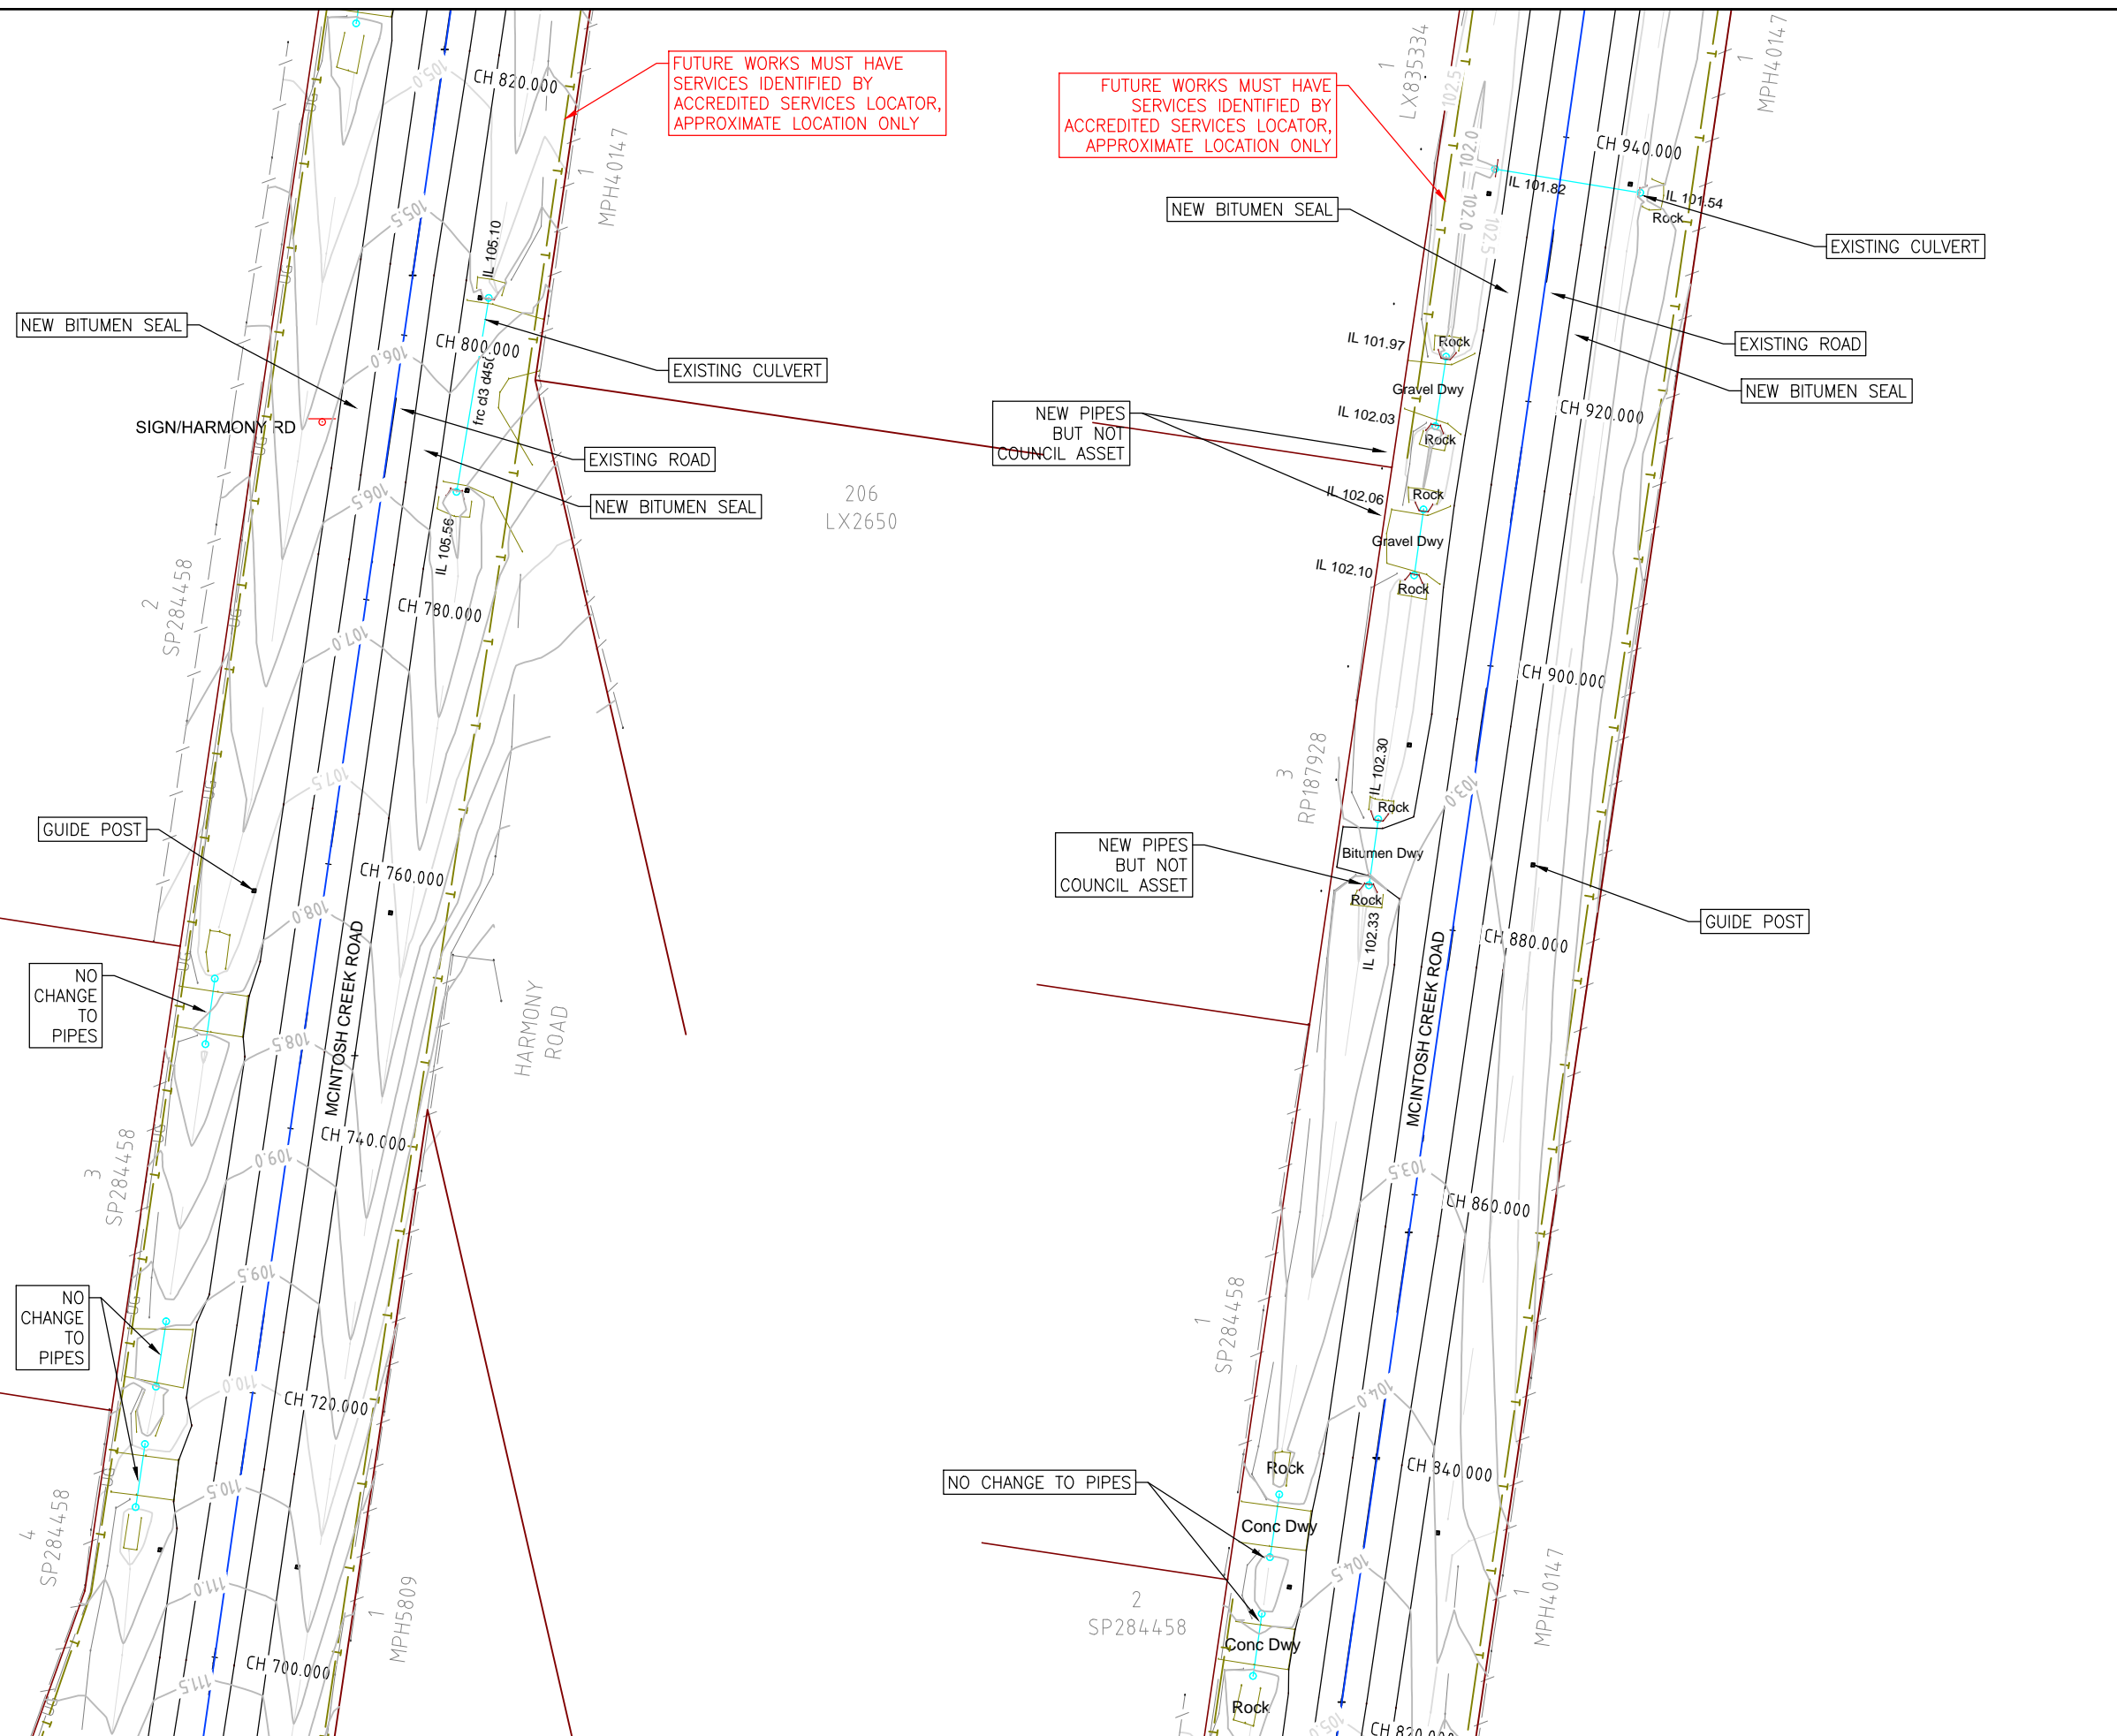


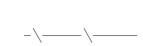

1803-MP
Sheet No. - Revision No.
S34-S8 1

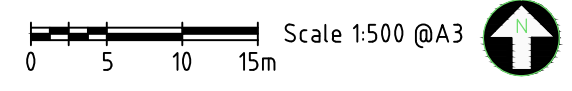

CERTIFIED BY: 
RPEQ No.: 13201 (Allister Haynes)
DATE: 7/11/23

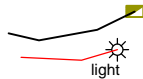
This drawing is an accurate representation of the works as-constructed. All the locations and levels shown on this plan have been provided by a Surveyor as defined in the Surveyors Act 2003. I hereby accept responsibility for the as-constructed information shown on this plan.



- LEGEND:**
-  COMMUNICATIONS PIT, LIGHTS AND CROSSING MARKERS PICKED UP BY SURVEY. SERVICE CONDUIT LOCATION IS APPROXIMATE AND ALL FUTURE WORKS MUST HAVE SERVICES IDENTIFIED BY ACCREDITED SERVICES LOCATOR.
 -  AS-CONSTRUCTED CONTOURS AT 0.5m INTERVALS
 -  NEW STORMWATER PIPE
 -  NEW SUBSOIL DRAIN INSPECTION POINT
 -  EXISTING WATERHOLE
 -  APPROX DBYD EXTG UG POWER
 -  APPROX DBYD EXTG UG TELSTRA
 -  FENCE

A3	1	21-11-23	AMEND TITLE BLOCK AS CONSTRUCTED	ATH
	0	7-11-23	AS CONSTRUCTED	ATH
Rv	DATE	REVISIONS	APPR.	

PSM No	OPM42916
(AHD) RL	161.931
SURVEYED	Murray & Assoc. Pty Ltd

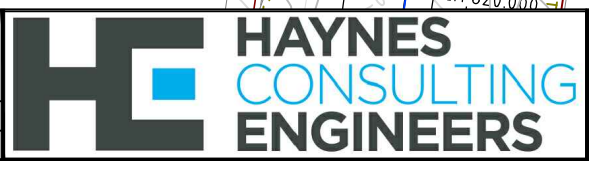

HAYNES CONSULTING ENGINEERS
 ABN 53 613 630 078
 PO BOX 549 NOOSA HEADS QLD 4567
 (0432) 784 150

MCINTOSH PARK STAGE 3-4
 Lots 1-10, 22-31, 40-43 on SP329986
 Surveyed by Murray and Associates Pty Ltd
AS CONSTRUCTED SURVEY LAYOUTS

1803-MP
 Sheet No. - Revision No.
S34-S9 1

Scale 1:500 @A3
0 5 10 15m



CERTIFIED BY:

[Signature]

RPEQ No.: 13201 (Allister Haynes)

DATE: 7 / 11 / 23

This drawing is an accurate representation of the works as-constructed. All the locations and levels shown on this plan have been provided by a Surveyor as defined in the Surveyors Act 2003. I hereby accept responsibility for the as-constructed information shown on this plan.

FUTURE WORKS MUST HAVE SERVICES IDENTIFIED BY ACCREDITED SERVICES LOCATOR, APPROXIMATE LOCATION ONLY

FUTURE WORKS MUST HAVE SERVICES IDENTIFIED BY ACCREDITED SERVICES LOCATOR, APPROXIMATE LOCATION ONLY

LEGEND:

- COMMUNICATIONS PIT, LIGHTS AND CROSSING MARKERS PICKED UP BY SURVEY, SERVICE CONDUIT LOCATION IS APPROXIMATE AND ALL FUTURE WORKS MUST HAVE SERVICES IDENTIFIED BY ACCREDITED SERVICES LOCATOR.
- AS-CONSTRUCTED CONTOURS AT 0.5m INTERVALS
- NEW STORMWATER PIPE
- NEW SUBSOIL DRAIN INSPECTION POINT
- EXISTING WATERHOLE
- APPROX DBYD EXTG UG POWER
- APPROX DBYD EXTG UG TELSTRA
- FENCE

A3

1	21-11-23	AMEND TITLE BLOCK AS CONSTRUCTED	ATH
0	7-11-23		ATH
Rv	DATE	REVISIONS	APPR.

PSM No	OPM/42916
(AHD) RL	161.931
SURVEYED	Murray & Assoc. Pty Ltd



HAYNES CONSULTING ENGINEERS
ABN 53 613 630 078
PO BOX 549 NOOSA HEADS QLD 4567
(0432) 784 150

MCINTOSH PARK STAGE 3-4

Lots 1-10, 22-31, 40-43 on SP329986

Surveyed by Murray and Associates Pty Ltd

AS CONSTRUCTED SURVEY LAYOUTS

1803-MP

Sheet No. - Revision No.

S34-S10 1