


Survey Report

- This plan has been prepared in accordance with Stormwater Approval condition 17 of Gympie Regional Council DA 2020-1283.
- The Q100 Floodline plotted herein is based on AHD (der) Vide CORS.
- Contour Interval = 1.0m.
- The Q100 Floodline plotted herein is based on the Finished Surface Contours as detailed by Murray and Associates (QLD) Pty Ltd plan of As-constructed Survey of Stages 3 & 4 of 'McIntosh Park', McIntosh Creek.
- Q100 flood level plotted herein is based on the HWMC Flood Report J00342RIV2 15-12-2020 mitigated case 1% AEP or Q100 (Non Climate Change).

Scale 1:2500 - Lengths are in metres.

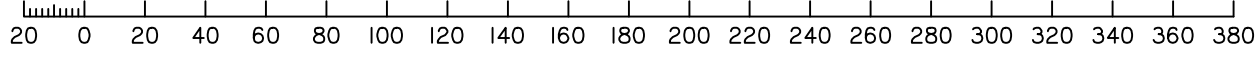

MURRAY & ASSOCIATES
 SURVEYORS & TOWN PLANNERS
 ACN 075 543 154
 Murray Building, 15-17 Currie St. Nambour Ph.(07)5441 2188 P.O. Box 246
 Branch Offices at Caboolture Chinchilla Roma Gympie & Emerald
 CADASTRAL SURVEYOR
[Signature]

Plan Showing Q100 Floodline over Finished Surface Levels of Subdivision on Part of Lot 900 on SP321728

LOCAL AUTHORITY: **GYMPIE REGIONAL COUNCIL**

CLIENT Roberts Brothers	
LOCALITY McIntosh Creek	MAP REF. 9445-31444
DATE 29/11/2023	LEVEL AHD (der) DATUM Vide CORS
FILE 61086_(Proposed Floodline)_Roberts Brothers	
DRAWN DJ	CHECKED IKS
ORIGINAL POR 1131	JOB No 61086
SCALE 1:2500	