
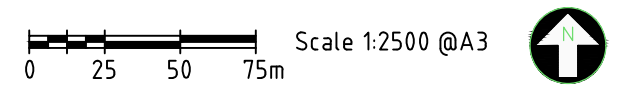


LEGEND:

- NEW LOT BOUNDARY
- NEW EASEMENT
- NEW STORMIRRIGATION PIPE
- EXISTING LOT BOUNDARY
- EXISTING WATERHOLE
- 1% AEP CLIMATE CHANGE DEVELOPED FLOOD LINE FROM COUNCIL DATA RL61.91

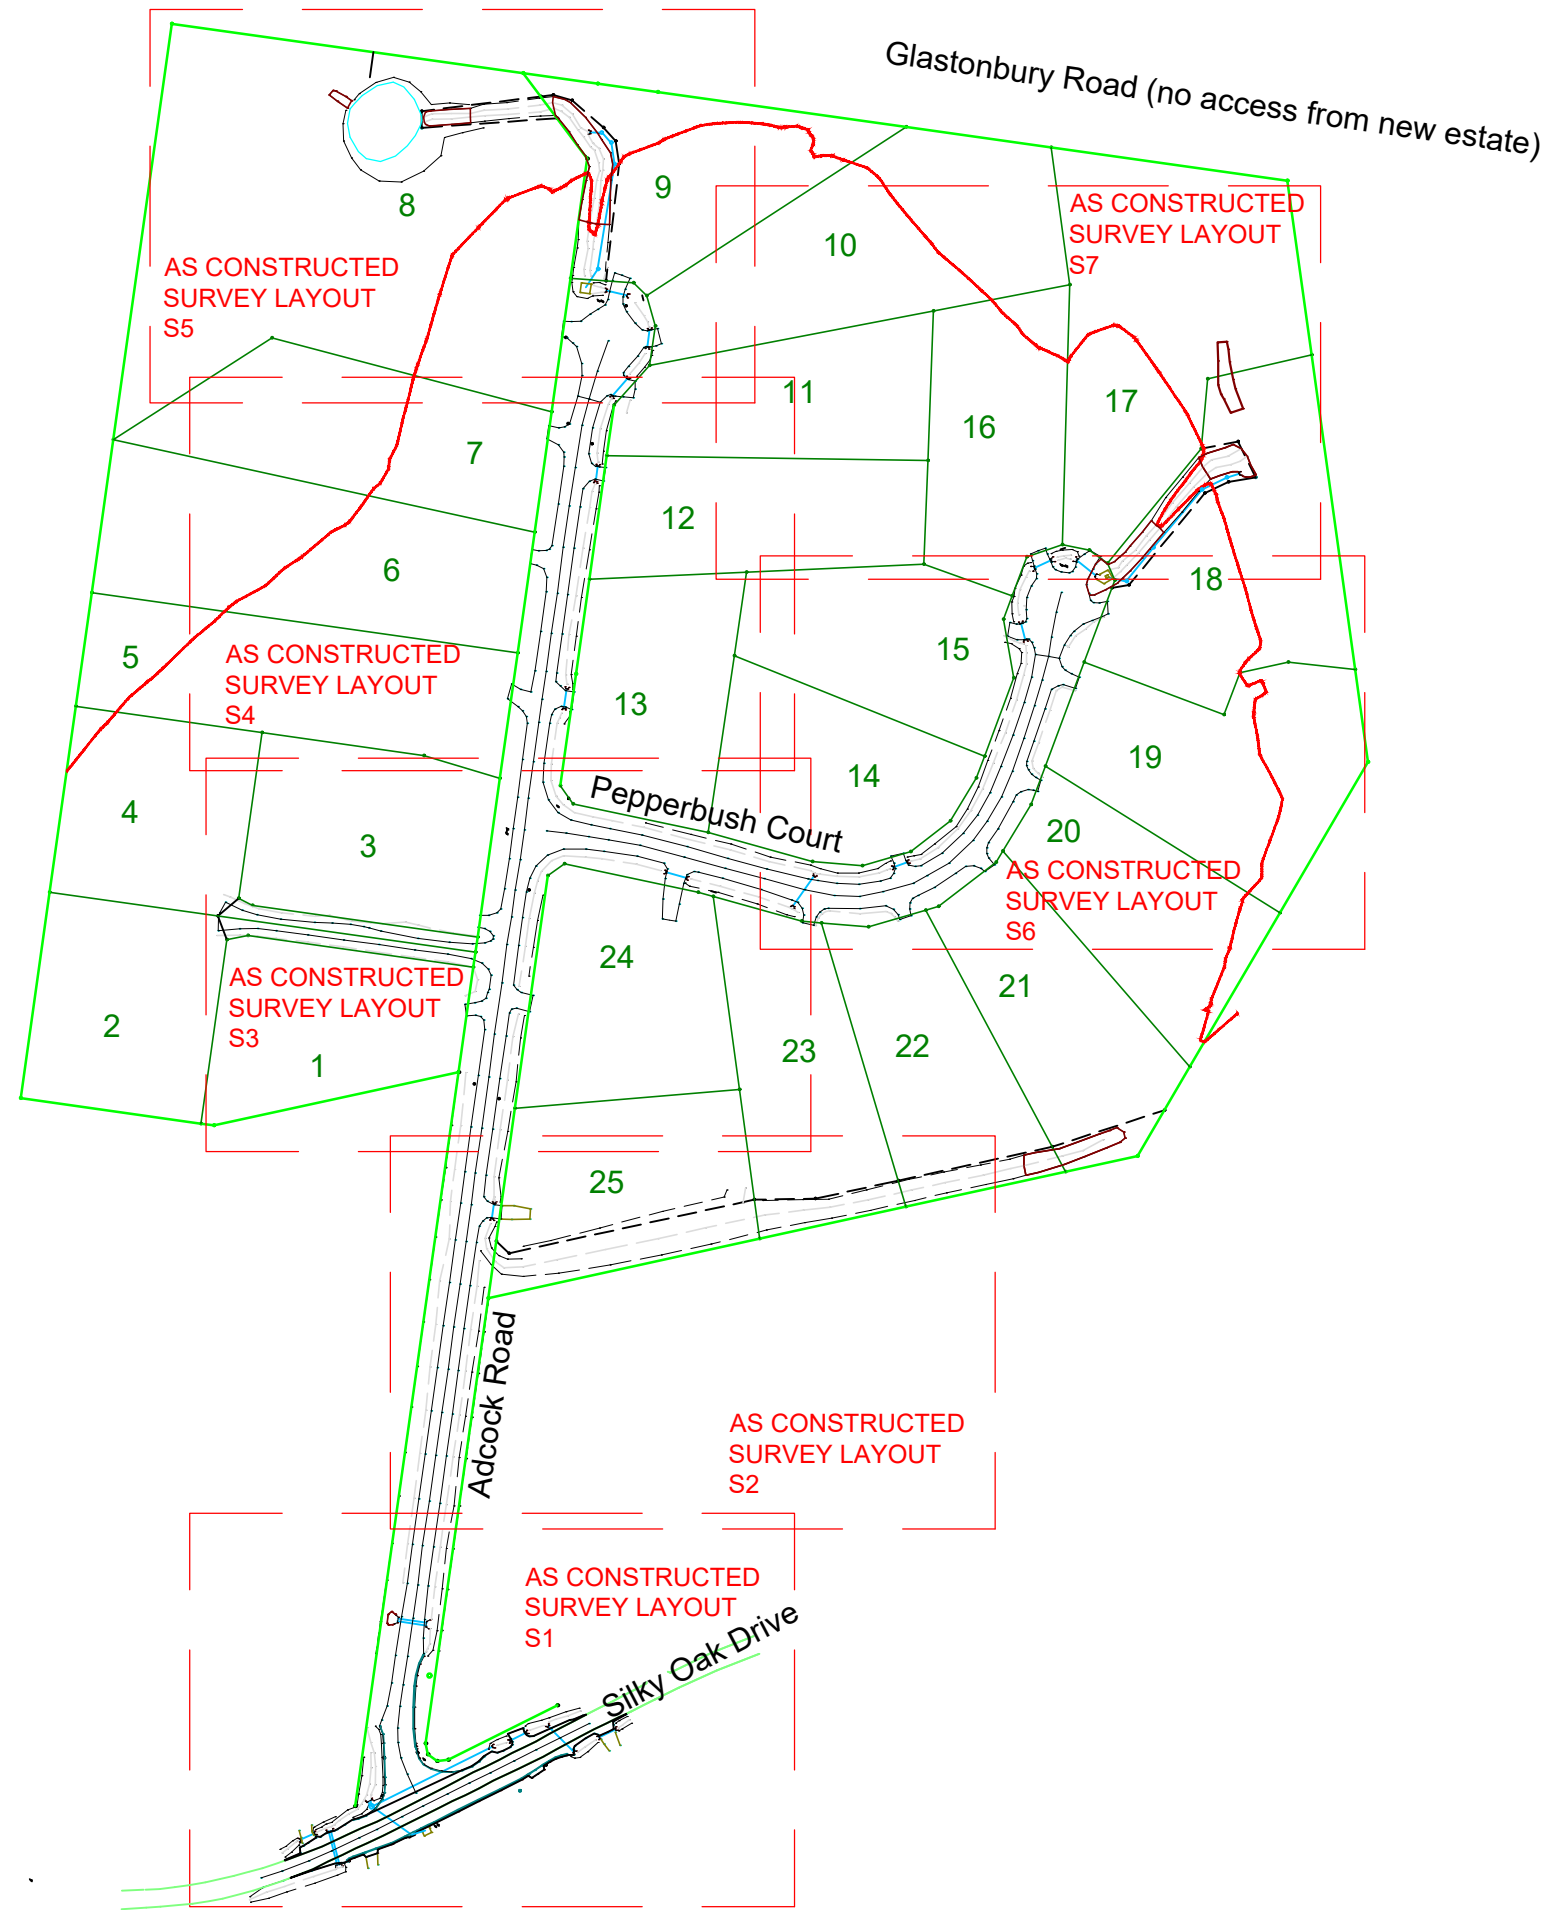

CERTIFIED BY: 
RPEQ No.: 13201 (Allister Haynes)
DATE: 31 / 3 / 25

This drawing is an accurate representation of the works as-constructed. All the locations and levels shown on this plan have been provided by a Surveyor as defined in the Surveyors Act 2003. I hereby accept responsibility for the as-constructed information shown on this plan.

A3

0	31-3-25	AS CONSTRUCTED	SLH
RV	DATE	REVISIONS	APPR.

PSM No	99270
(AHD) RL	72.506
SURVEYED	Murray & Assoc. Pty Ltd



HAYNES CONSULTING ENGINEERS
ABN 53 613 630 078
PO BOX 549 NOOSA HEADS QLD 4567
(0432) 784 150

OAKRIDGE ESTATE
Lots 1-25 on SP353663, Adcock Road, Nahrunda
Surveyed by Murray and Associates Pty Ltd
AS CONSTRUCTED SURVEY LAYOUTS

2103 AC
Sheet No. - Revision No.
S0 0

90

•

SERVICES MARKER

EXISTING OR ASCON OF DAM

EXISTING TELSTRA

OVERHEAD POWER

FUTURE WORKS MUST
HAVE SERVICES
IDENTIFIED BY
ACCREDITED SERVICES
LOCATOR, APPROXIMATE
LOCATION ONLY

CONNECTION TO
EXISTING IRRIGATION
MAIN EAST ALONG
SILKY OAK DRIVE

CONNECTION TO
EXISTING IRRIGATION
MAIN WEST ALONG
SILKY OAK DRIVE

field pit IPWEAQ type 1 elevated SL72.24 (conc), IL 71.55

```
frc.class 3 d450
```

gully pit SL 72.33 (lip) IL 71.52 (in) IL 71.50 (out)

CERTIFIED BY:

RPEQ No.: 13201 (Allister Haynes)

DATE: 31 / 3 / 25

This drawing is an accurate representation of the works as-constructed. All the locations and levels shown on this plan have been provided by a Surveyor as defined in the Surveyors Act 2003. I hereby accept responsibility for the as-constructed information shown on this plan.

A3

0	31-3-25	AS CONSTRUCTED
---	---------	----------------

PSM No	99270
(AHD) RL	72.506
SURVEYED	Murray & Assoc. Pty Ltd

SLH

	APPR
--	------



HAYNES
CONSULTING
ENGINEERS

HAYNES CONSULTING ENGINEERS
ABN 53 613 630 078
PO BOX 549 NOOSA HEADS QLD 4567
(0432) 784 150

OAKRIDGE ESTATE

Lots 1-25 on SP353663, Adcock Road, Nahrunda


Surveyed by Murray and Associates Pty Ltd

AS CONSTRUCTED SURVEY LAYOUTS

2103 AC

Sheet No. - Revision No.

S1	0
----	---

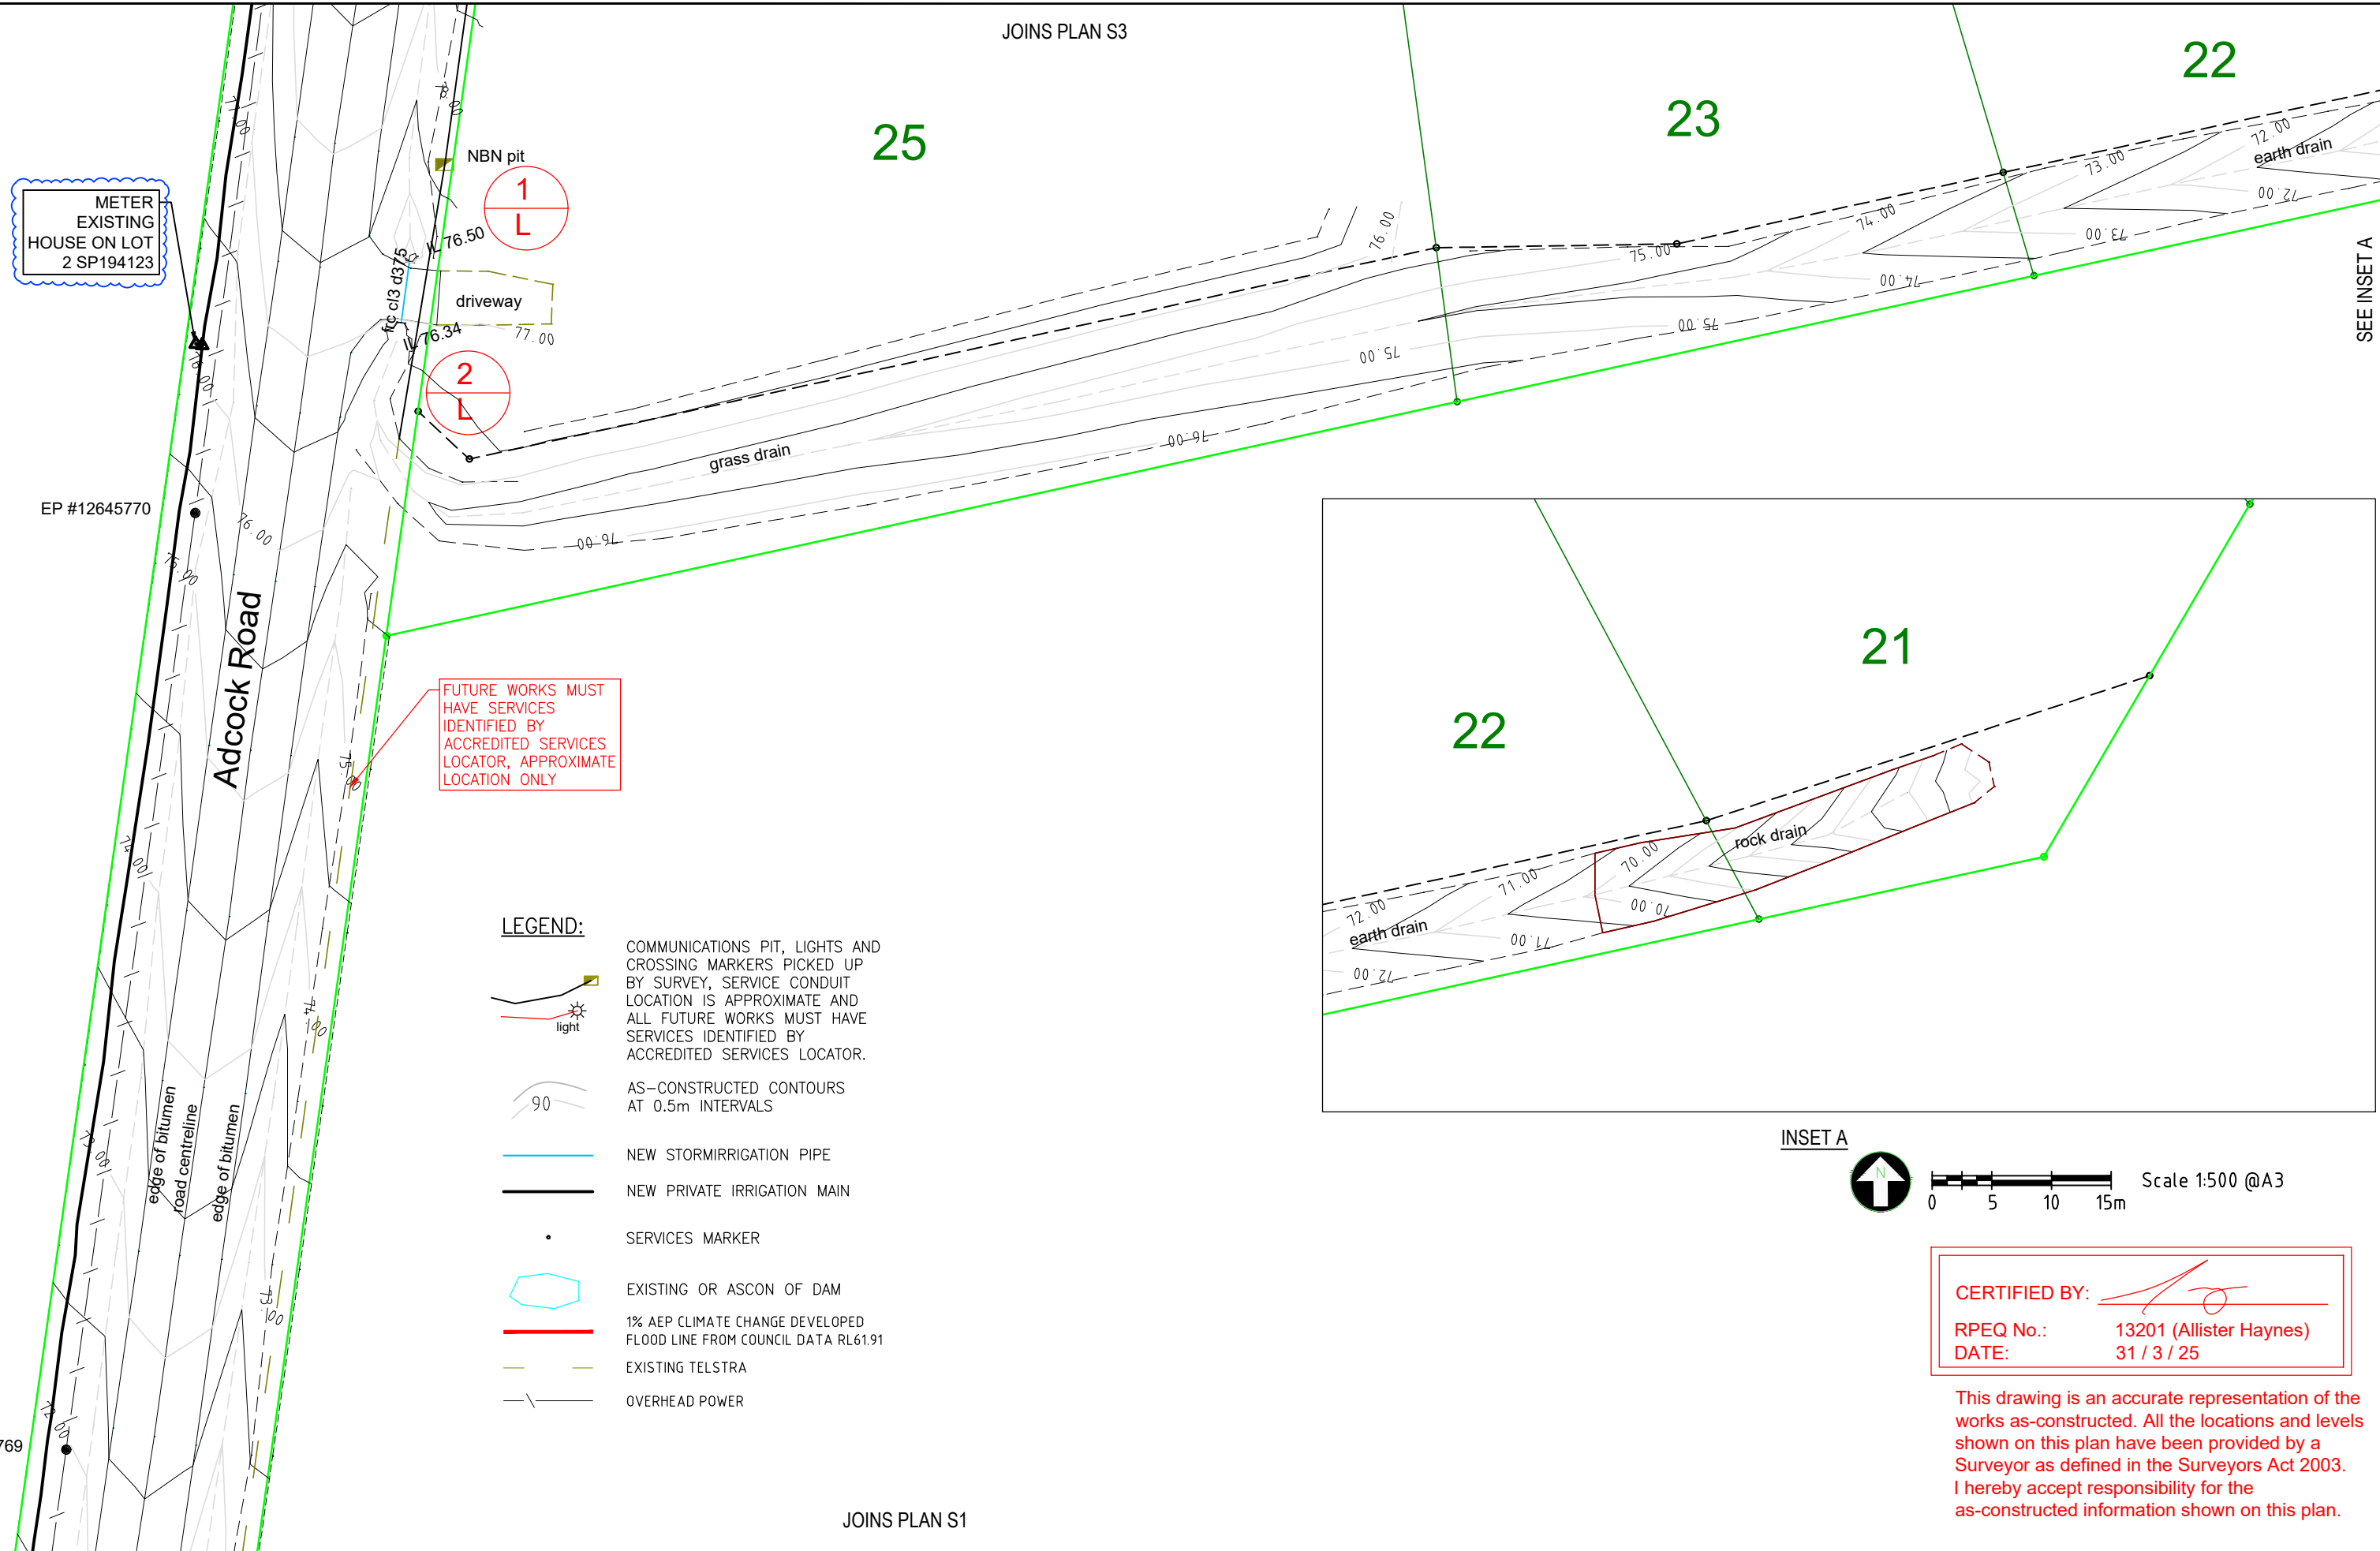

INSET A

0 5 10 15m Scale 1:500 @A3


CERTIFIED BY:

RPEQ No.: 13201 (Allister Haynes)


DATE: 31 / 3 / 25

This drawing is an accurate representation of the works as-constructed. All the locations and levels shown on this plan have been provided by a Surveyor as defined in the Surveyors Act 2003. I hereby accept responsibility for the as-constructed information shown on this plan.

A3	0	31-3-25	AS CONSTRUCTED	SLH	PSM No	99270		HAYNES CONSULTING ENGINEERS	HAYNES CONSULTING ENGINEERS ABN 53 613 630 078 PO BOX 549 NOOSA HEADS QLD 4567 (0432) 784 150	OAKRIDGE ESTATE Lots 1-25 on SP353663, Adcock Road, Nahrunda Surveyed by Murray and Associates Pty Ltd AS CONSTRUCTED SURVEY LAYOUTS	2103 AC
					(AHD) RL	72.506					
Rv	DATE	REVISIONS	APPR.		SURVEYED	Murray & Assoc. Pty Ltd					Sheet No. - Revision No.
											S2 0

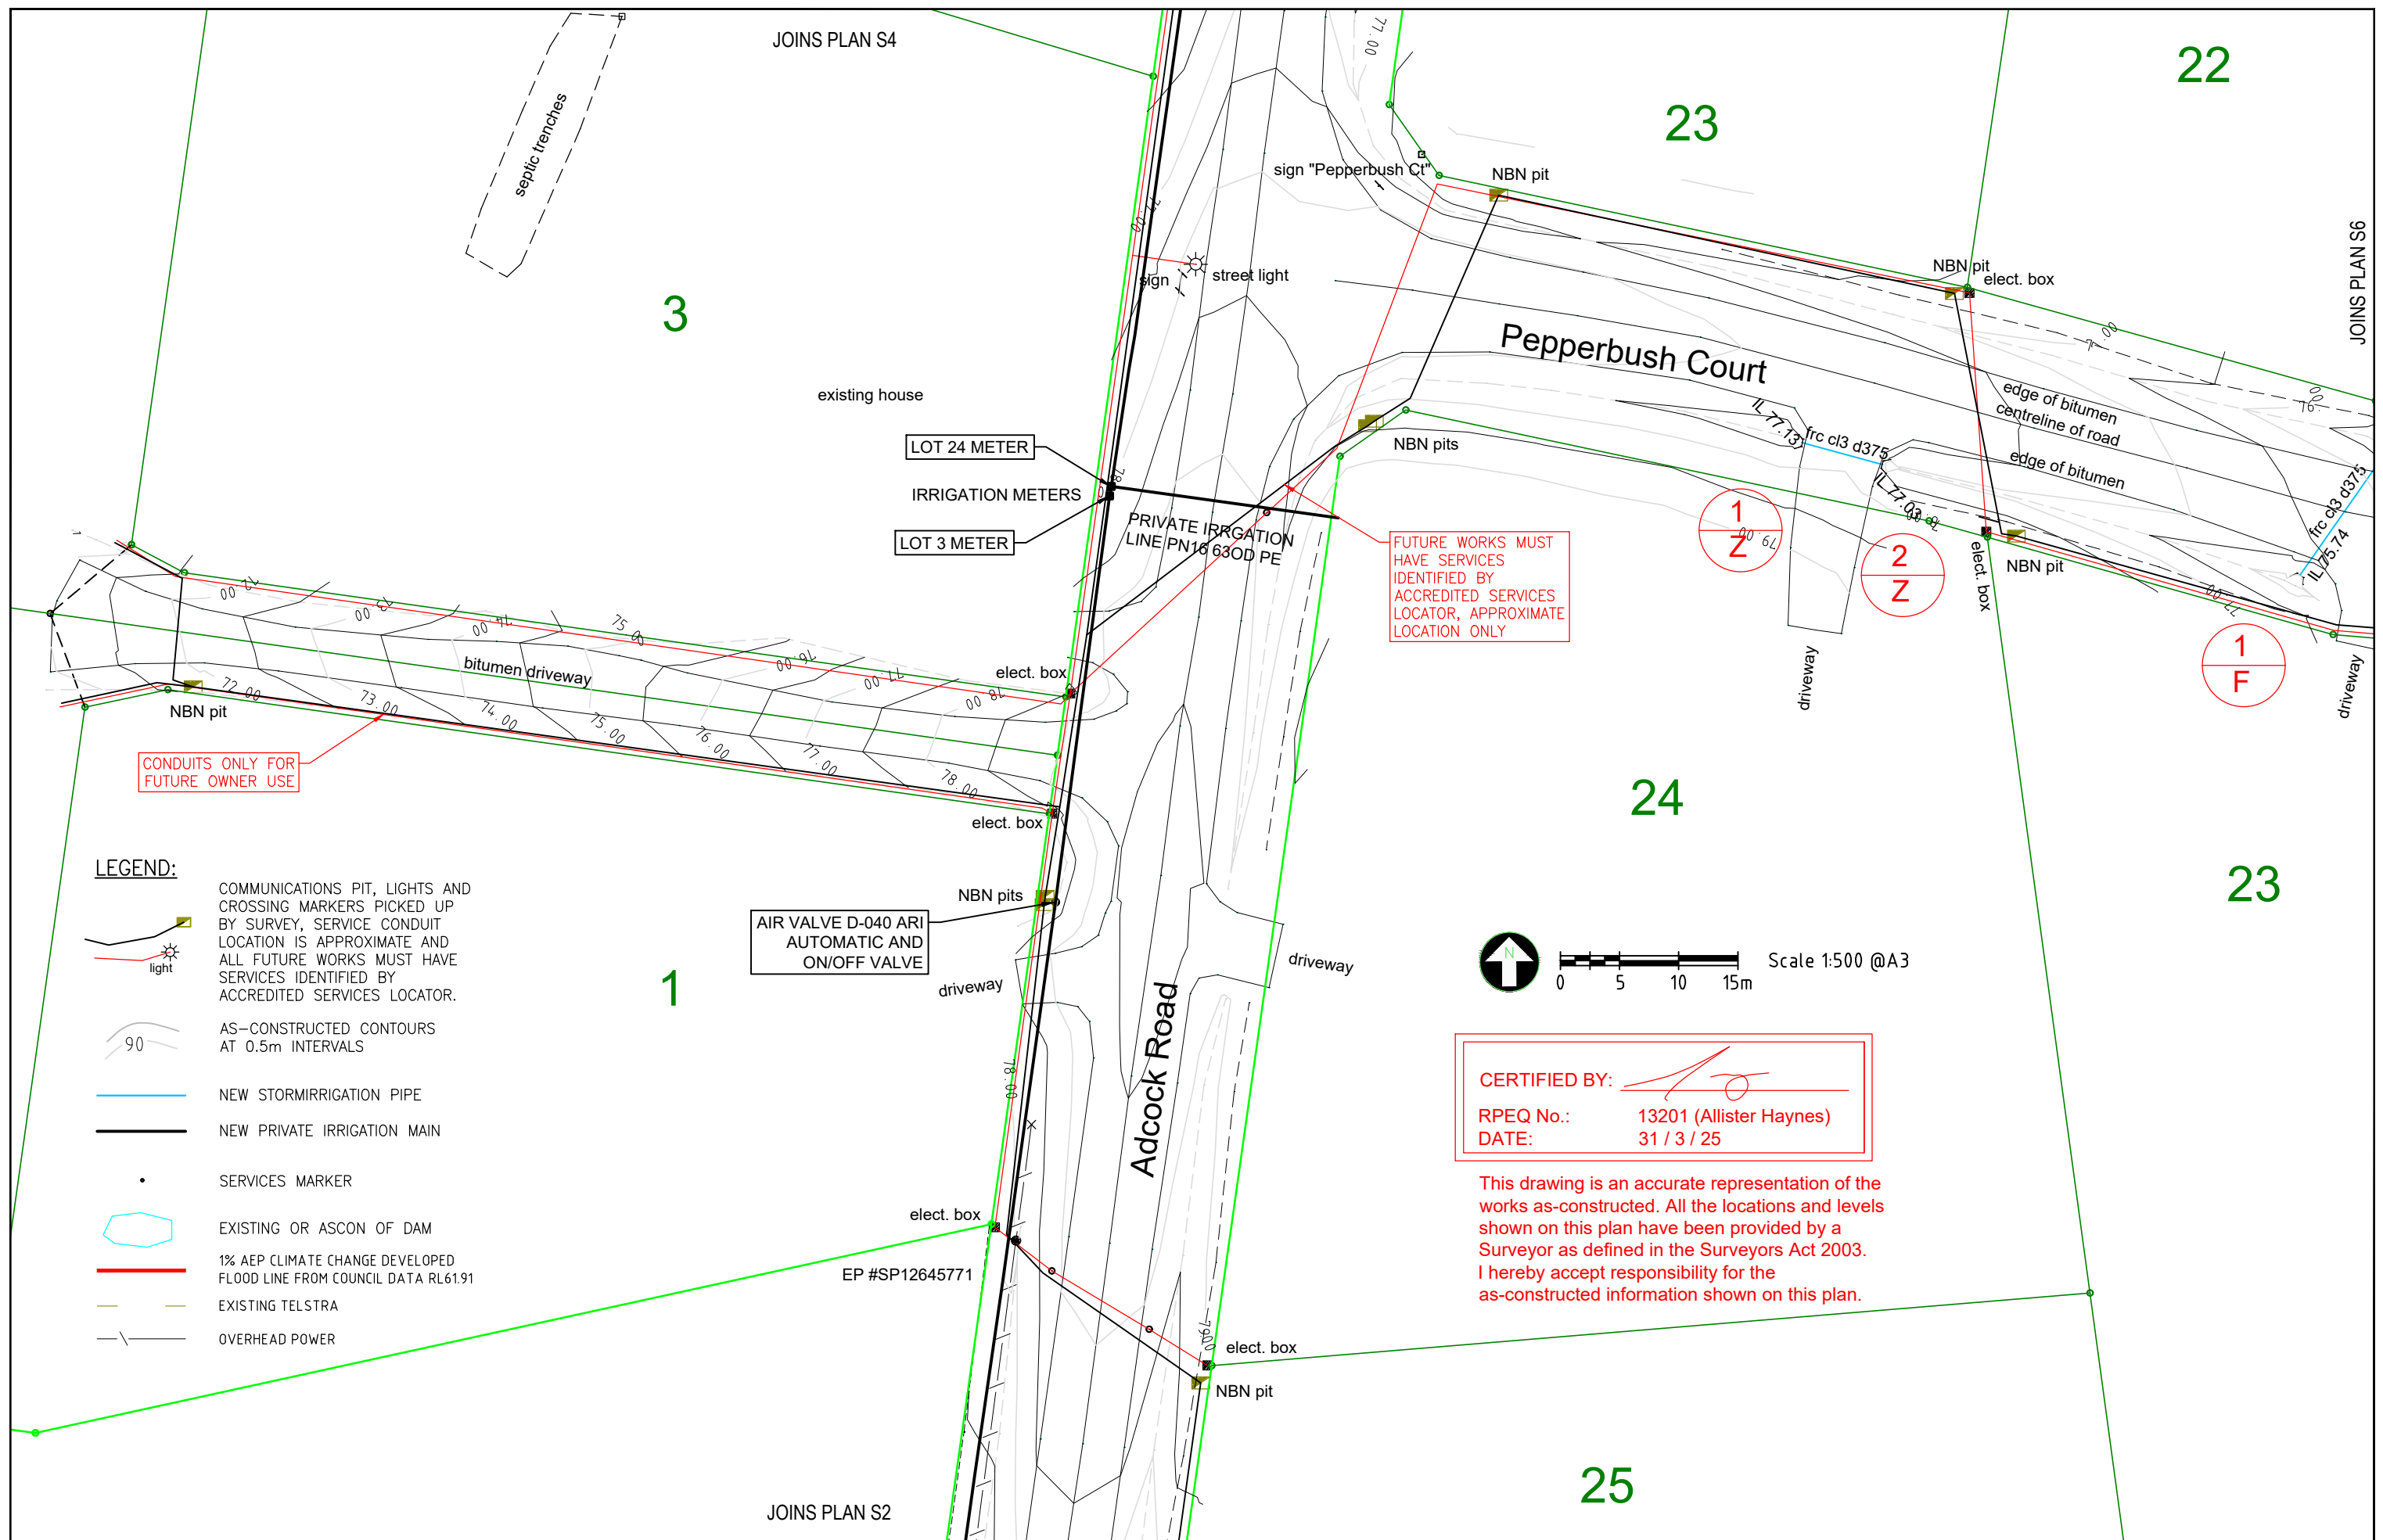

A3				PSM No	99270		HAYNES CONSULTING ENGINEERS	HAYNES CONSULTING ENGINEERS ABN 53 613 630 078 PO BOX 549 NOOSA HEADS QLD 4567 (0432) 784 150	OAKRIDGE ESTATE Lots 1-25 on SP353663, Adcock Road, Nahrunda Surveyed by Murray and Associates Pty Ltd AS CONSTRUCTED SURVEY LAYOUTS	2103 AC Sheet No. - Revision No. S3 0
	0	31-3-25	AS CONSTRUCTED	(AHD) RL	72.506					
	RV	DATE	REVISIONS	SURVEYED	Murray & Assoc. Pty Ltd					
				SLH						
				APPR.						

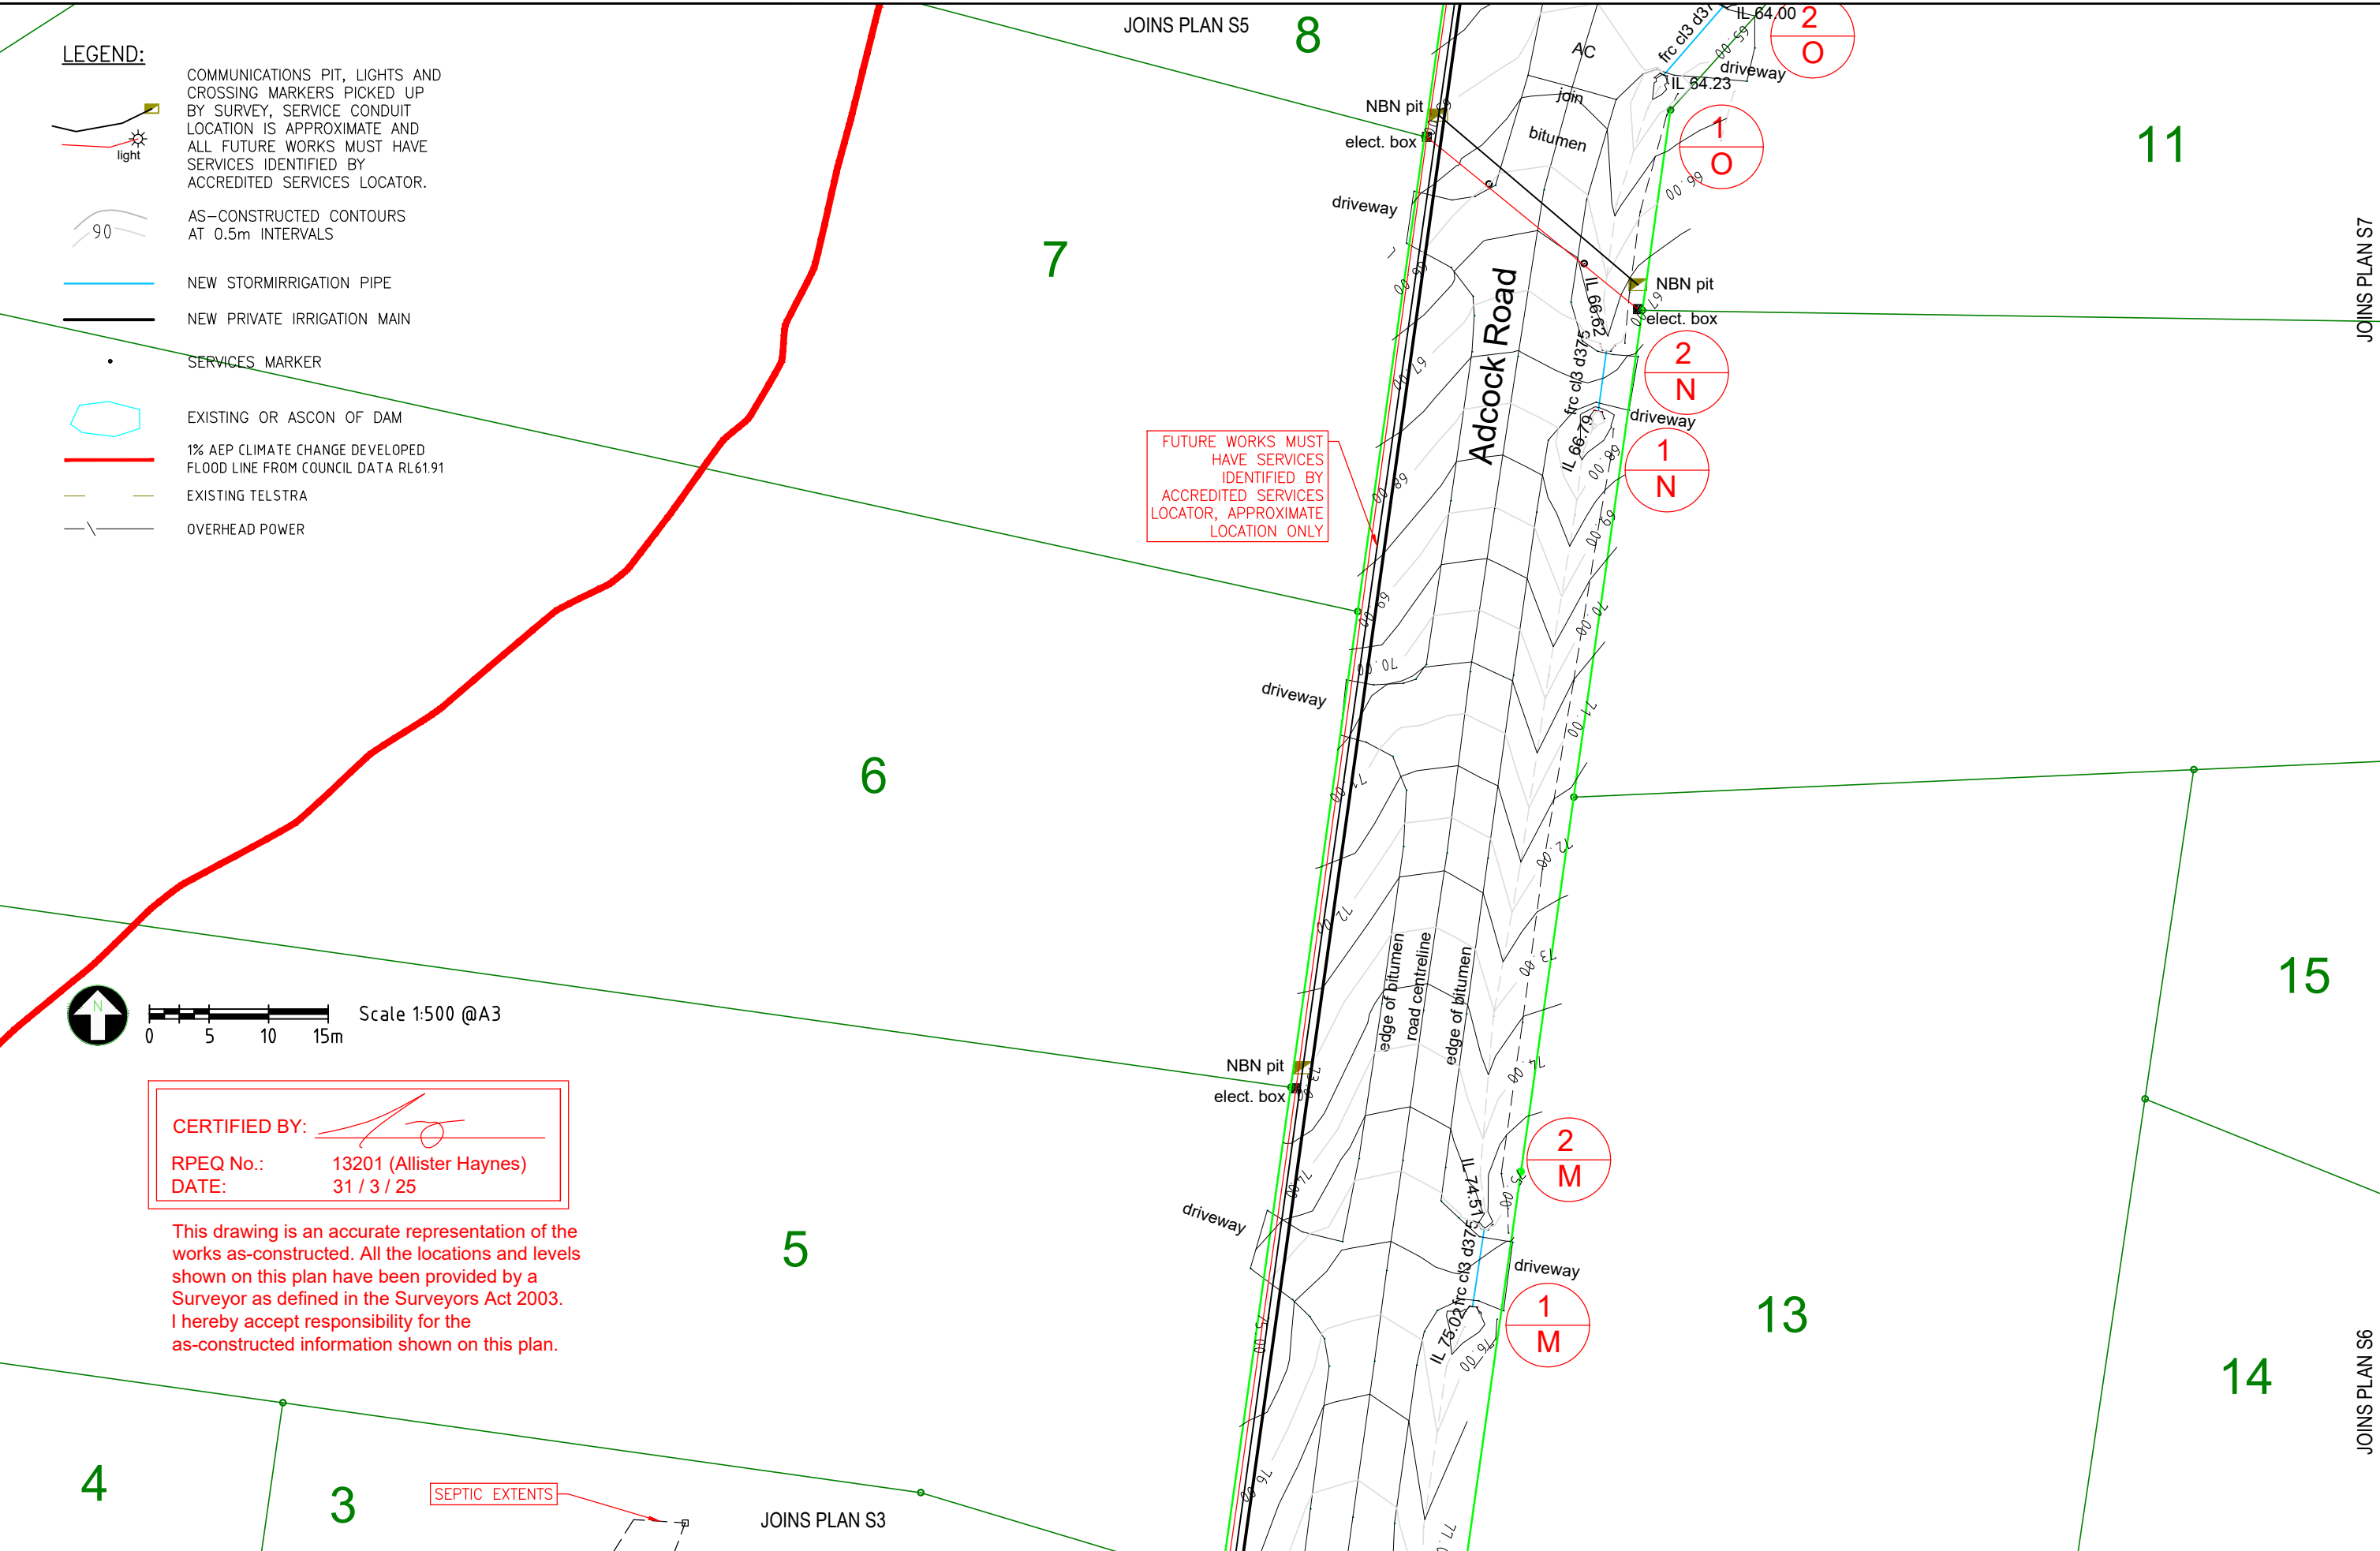

CERTIFIED BY: 
RPEQ No.: 13201 (Allister Haynes)
DATE: 31 / 3 / 25

This drawing is an accurate representation of the works as-constructed. All the locations and levels shown on this plan have been provided by a Surveyor as defined in the Surveyors Act 2003. I hereby accept responsibility for the as-constructed information shown on this plan.

A3	0	31-3-25	AS CONSTRUCTED	SLH	PSM No	99270		HAYNES CONSULTING ENGINEERS ABN 53 613 630 078 PO BOX 549 NOOSA HEADS QLD 4567 (0432) 784 150	OAKRIDGE ESTATE Lots 1-25 on SP353663, Adcock Road, Nahrunda Surveyed by Murray and Associates Pty Ltd AS CONSTRUCTED SURVEY LAYOUTS	2103 AC Sheet No. - Revision No. S4 0
					(AHD) RL	72.506				
					SURVEYED	Murray & Assoc. Pty Ltd				
	Rv	DATE	REVISIONS	APPR.						



Scale 1:500 @A3

CERTIFIED BY:
RPEQ No.: 13201 (Allister Haynes)
DATE: 31 / 3 / 25

This drawing is an accurate representation of the works as-constructed. All the locations and levels shown on this plan have been provided by a Surveyor as defined in the Surveyors Act 2003. I hereby accept responsibility for the as-constructed information shown on this plan.

LEGEND:

- COMMUNICATIONS PIT, LIGHTS AND CROSSING MARKERS PICKED UP BY SURVEY. SERVICE CONDUIT LOCATION IS APPROXIMATE AND ALL FUTURE WORKS MUST HAVE SERVICES IDENTIFIED BY ACCREDITED SERVICES LOCATOR.
- 90 AS-CONSTRUCTED CONTOURS AT 0.5m INTERVALS
- NEW STORM/IRRIGATION PIPE
- NEW PRIVATE IRRIGATION MAIN
- SERVICES MARKER
- EXISTING OR ASCON OF DAM
- 1% AEP CLIMATE CHANGE DEVELOPED FLOOD LINE FROM COUNCIL DATA RL61.91
- EXISTING TELSTRA
- OVERHEAD POWER

7

JOINS PLAN S3

8

9

10

11

JOINS PLAN S7

A3

0	31-3-25	AS CONSTRUCTED	SLH
Rv	DATE	REVISIONS	APPR.

PSM No	99270
(AHD) RL	72.506
SURVEYED	Murray & Assoc. Pty Ltd



HAYNES CONSULTING ENGINEERS
ABN 53 613 630 078
PO BOX 549 NOOSA HEADS QLD 4567
(0432) 784 150

OAKRIDGE ESTATE
Lots 1-25 on SP353663, Adcock Road, Nahrunda
Surveyed by Murray and Associates Pty Ltd
AS CONSTRUCTED SURVEY LAYOUTS

2103 AC
Sheet No. - Revision No.
S5 0

