






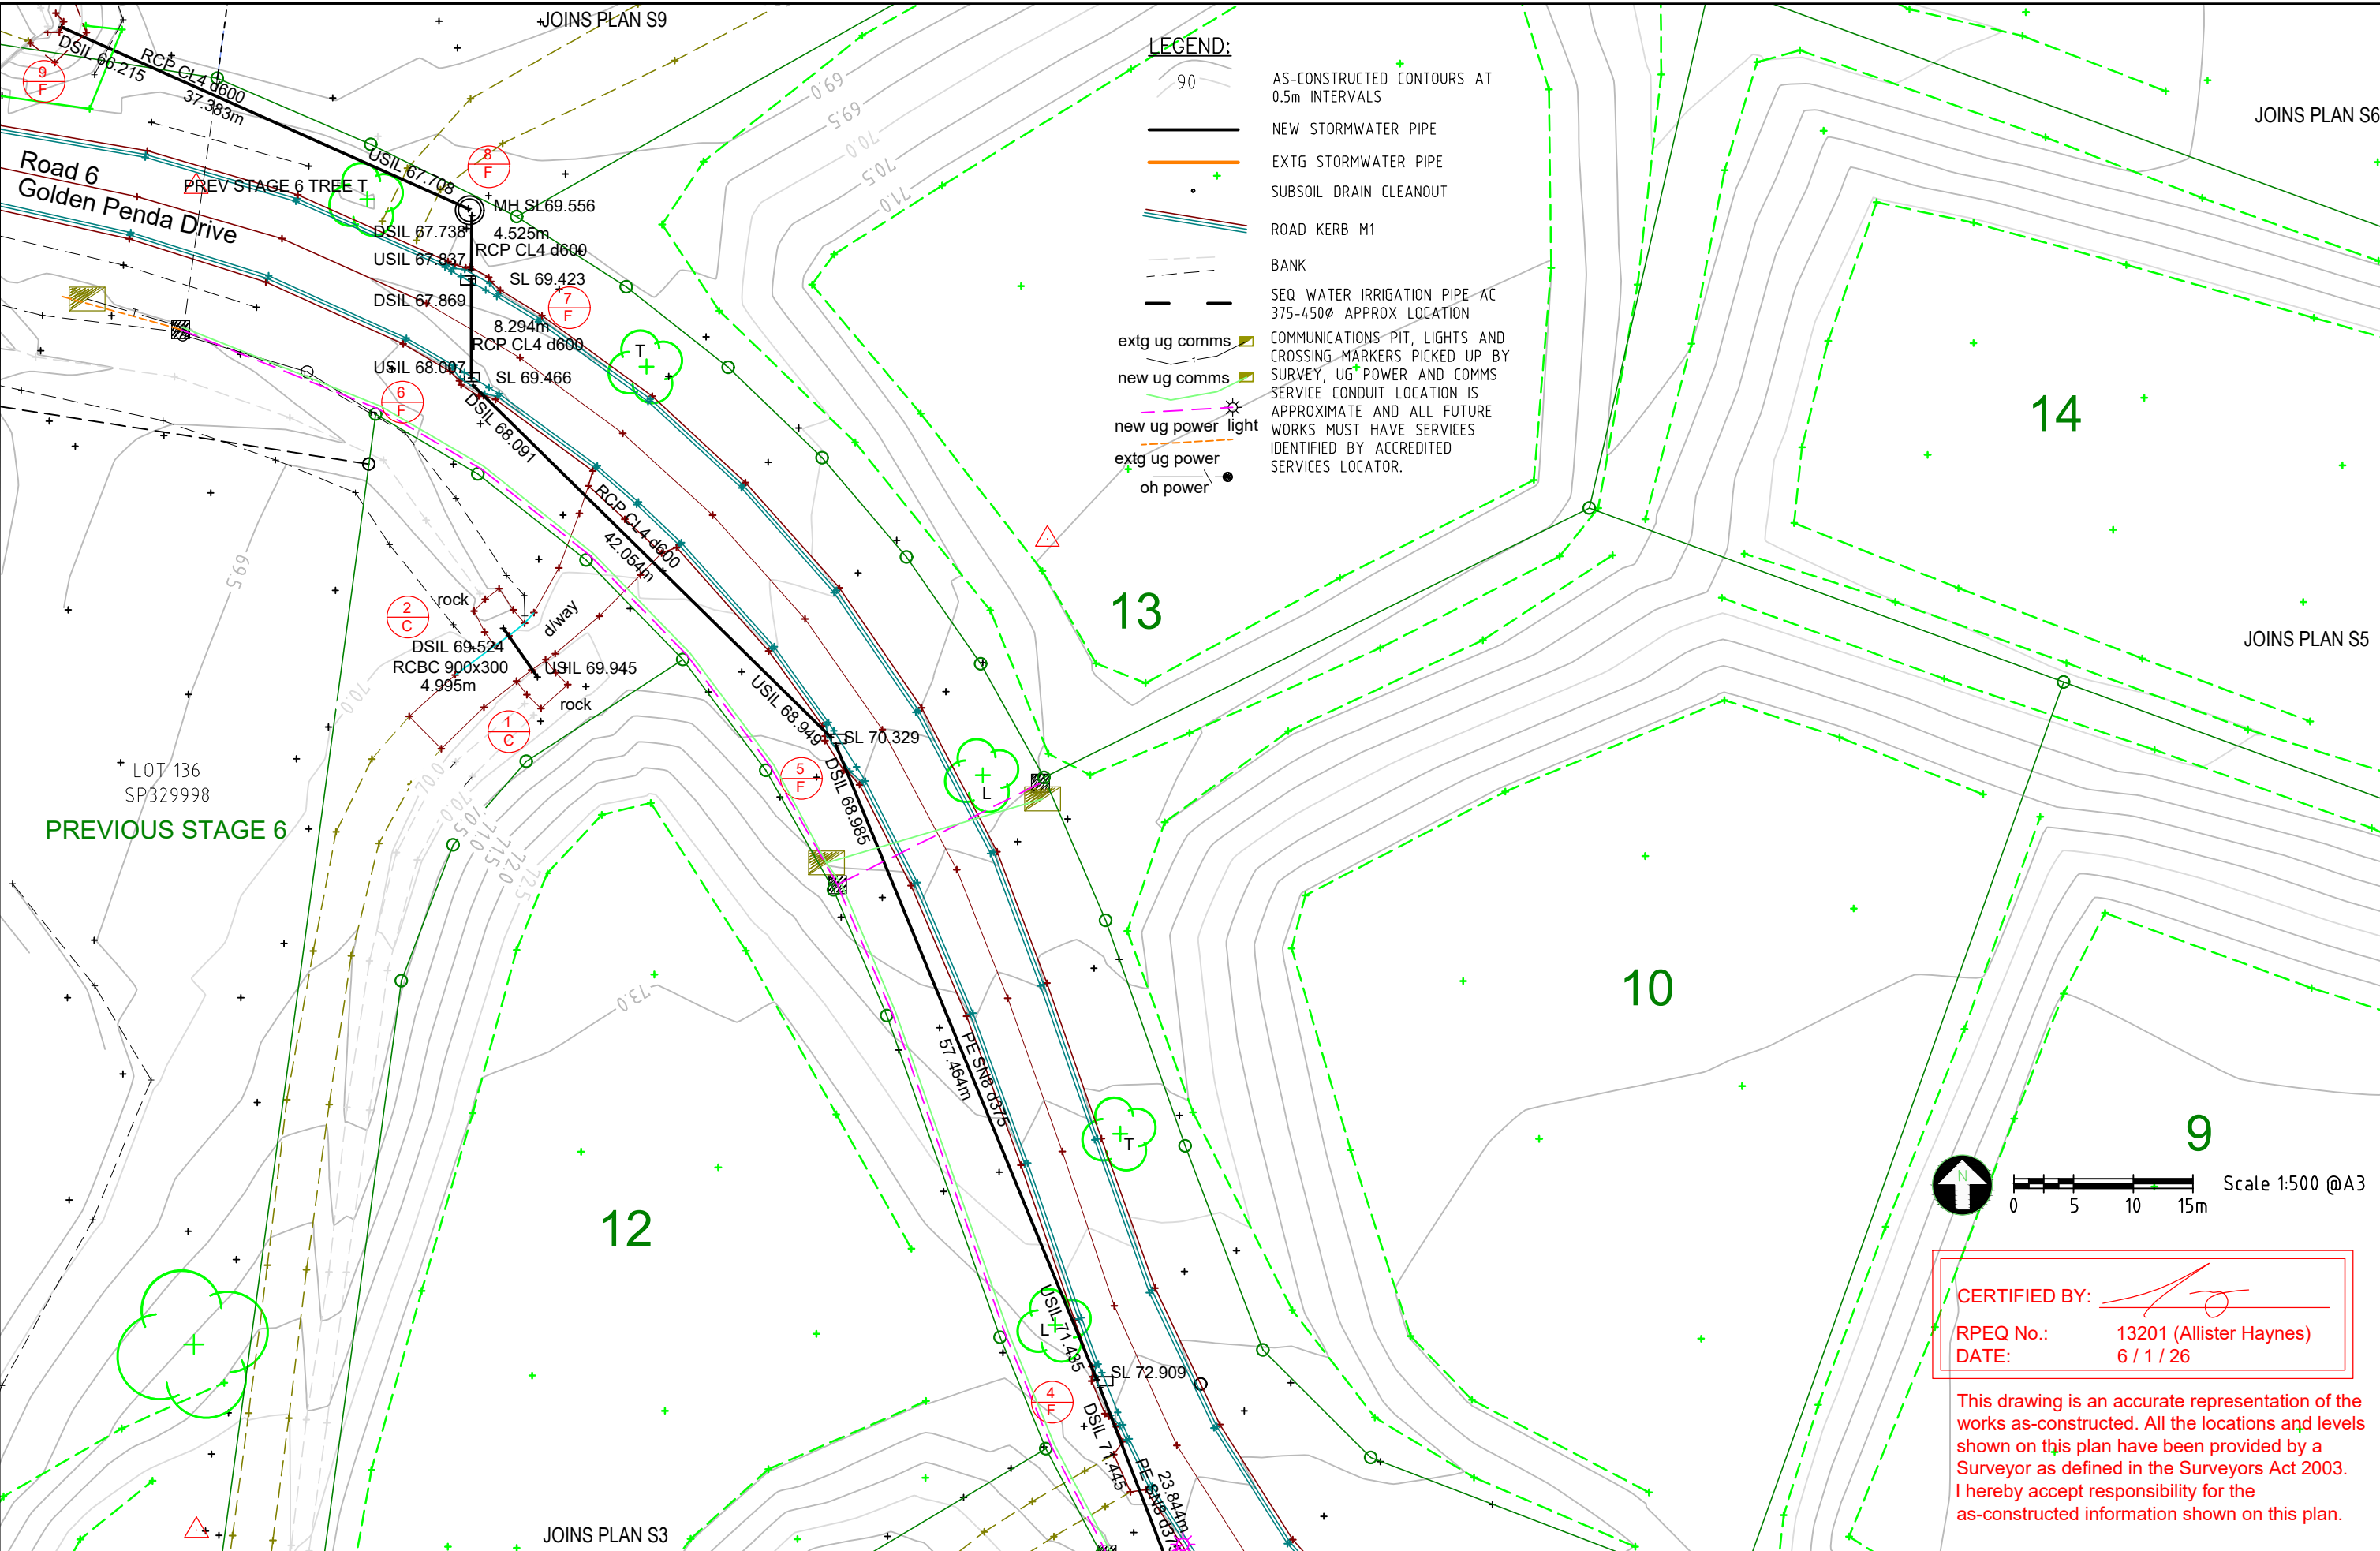

|    |      |           |                |     |             |                         |  |                                                                                                        |                                                                                                                                                                       |           |
|----|------|-----------|----------------|-----|-------------|-------------------------|--|--------------------------------------------------------------------------------------------------------|-----------------------------------------------------------------------------------------------------------------------------------------------------------------------|-----------|
| A3 | 0    | 30-7-26   | AS CONSTRUCTED | SLH | PSM/(AHD)RL | PM197247/(74.829) GDA20 |  | HAYNES CONSULTING ENGINEERS<br>ABN 53 613 630 078<br>PO BOX 549 NOOSA HEADS QLD 4567<br>(0432) 784 150 | GREENDALE ESTATE STAGE 7<br>OPW2024-3802 REC2010-0539 Lots 1-29 on SP363889, 95<br>Mooloo Road, Pie Creek, for Roberts Bros Pty Ltd<br>AS CONSTRUCTED ADAC SW LAYOUTS | 1803S7 AC |
|    |      |           |                |     | SURVEYED    | MURRAY AND ASSOCIATES   |  |                                                                                                        |                                                                                                                                                                       |           |
| Rv | DATE | REVISIONS | APPR.          |     | RPEQ NO.    | 13201                   |  |                                                                                                        |                                                                                                                                                                       |           |
|    |      |           |                |     | RPEQ NAME   | ALLISTER HAYNES         |  |                                                                                                        |                                                                                                                                                                       |           |

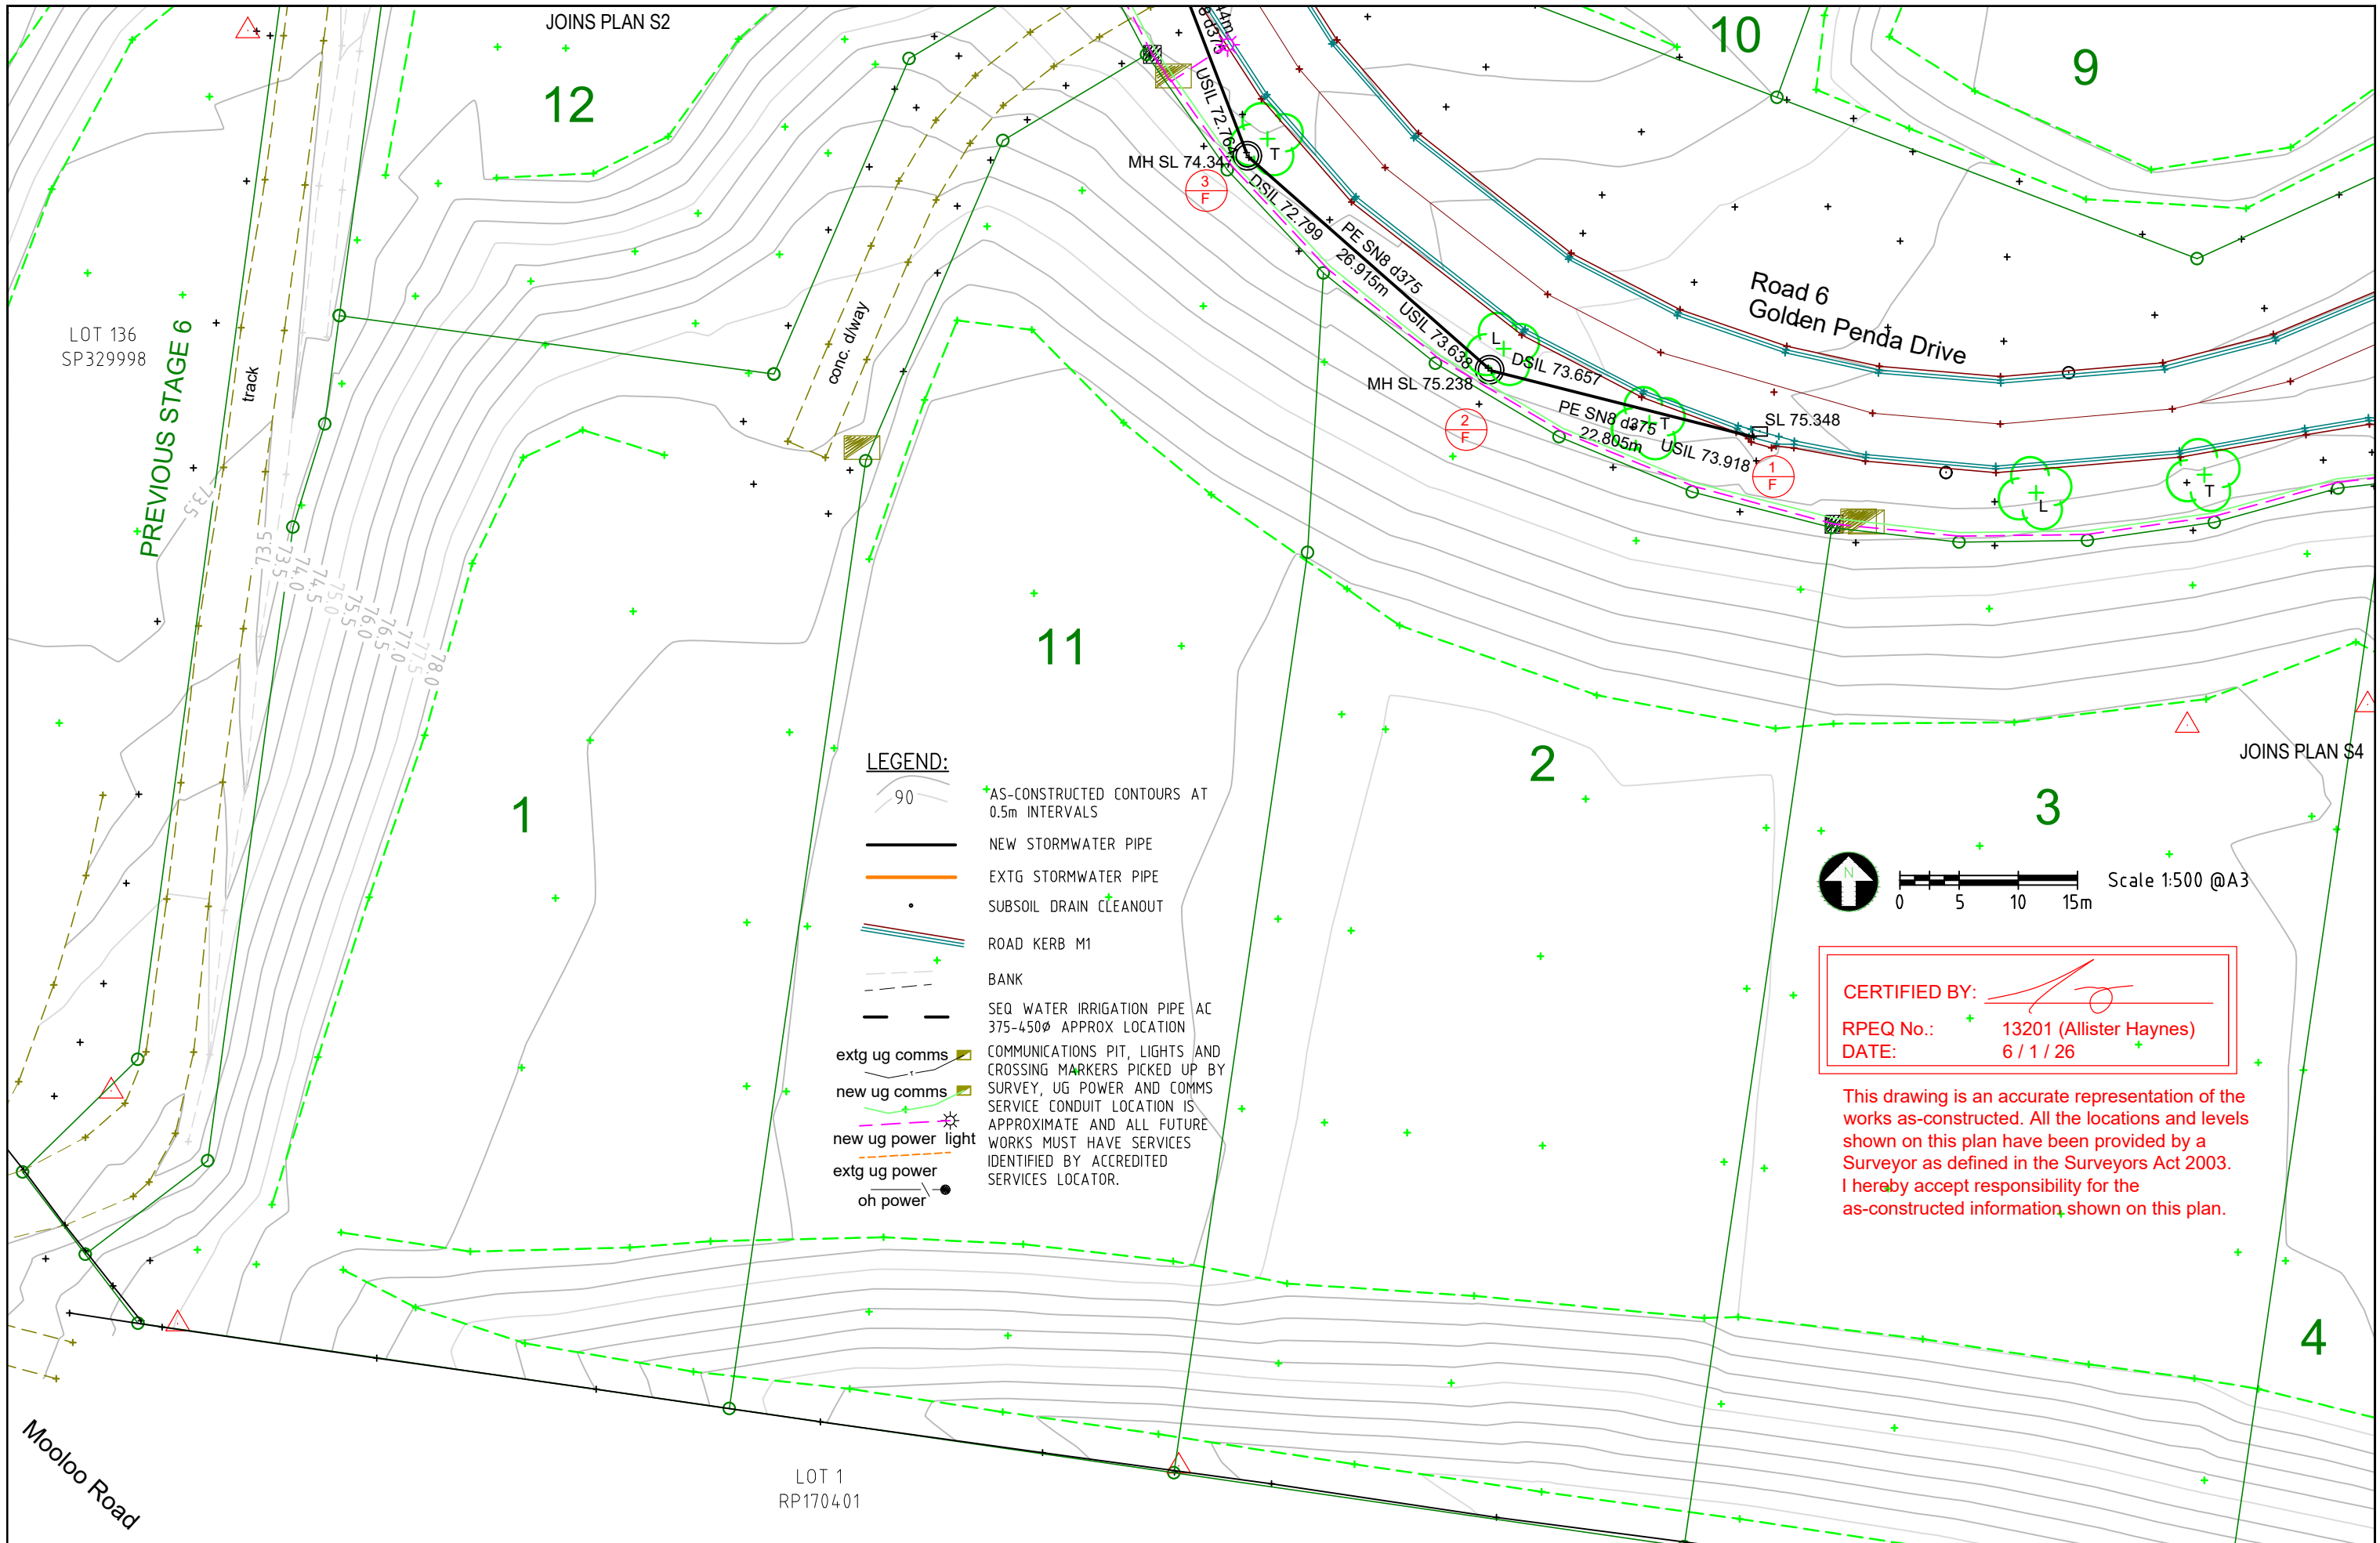


|    |    |         |                |       |             |                                |                                                                                       |                                                                                                        |                                                                                                                                                                       |                                                     |
|----|----|---------|----------------|-------|-------------|--------------------------------|---------------------------------------------------------------------------------------|--------------------------------------------------------------------------------------------------------|-----------------------------------------------------------------------------------------------------------------------------------------------------------------------|-----------------------------------------------------|
| A3 | 0  | 30-7-26 | AS CONSTRUCTED | SLH   | PSM/(AHD)RL | PM197247/(74.829) GDA20        |  | HAYNES CONSULTING ENGINEERS<br>ABN 53 613 630 078<br>PO BOX 549 NOOSA HEADS QLD 4567<br>(0432) 784 150 | GREENDALE ESTATE STAGE 7<br>OPW2024-3802 REC2010-0539 Lots 1-29 on SP363889, 95<br>Mooloo Road, Pie Creek, for Roberts Bros Pty Ltd<br>AS CONSTRUCTED ADAC SW LAYOUTS | 1803S7 AC<br>Sheet No. - Revision No.<br>S3 of 12 0 |
|    |    |         |                |       | RPEQ NO.    | MURRAY AND ASSOCIATES<br>13201 |                                                                                       |                                                                                                        |                                                                                                                                                                       |                                                     |
|    |    |         |                |       | RPEQ NAME   | ALLISTER HAYNES                |                                                                                       |                                                                                                        |                                                                                                                                                                       |                                                     |
|    | Rv | DATE    | REVISIONS      | APPR. |             |                                |                                                                                       |                                                                                                        |                                                                                                                                                                       |                                                     |

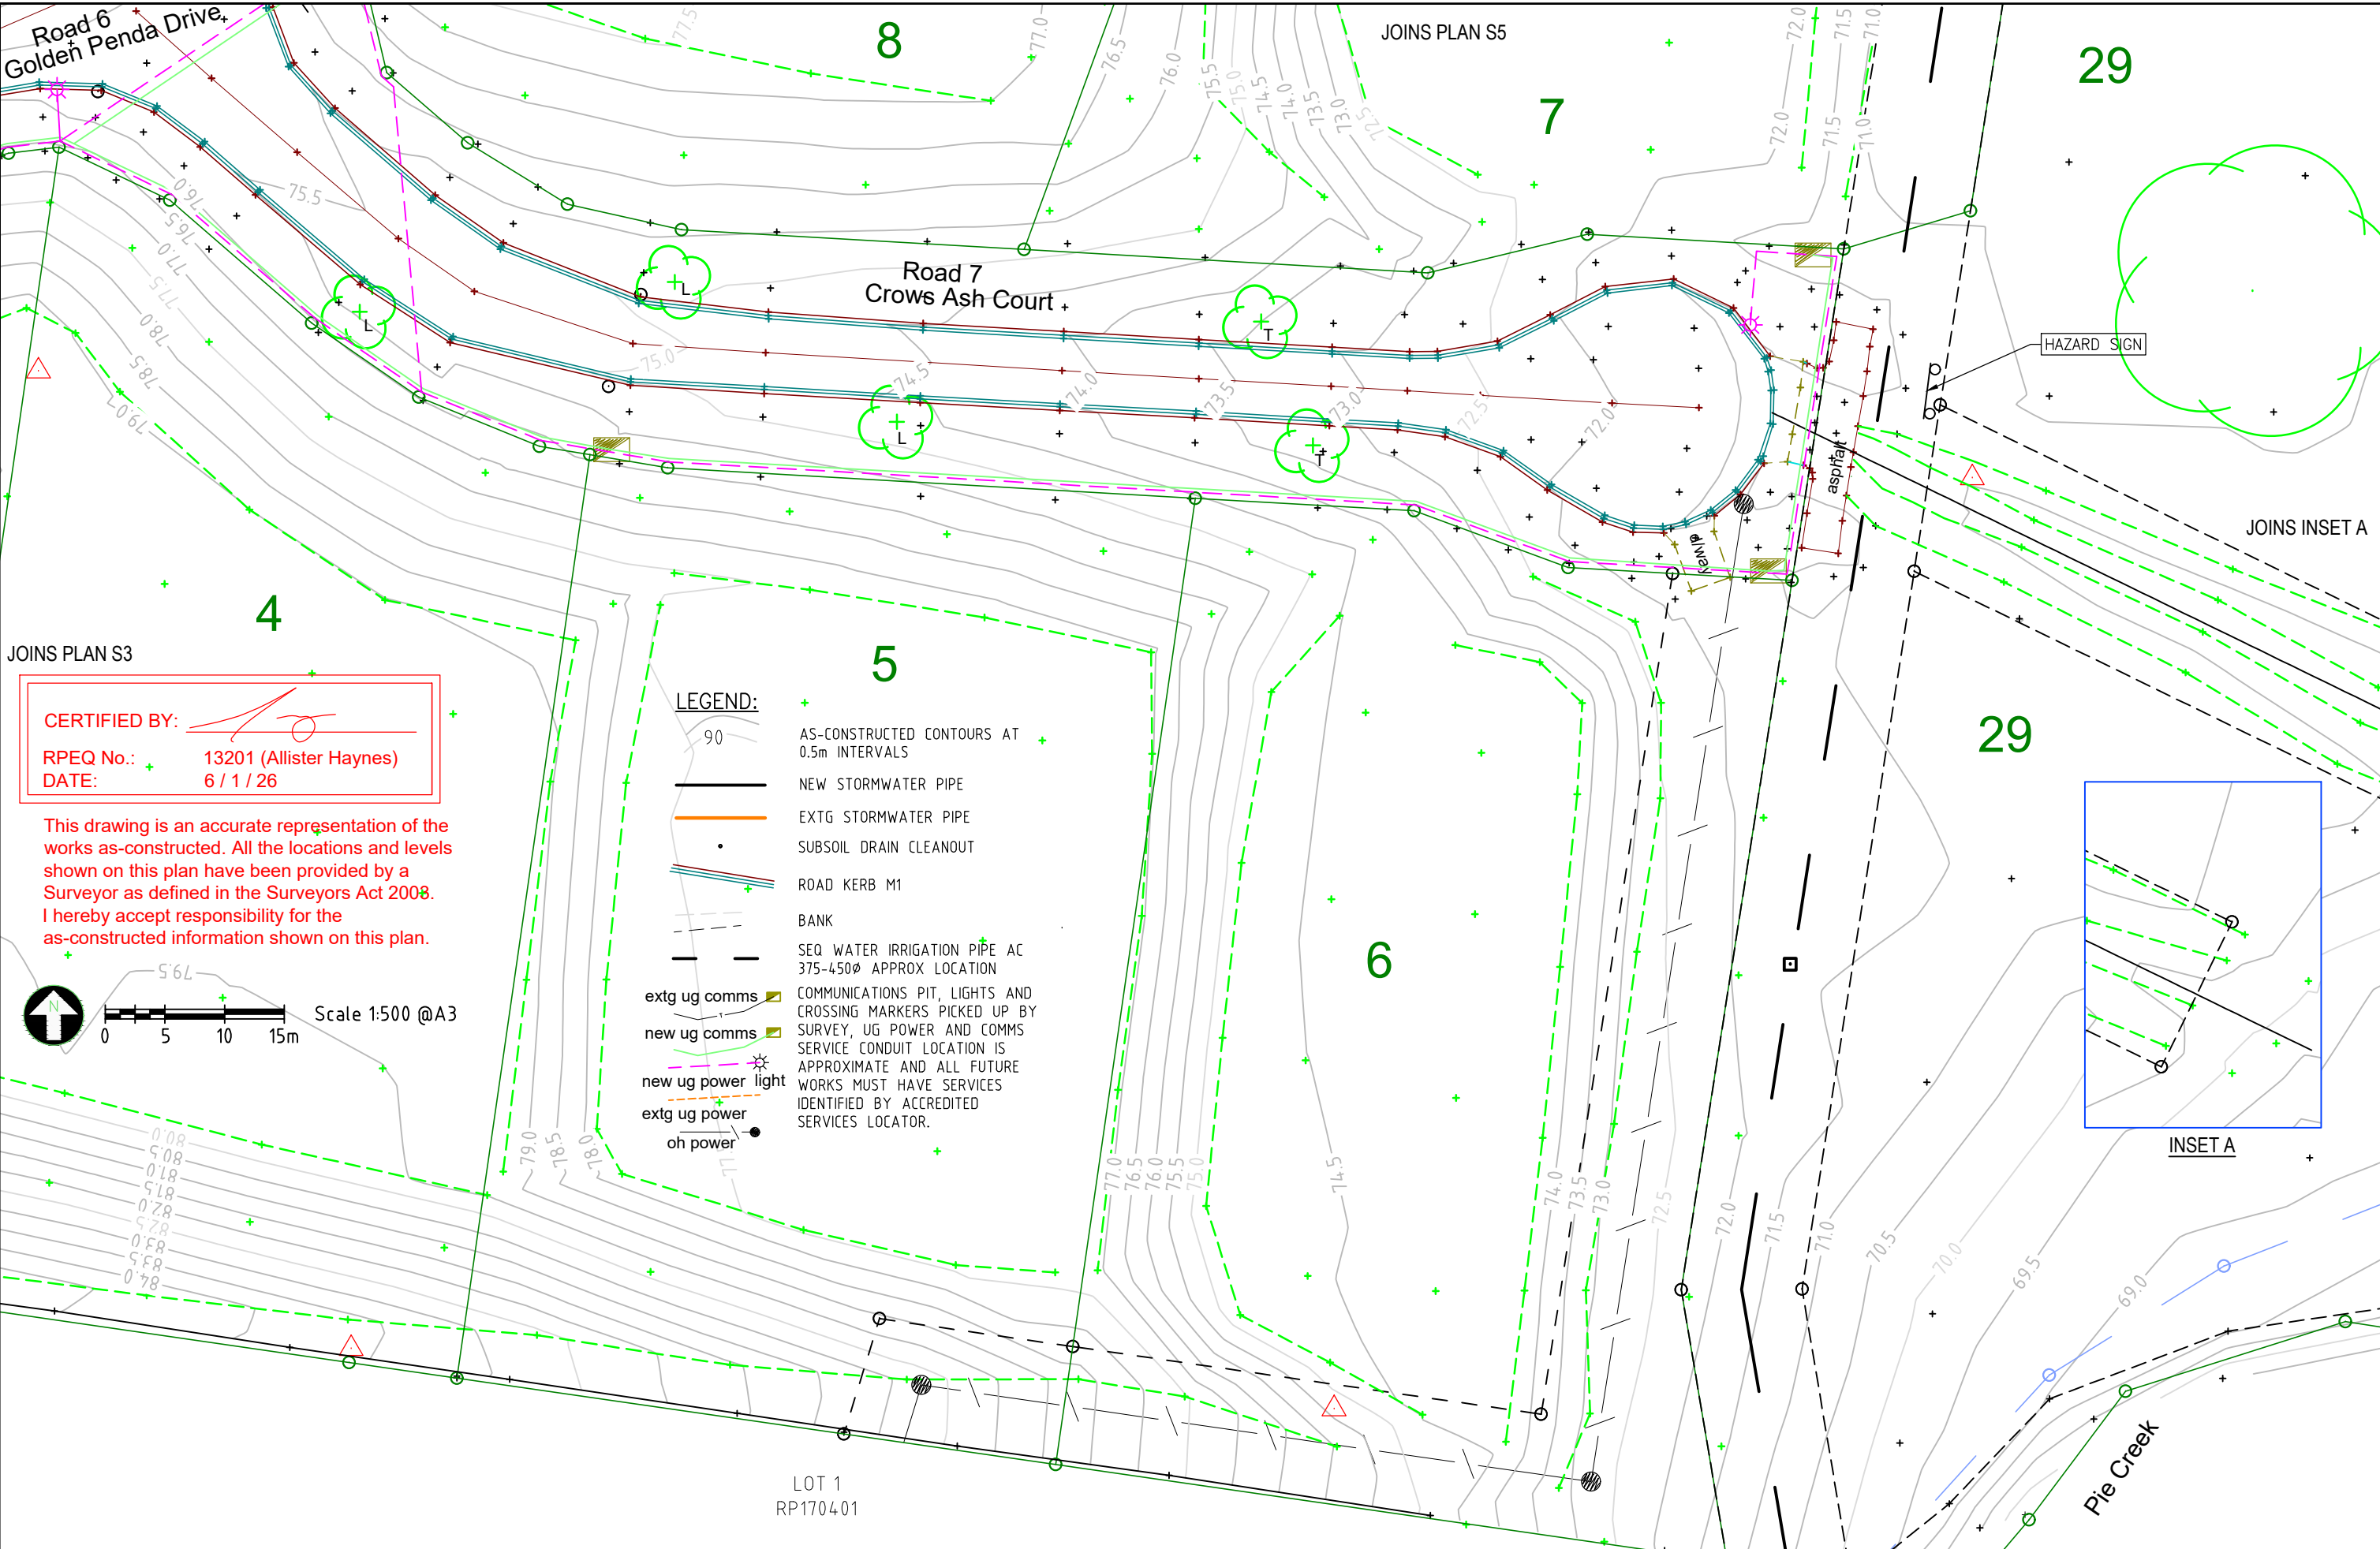


**CERTIFIED BY:**   
**RPEQ No.:** 13201 (Allister Haynes)  
**DATE:** 6 / 1 / 26

This drawing is an accurate representation of the works as-constructed. All the locations and levels shown on this plan have been provided by a Surveyor as defined in the Surveyors Act 2008. I hereby accept responsibility for the as-constructed information shown on this plan.

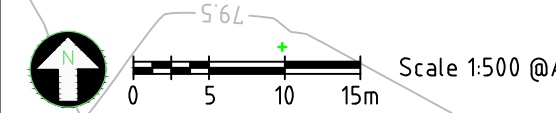


|    |    |         |                |       |             |                         |                                                                                       |                                                                                                        |                                                                                                                                                                    |                                                     |
|----|----|---------|----------------|-------|-------------|-------------------------|---------------------------------------------------------------------------------------|--------------------------------------------------------------------------------------------------------|--------------------------------------------------------------------------------------------------------------------------------------------------------------------|-----------------------------------------------------|
| A3 | 0  | 30-7-26 | AS CONSTRUCTED | SLH   | PSM/(AHD)RL | PM197247/(74.829) GDA20 |  | HAYNES CONSULTING ENGINEERS<br>ABN 53 613 630 078<br>PO BOX 549 NOOSA HEADS QLD 4567<br>(0432) 784 150 | GREENDALE ESTATE STAGE 7<br>OPW2024-3802 REC2010-0539 Lots 1-29 on SP363889, 95 Mooloo Road, Pie Creek, for Roberts Bros Pty Ltd<br>AS CONSTRUCTED ADAC SW LAYOUTS | 1803S7 AC<br>Sheet No. - Revision No.<br>S4 of 12 0 |
|    |    |         |                |       | SURVEYED    | MURRAY AND ASSOCIATES   |                                                                                       |                                                                                                        |                                                                                                                                                                    |                                                     |
|    |    |         |                |       | RPEQ NO.    | 13201                   |                                                                                       |                                                                                                        |                                                                                                                                                                    |                                                     |
|    |    |         |                |       | RPEQ NAME   | ALLISTER HAYNES         |                                                                                       |                                                                                                        |                                                                                                                                                                    |                                                     |
|    | Rv | DATE    | REVISIONS      | APPR. |             |                         |                                                                                       |                                                                                                        |                                                                                                                                                                    |                                                     |

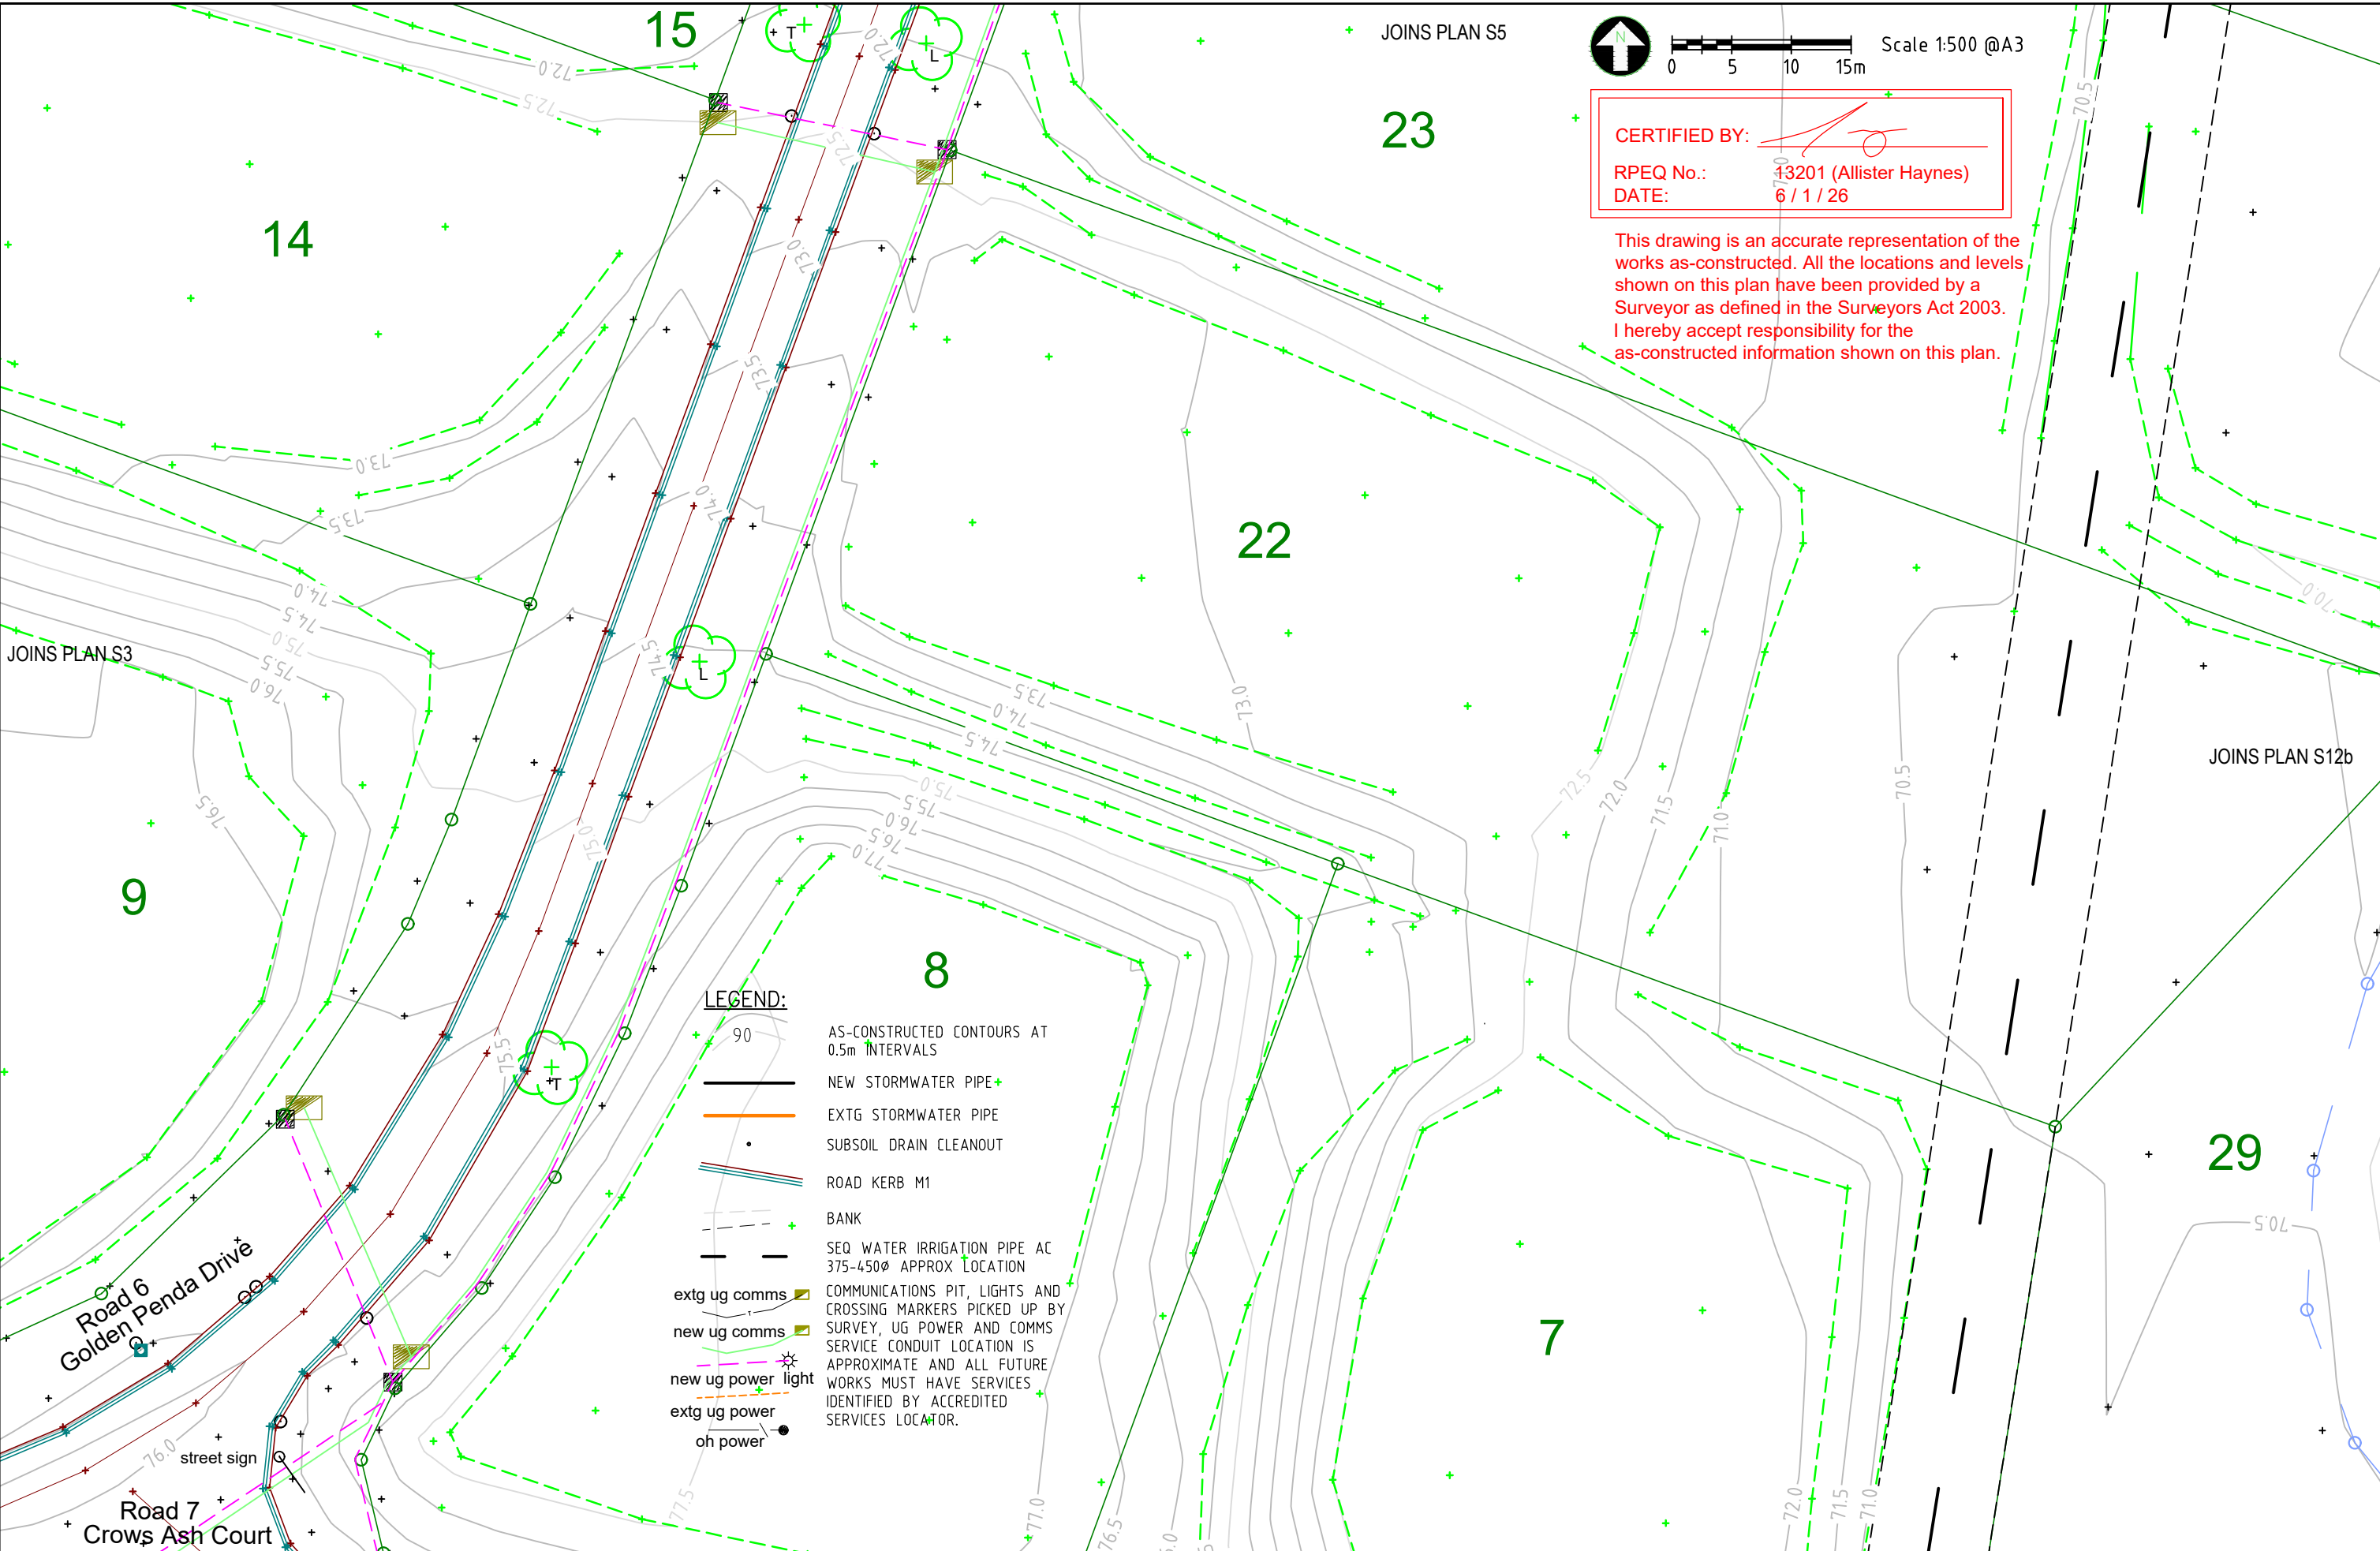


|    |    |         |                |       |             |                         |                                                                                                                                      |                                                                                                        |                                                                                                                                                                       |                          |
|----|----|---------|----------------|-------|-------------|-------------------------|--------------------------------------------------------------------------------------------------------------------------------------|--------------------------------------------------------------------------------------------------------|-----------------------------------------------------------------------------------------------------------------------------------------------------------------------|--------------------------|
| A3 |    |         |                |       | PSM/(AHD)RL | PM197247/(74.829) GDA20 |  <div>HAYNES<br/>CONSULTING<br/>ENGINEERS</div> | HAYNES CONSULTING ENGINEERS<br>ABN 53 613 630 078<br>PO BOX 549 NOOSA HEADS QLD 4567<br>(0432) 784 150 | GREENDALE ESTATE STAGE 7<br>OPW2024-3802 REC2010-0539 Lots 1-29 on SP363889, 95<br>Mooloo Road, Pie Creek, for Roberts Bros Pty Ltd<br>AS CONSTRUCTED ADAC SW LAYOUTS | 1803S7 AC                |
|    | 0  | 30-7-26 | AS CONSTRUCTED | SLH   | SURVEYED    | MURRAY AND ASSOCIATES   |                                                                                                                                      |                                                                                                        |                                                                                                                                                                       | Sheet No. - Revision No. |
|    | Rv | DATE    | REVISIONS      | APPR. | RPEQ NO.    | 13201                   |                                                                                                                                      |                                                                                                        |                                                                                                                                                                       |                          |
|    |    |         |                |       | RPEQ NAME   | ALLISTER HAYNES         |                                                                                                                                      |                                                                                                        |                                                                                                                                                                       |                          |
|    |    |         |                |       |             |                         |                                                                                                                                      |                                                                                                        |                                                                                                                                                                       |                          |



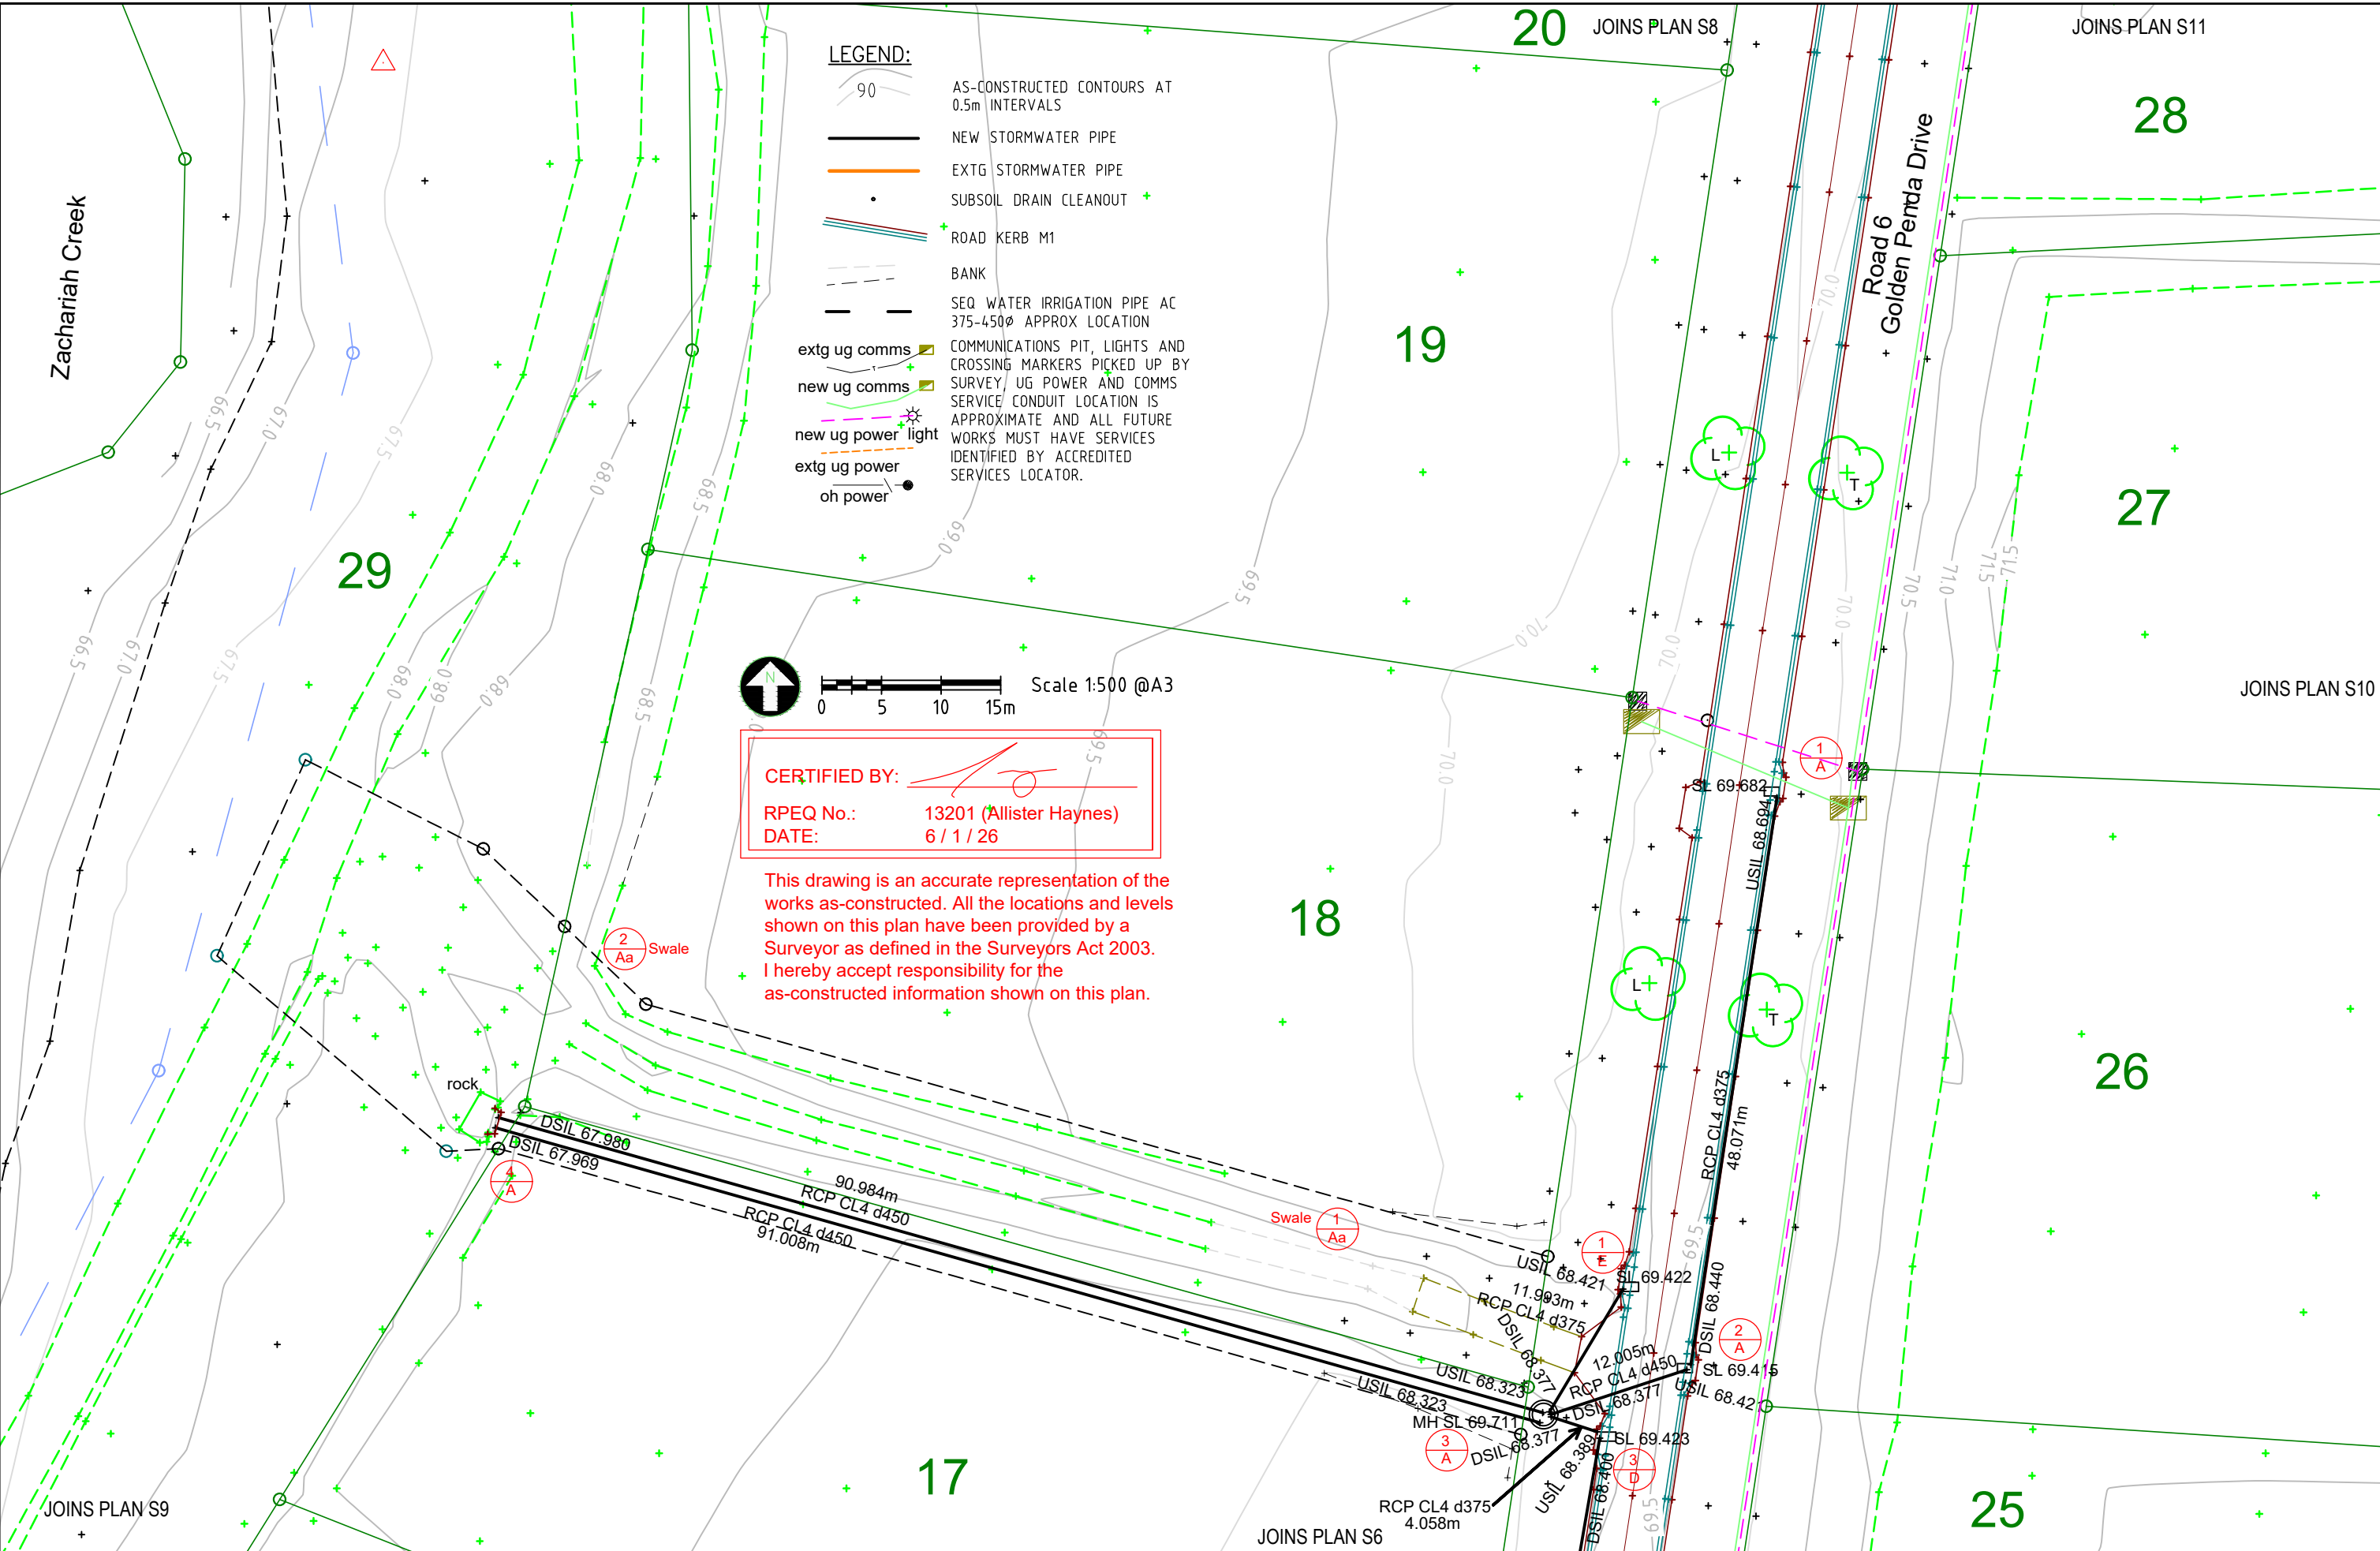

|    |    |         |                |       |             |                         |                                                                                                                                      |                                                                                                        |                                                                                                                                                                              |                          |
|----|----|---------|----------------|-------|-------------|-------------------------|--------------------------------------------------------------------------------------------------------------------------------------|--------------------------------------------------------------------------------------------------------|------------------------------------------------------------------------------------------------------------------------------------------------------------------------------|--------------------------|
| A3 |    |         |                |       | PSM/(AHD)RL | PM197247/(74.829) GDA20 |  <div>HAYNES<br/>CONSULTING<br/>ENGINEERS</div> | HAYNES CONSULTING ENGINEERS<br>ABN 53 613 630 078<br>PO BOX 549 NOOSA HEADS QLD 4567<br>(0432) 784 150 | <b>GREENDALE ESTATE STAGE 7</b><br>OPW2024-3802 REC2010-0539 Lots 1-29 on SP363889, 95<br>Mooloo Road, Pie Creek, for Roberts Bros Pty Ltd<br>AS CONSTRUCTED ADAC SW LAYOUTS | 1803S7 AC                |
|    | 0  | 30-7-26 | AS CONSTRUCTED | SLH   | SURVEYED    | MURRAY AND ASSOCIATES   |                                                                                                                                      |                                                                                                        |                                                                                                                                                                              | Sheet No. - Revision No. |
|    |    |         |                |       | RPEQ NO.    | 13201                   |                                                                                                                                      |                                                                                                        |                                                                                                                                                                              |                          |
|    |    |         |                |       | RPEQ NAME   | ALLISTER HAYNES         |                                                                                                                                      |                                                                                                        |                                                                                                                                                                              |                          |
|    | Rv | DATE    | REVISIONS      | APPR. |             |                         |                                                                                                                                      |                                                                                                        |                                                                                                                                                                              | S7 of 12 0               |

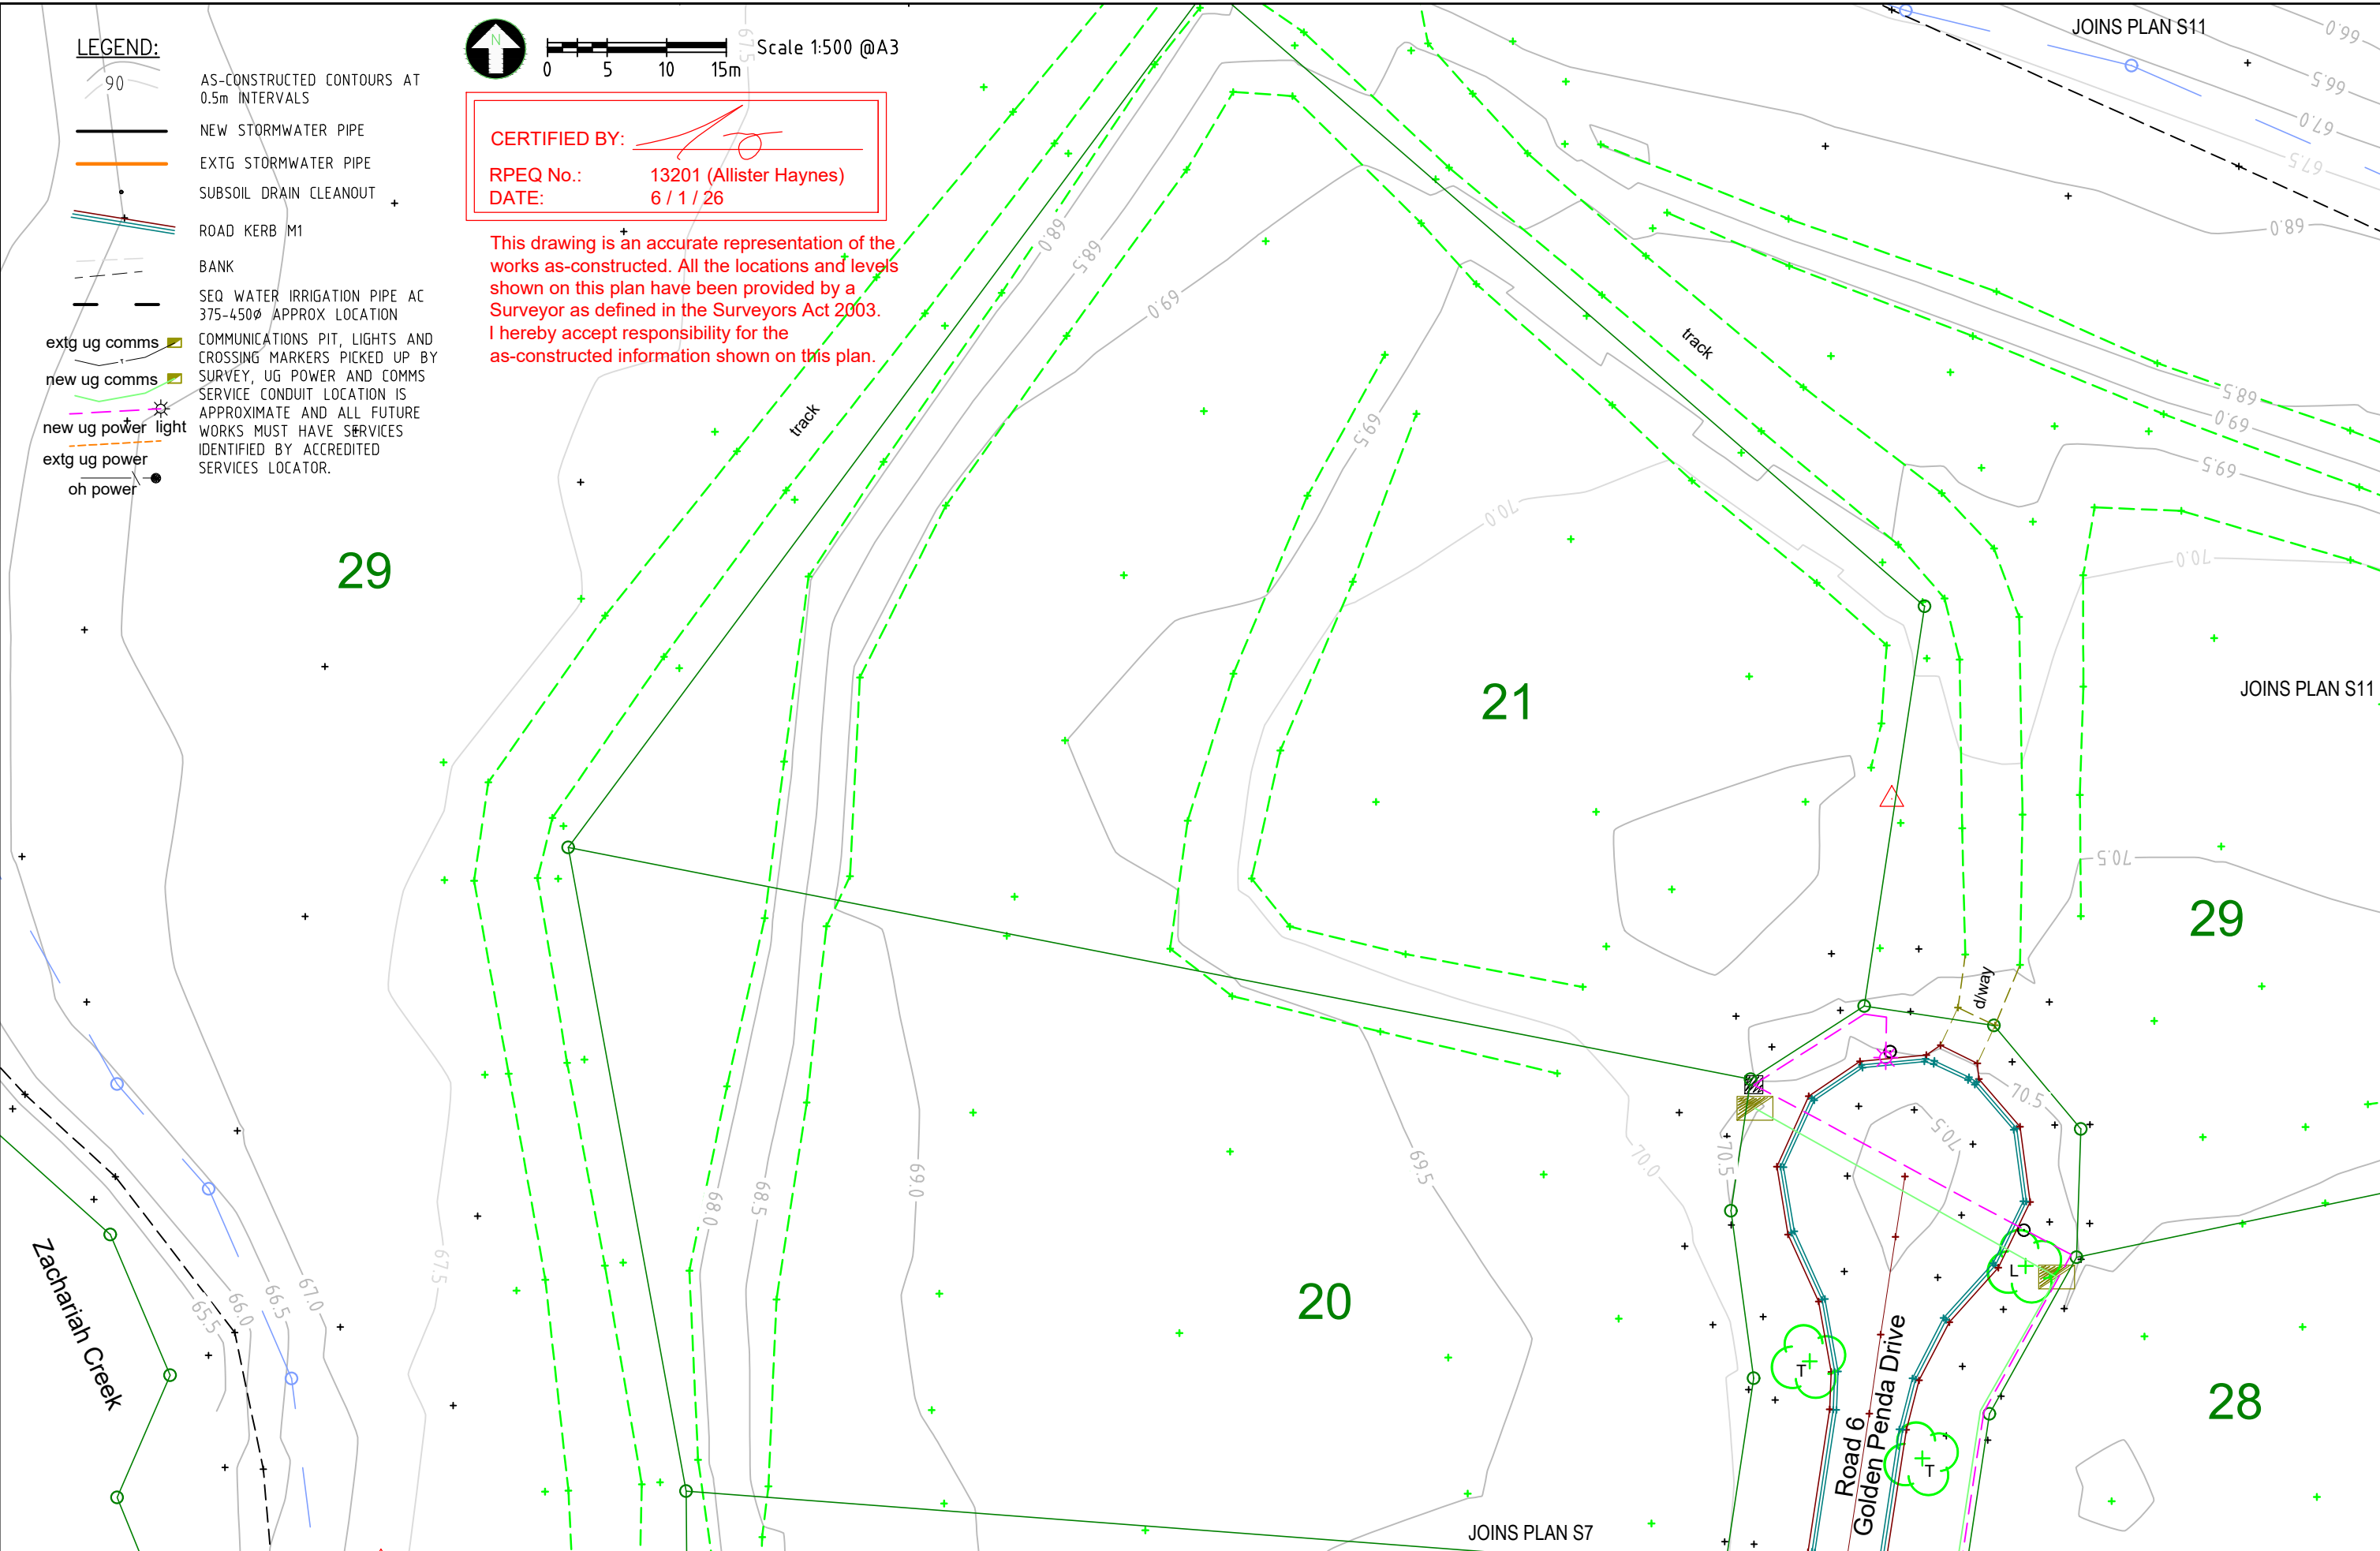

|    |      |           |         |                |     |             |                         |                                                                      |                                                                                                        |                                                                                                                                                                       |                          |
|----|------|-----------|---------|----------------|-----|-------------|-------------------------|----------------------------------------------------------------------|--------------------------------------------------------------------------------------------------------|-----------------------------------------------------------------------------------------------------------------------------------------------------------------------|--------------------------|
| A3 |      | 0         | 30-7-26 | AS CONSTRUCTED | SLH | PSM/(AHD)RL | PM197247/(74.829) GDA20 | <div><div></div><div>HAYNES<br/>CONSULTING<br/>ENGINEERS</div></div> | HAYNES CONSULTING ENGINEERS<br>ABN 53 613 630 078<br>PO BOX 549 NOOSA HEADS QLD 4567<br>(0432) 784 150 | GREENDALE ESTATE STAGE 7<br>OPW2024-3802 REC2010-0539 Lots 1-29 on SP363889, 95<br>Mooloo Road, Pie Creek, for Roberts Bros Pty Ltd<br>AS CONSTRUCTED ADAC SW LAYOUTS | 1803S7 AC                |
|    |      |           |         |                |     | SURVEYED    | MURRAY AND ASSOCIATES   |                                                                      |                                                                                                        |                                                                                                                                                                       |                          |
| Rv | DATE | REVISIONS | APPR.   |                |     | RPEQ NO.    | 13201                   |                                                                      |                                                                                                        |                                                                                                                                                                       | Sheet No. - Revision No. |
|    |      |           |         |                |     | RPEQ NAME   | ALLISTER HAYNES         |                                                                      |                                                                                                        |                                                                                                                                                                       |                          |

LEGEND:

- 90 AS-CONSTRUCTED CONTOURS AT 0.5m INTERVALS
- NEW STORMWATER PIPE
- EXTG STORMWATER PIPE
- SUBSOIL DRAIN CLEANOUT
- ROAD KERB M1
- BANK
- SEQ WATER IRRIGATION PIPE AC 375-450ø APPROX LOCATION
- extg ug comms
- new ug comms
- new ug power light
- extg ug power
- oh power
- COMMUNICATIONS PIT, LIGHTS AND CROSSING MARKERS PICKED UP BY SURVEY, UG POWER AND COMMS SERVICE CONDUIT LOCATION IS APPROXIMATE AND ALL FUTURE WORKS MUST HAVE SERVICES IDENTIFIED BY ACCREDITED SERVICES LOCATOR.




0 5 10 15m

Scale 1:500 @A3

CERTIFIED BY:

RPEQ No.: 13201 (Allister Haynes)  
DATE: 6 / 1 / 26

This drawing is an accurate representation of the works as-constructed. All the locations and levels shown on this plan have been provided by a Surveyor as defined in the Surveyors Act 2003. I hereby accept responsibility for the as-constructed information shown on this plan.

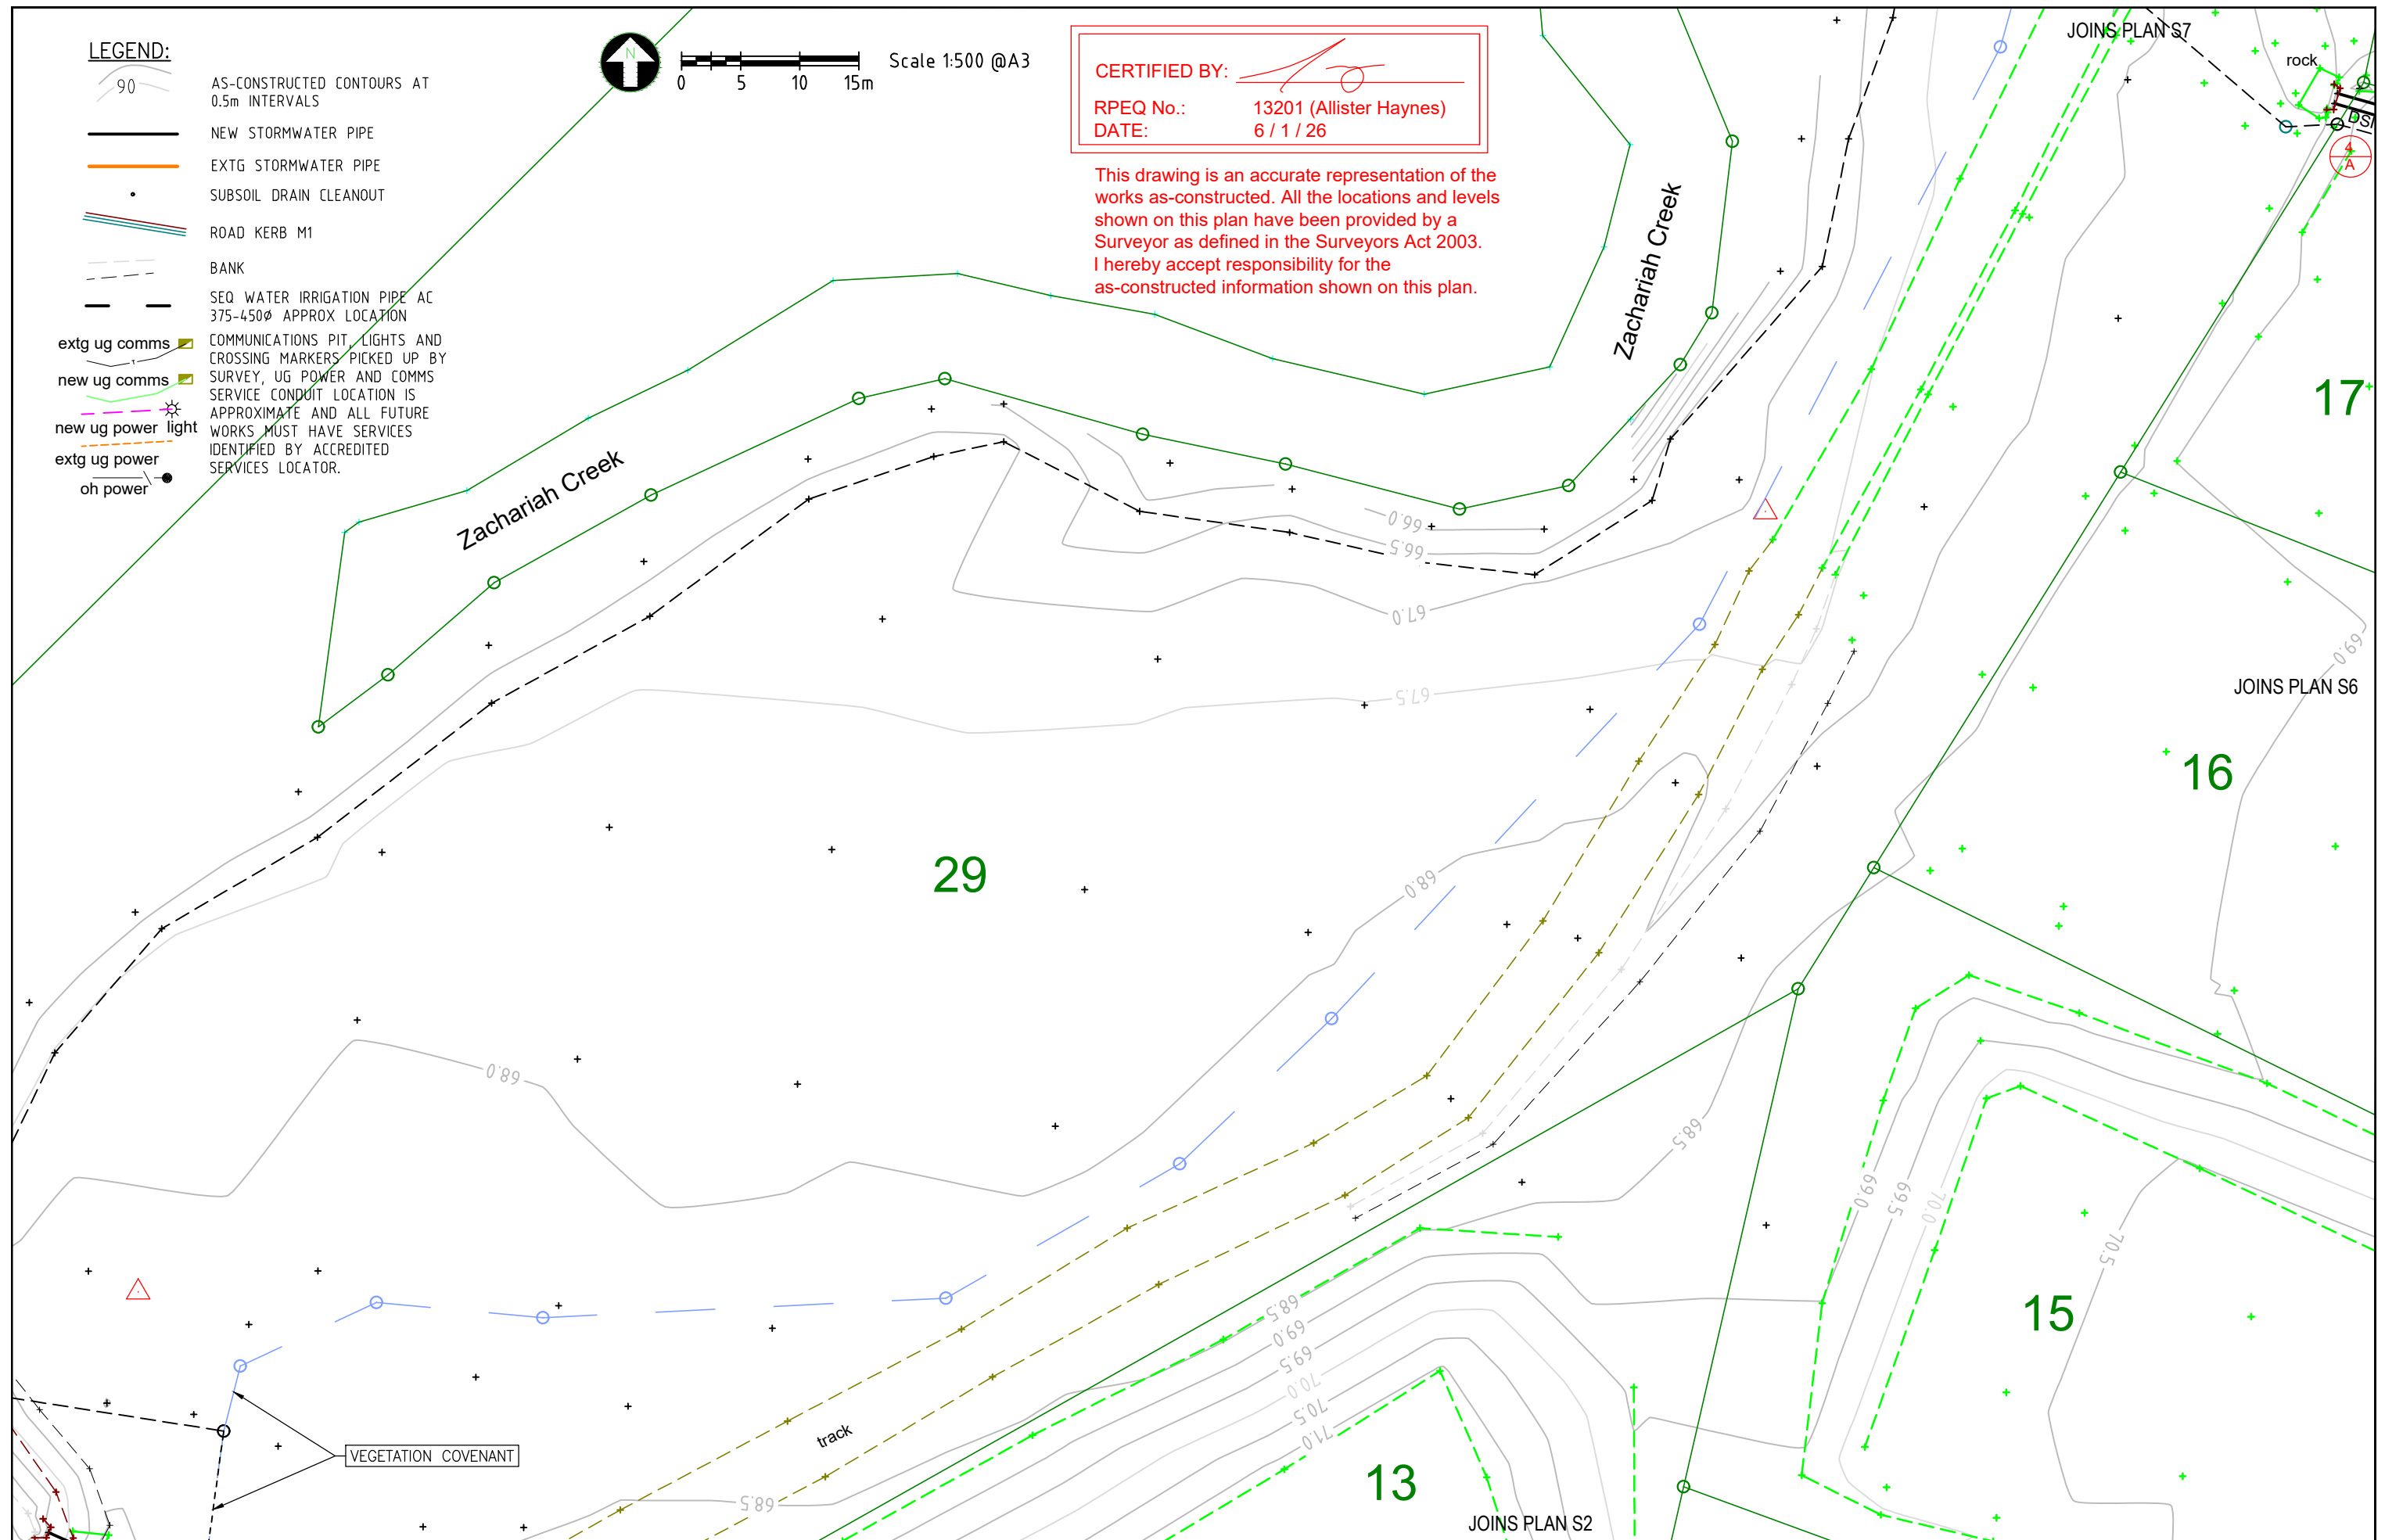

A3

0 30-7-26 AS CONSTRUCTED SLH  
Rv DATE REVISIONS APPR.


PSM/(AHD)RL PM197247/(74.829) GDA20  
SURVEYED MURRAY AND ASSOCIATES  
RPEQ NO. 13201  
RPEQ NAME ALLISTER HAYNES

**HC HAYNES CONSULTING ENGINEERS**


HAYNES CONSULTING ENGINEERS  
ABN 53 613 630 078  
PO BOX 549 NOOSA HEADS QLD 4567  
(0432) 784 150

**GREENDALE ESTATE STAGE 7**  
OPW2024-3802 REC2010-0539 Lots 1-29 on SP363889, 95  
Mooloo Road, Pie Creek, for Roberts Bros Pty Ltd  
**AS CONSTRUCTED ADAC SW LAYOUTS**

**1803S7 AC**  
Sheet No. - Revision No.  
**S9 of 12 0**

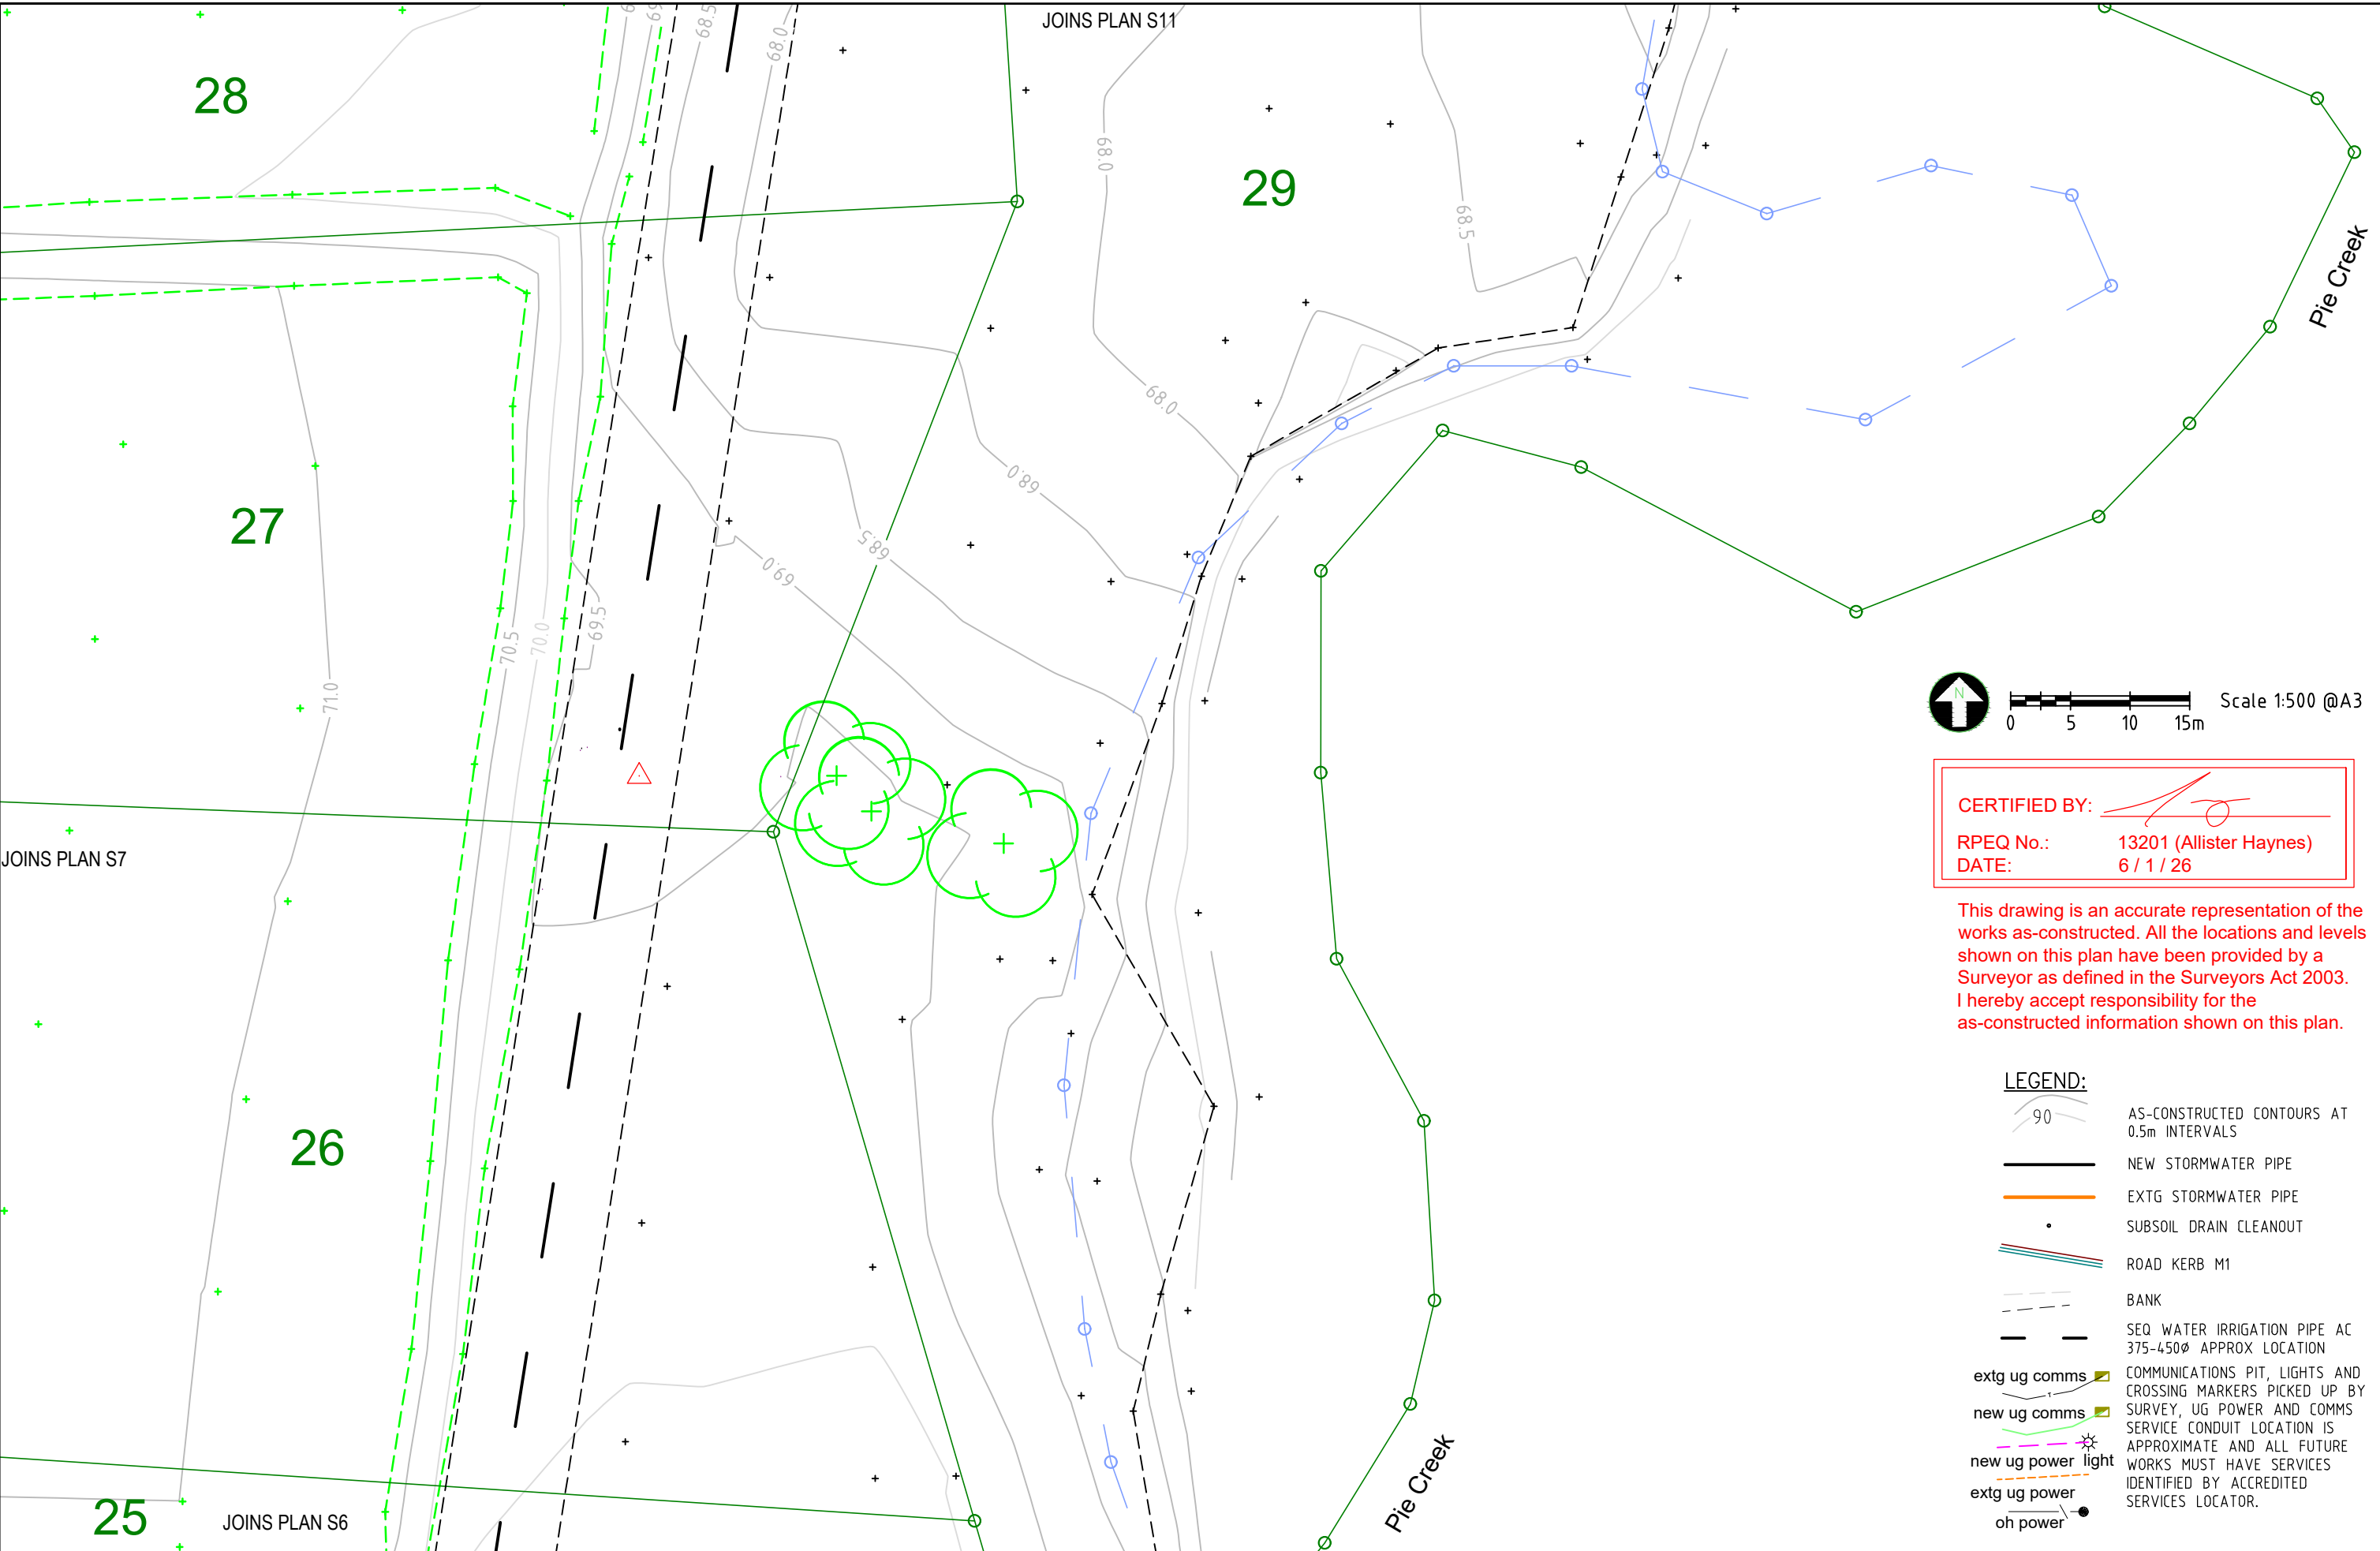

Scale 1:500 @A3

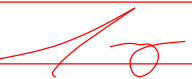
CERTIFIED BY:   
RPEQ No.: 13201 (Allister Haynes)  
DATE: 6 / 1 / 26


This drawing is an accurate representation of the works as-constructed. All the locations and levels shown on this plan have been provided by a Surveyor as defined in the Surveyors Act 2003. I hereby accept responsibility for the as-constructed information shown on this plan.

- LEGEND:**
- AS-CONSTRUCTED CONTOURS AT 0.5m INTERVALS
  - NEW STORMWATER PIPE
  - EXTG STORMWATER PIPE
  - SUBSOIL DRAIN CLEANOUT
  - ROAD KERB M1
  - BANK
  - SEQ WATER IRRIGATION PIPE AC 375-450Ø APPROX LOCATION
  - extg ug comms
  - new ug comms
  - new ug power light
  - extg ug power
  - oh power

|    |      |           |                |     |             |                         |                                                                                       |                                                                                                        |                                                                                                                                                                       |                          |
|----|------|-----------|----------------|-----|-------------|-------------------------|---------------------------------------------------------------------------------------|--------------------------------------------------------------------------------------------------------|-----------------------------------------------------------------------------------------------------------------------------------------------------------------------|--------------------------|
| A3 | 0    | 30-7-26   | AS CONSTRUCTED | SLH | PSM/(AHD)RL | PM197247/(74.829) GDA20 |  | HAYNES CONSULTING ENGINEERS<br>ABN 53 613 630 078<br>PO BOX 549 NOOSA HEADS QLD 4567<br>(0432) 784 150 | GREENDALE ESTATE STAGE 7<br>OPW2024-3802 REC2010-0539 Lots 1-29 on SP363889, 95<br>Mooloo Road, Pie Creek, for Roberts Bros Pty Ltd<br>AS CONSTRUCTED ADAC SW LAYOUTS | 1803S7 AC                |
|    |      |           |                |     | SURVEYED    | MURRAY AND ASSOCIATES   |                                                                                       |                                                                                                        |                                                                                                                                                                       |                          |
| Rv | DATE | REVISIONS | APPR.          |     | RPEQ NO.    | 13201                   |                                                                                       |                                                                                                        |                                                                                                                                                                       | Sheet No. - Revision No. |
|    |      |           |                |     | RPEQ NAME   | ALLISTER HAYNES         |                                                                                       |                                                                                                        |                                                                                                                                                                       |                          |



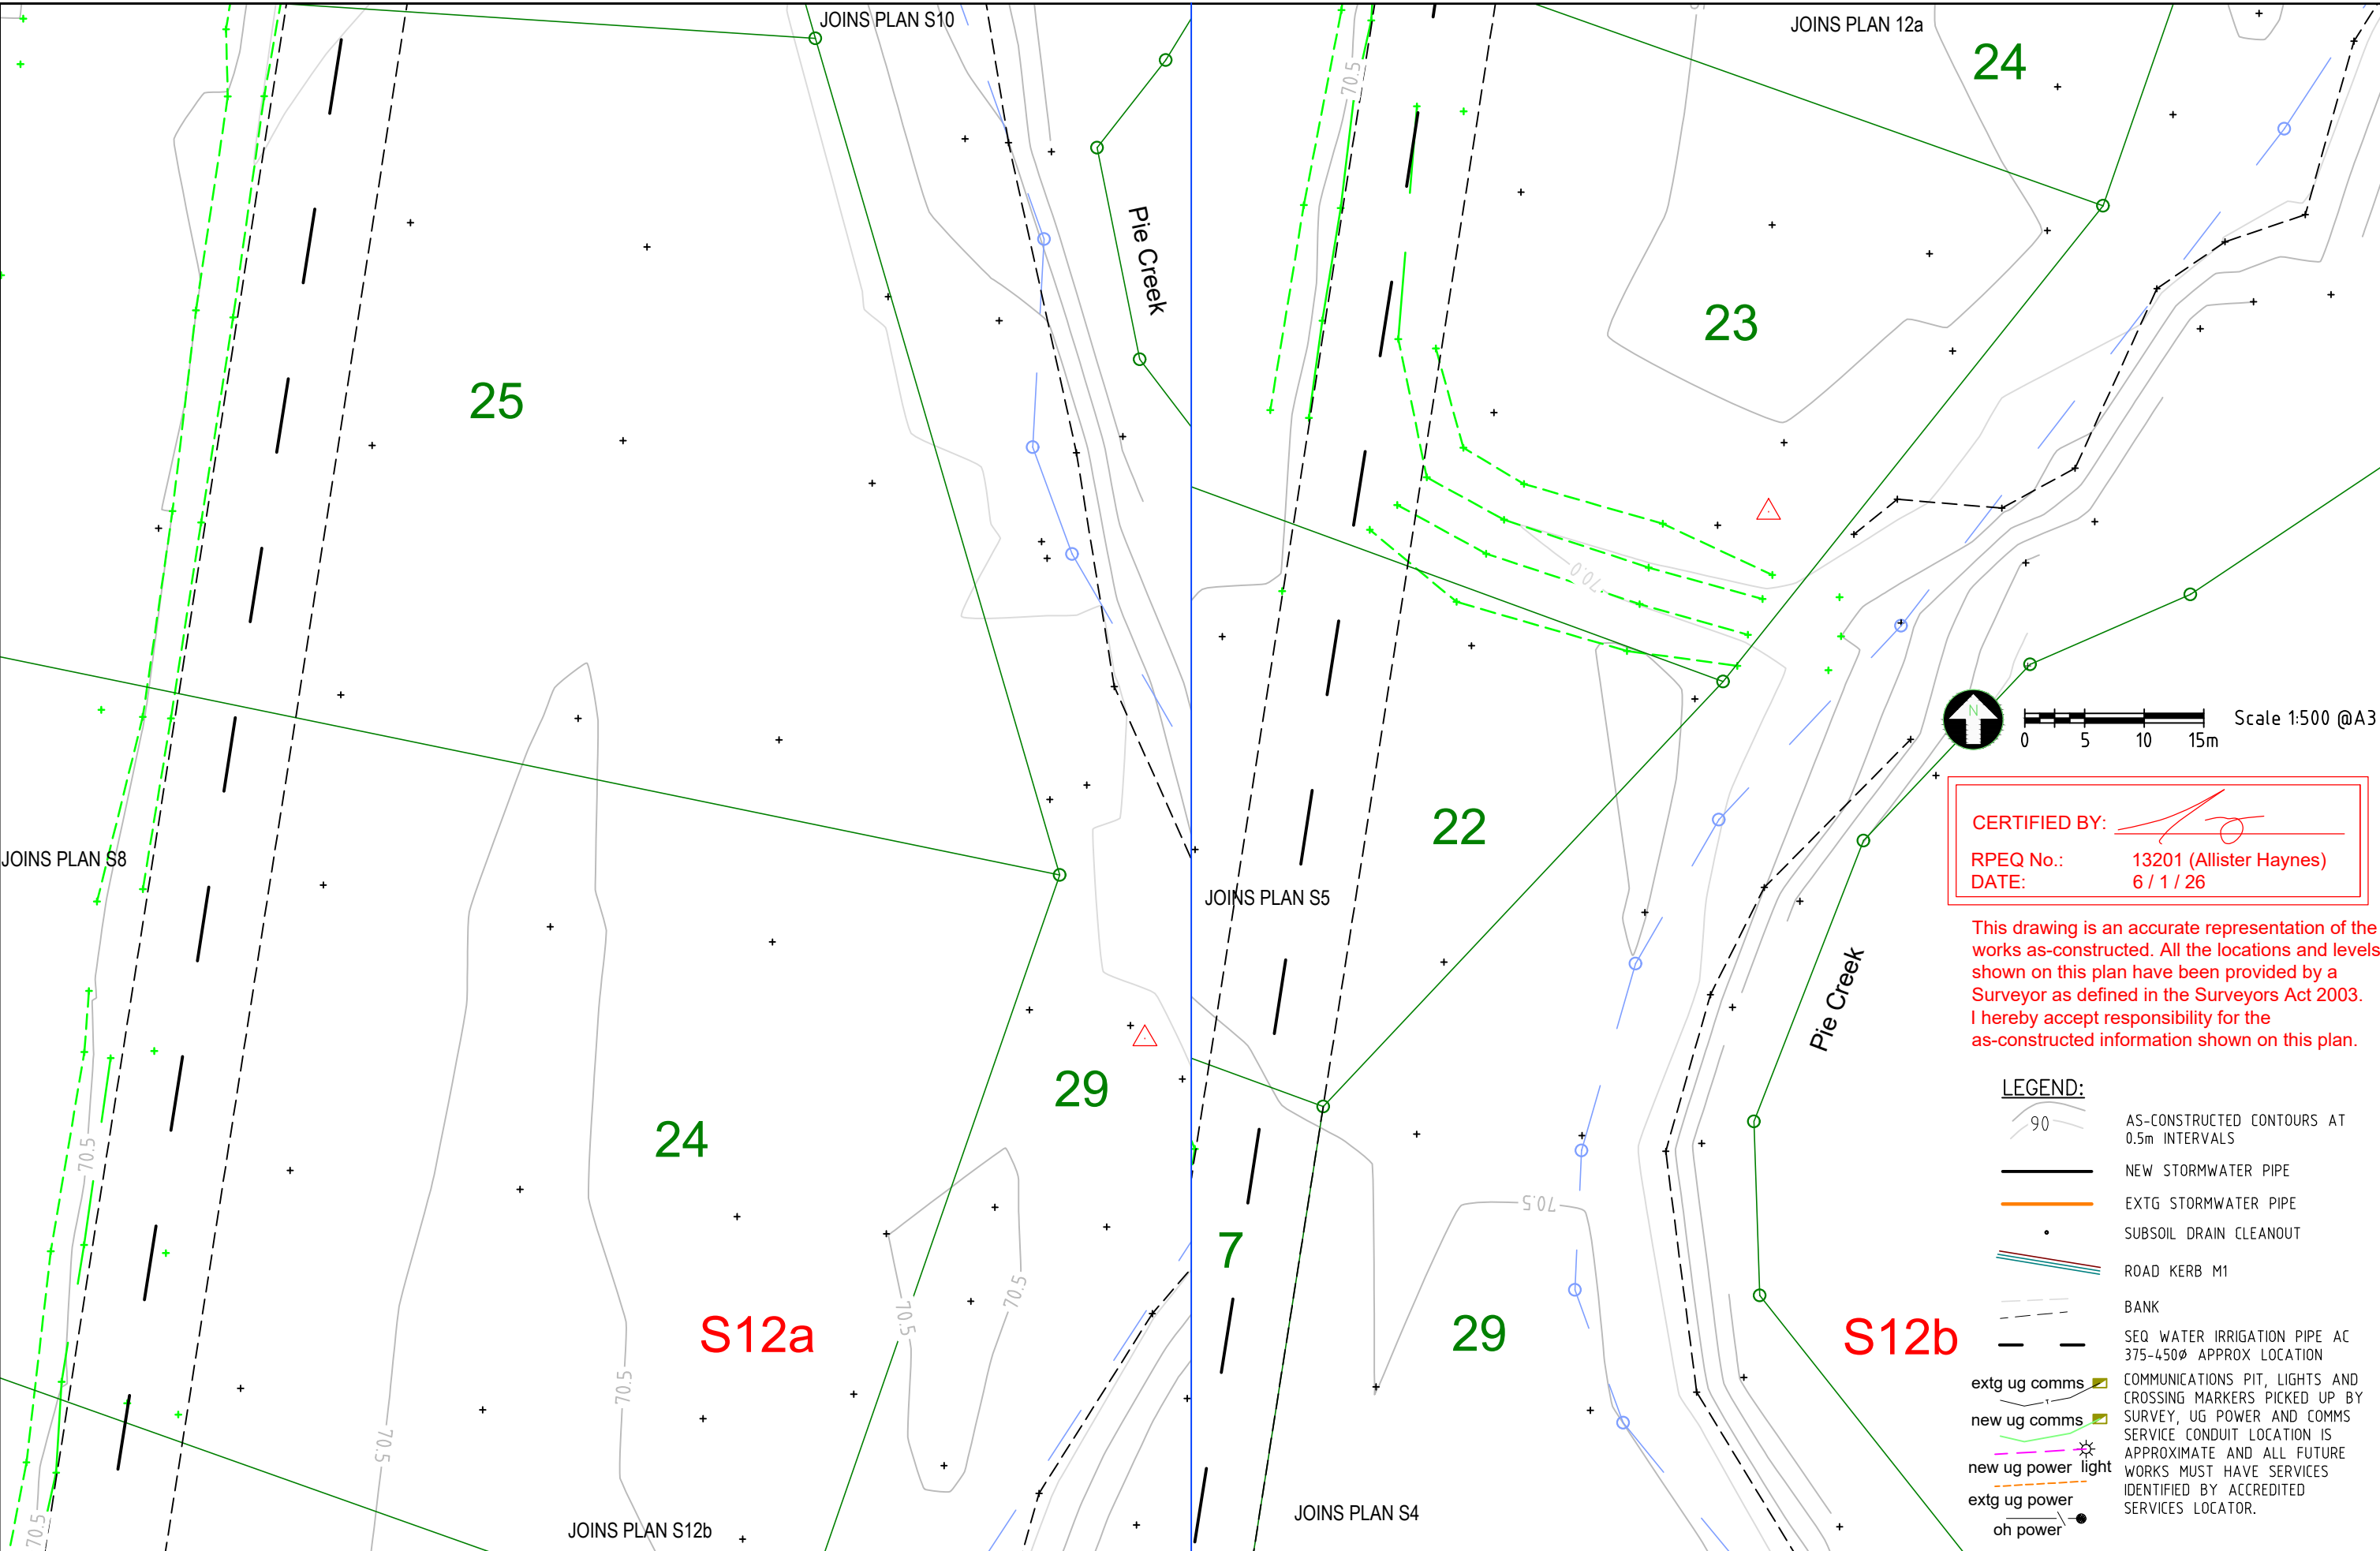

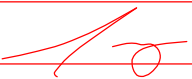CERTIFIED BY:   
RPEQ No.: 13201 (Allister Haynes)  
DATE: 6 / 1 / 26

This drawing is an accurate representation of the works as-constructed. All the locations and levels shown on this plan have been provided by a Surveyor as defined in the Surveyors Act 2003. I hereby accept responsibility for the as-constructed information shown on this plan.

- LEGEND:**
-  90 AS-CONSTRUCTED CONTOURS AT 0.5m INTERVALS
  -  NEW STORMWATER PIPE
  -  EXTG STORMWATER PIPE
  -  SUBSOIL DRAIN CLEANOUT
  -  ROAD KERB M1
  -  BANK
  -  SEQ WATER IRRIGATION PIPE AC 375-450Ø APPROX LOCATION
  -  extg ug comms COMMUNICATIONS PIT, LIGHTS AND CROSSING MARKERS PICKED UP BY SURVEY, UG POWER AND COMMS SERVICE CONDUIT LOCATION IS APPROXIMATE AND ALL FUTURE WORKS MUST HAVE SERVICES IDENTIFIED BY ACCREDITED SERVICES LOCATOR.
  -  new ug comms
  -  new ug power light
  -  extg ug power
  -  oh power

|    |    |         |                |       |             |                         |                                                                                       |                                                                                                        |                                                                                                                                                                    |                          |
|----|----|---------|----------------|-------|-------------|-------------------------|---------------------------------------------------------------------------------------|--------------------------------------------------------------------------------------------------------|--------------------------------------------------------------------------------------------------------------------------------------------------------------------|--------------------------|
| A3 | 0  | 30-7-26 | AS CONSTRUCTED | SLH   | PSM/(AHD)RL | PM197247/(74.829) GDA20 |  | HAYNES CONSULTING ENGINEERS<br>ABN 53 613 630 078<br>PO BOX 549 NOOSA HEADS QLD 4567<br>(0432) 784 150 | GREENDALE ESTATE STAGE 7<br>OPW2024-3802 REC2010-0539 Lots 1-29 on SP363889, 95 Mooloo Road, Pie Creek, for Roberts Bros Pty Ltd<br>AS CONSTRUCTED ADAC SW LAYOUTS | 1803S7 AC                |
|    |    |         |                |       | SURVEYED    | MURRAY AND ASSOCIATES   |                                                                                       |                                                                                                        |                                                                                                                                                                    |                          |
|    | Rv | DATE    | REVISIONS      | APPR. | RPEQ NO.    | 13201                   |                                                                                       |                                                                                                        |                                                                                                                                                                    | Sheet No. - Revision No. |
|    |    |         |                |       | RPEQ NAME   | ALLISTER HAYNES         |                                                                                       |                                                                                                        |                                                                                                                                                                    |                          |